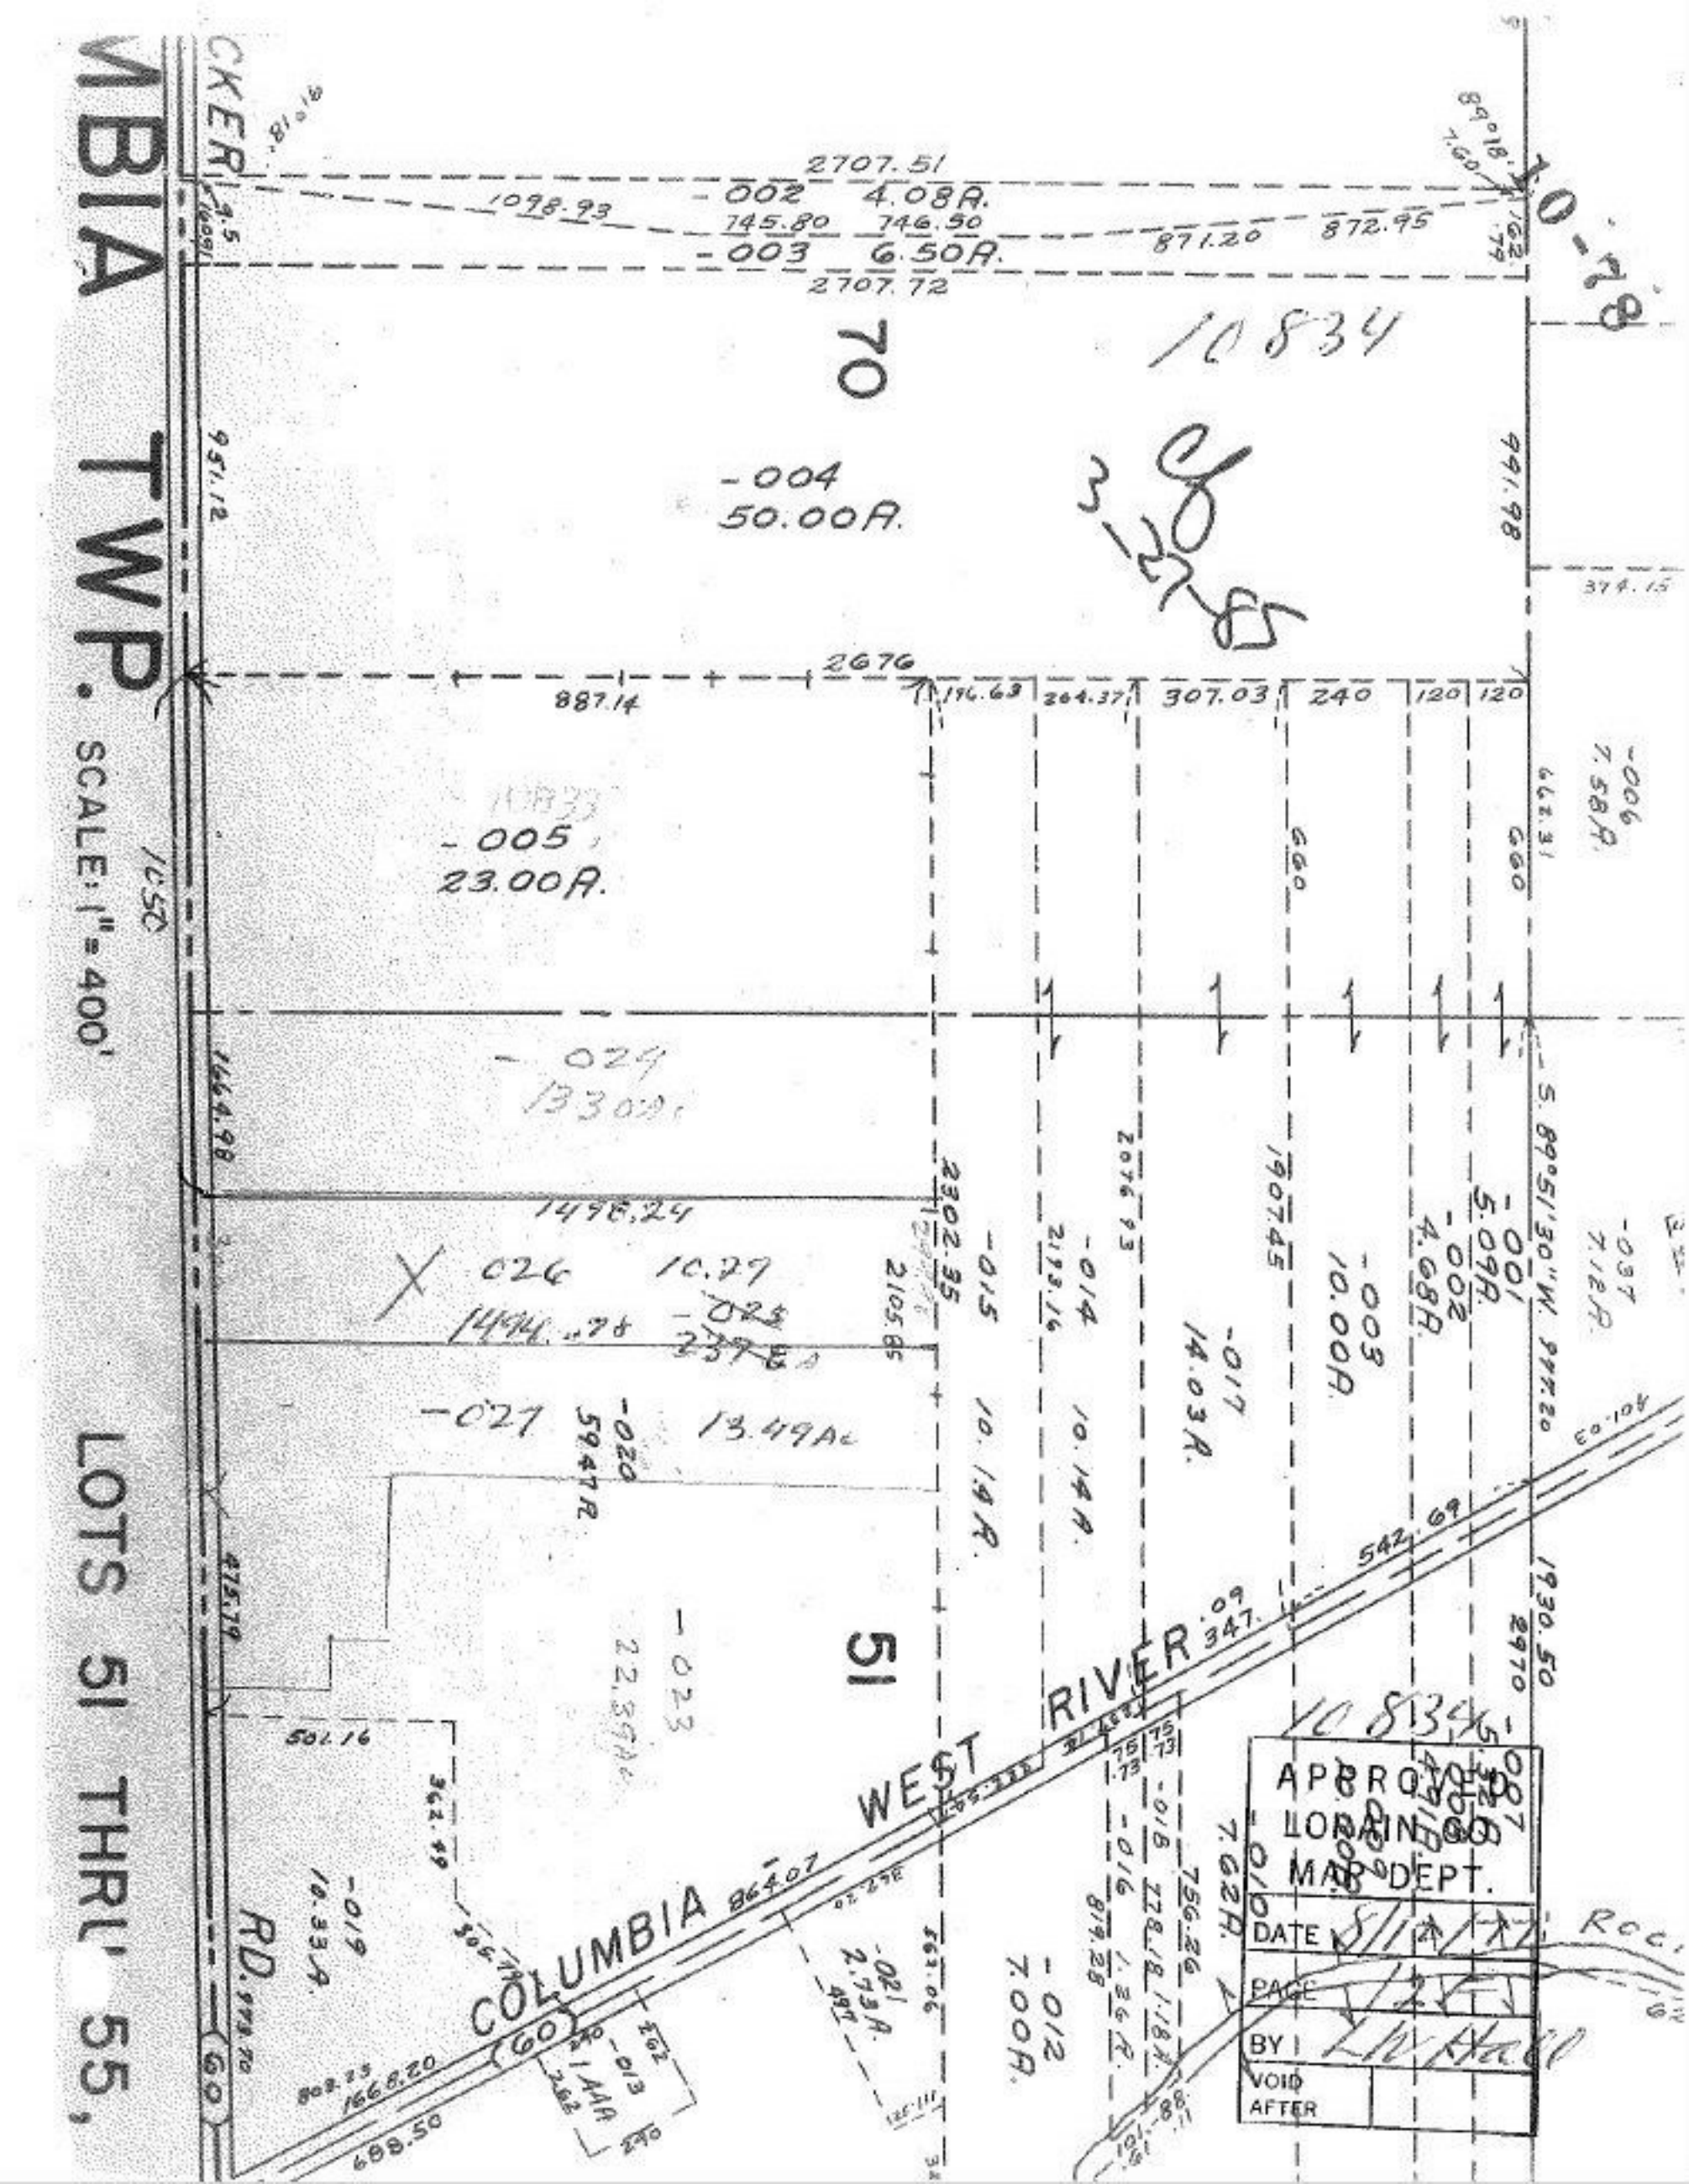

MBIA TWP.
SCALE: 1" = 400'
LOTS 51 THRU' 55,
CKER
2707.51
-002 4.08A.
1098.93
745.80
746.50
-003 6.50A.
871.20
872.95
2707.72
70
10834
-004
50.00A.
951.12
991.98
374.15
2676
887.14
196.63
264.37
307.03
240
120
120
-005
23.00A.
660
660
-006
7.58A.
1050
-029
13.30A.
1664.98
1498.24
-026
10.29
1494.78
-027
13.49A.
-020
59.47A.
2302.35
2105.85
-015
10.14A.
-014
10.14A.
2076.93
-017
14.03A.
1907.45
-003
10.00A.
-002
4.68A.
-001
5.09A.
-037
7.12A.
-023
22.39A.
51
COLUMBIA WEST RIVER
542.69
347.09
1930.50
2970
501.16
362.49
-019
10.33A.
RD.
1668.20
688.50
864.07
-021
2.73A.
-012
7.00A.
-016
-018
-010
7.62A.
-007
APPROVED
LORAIN CO.
MAP DEPT.
DATE
PAGE
BY
VOID
AFTER