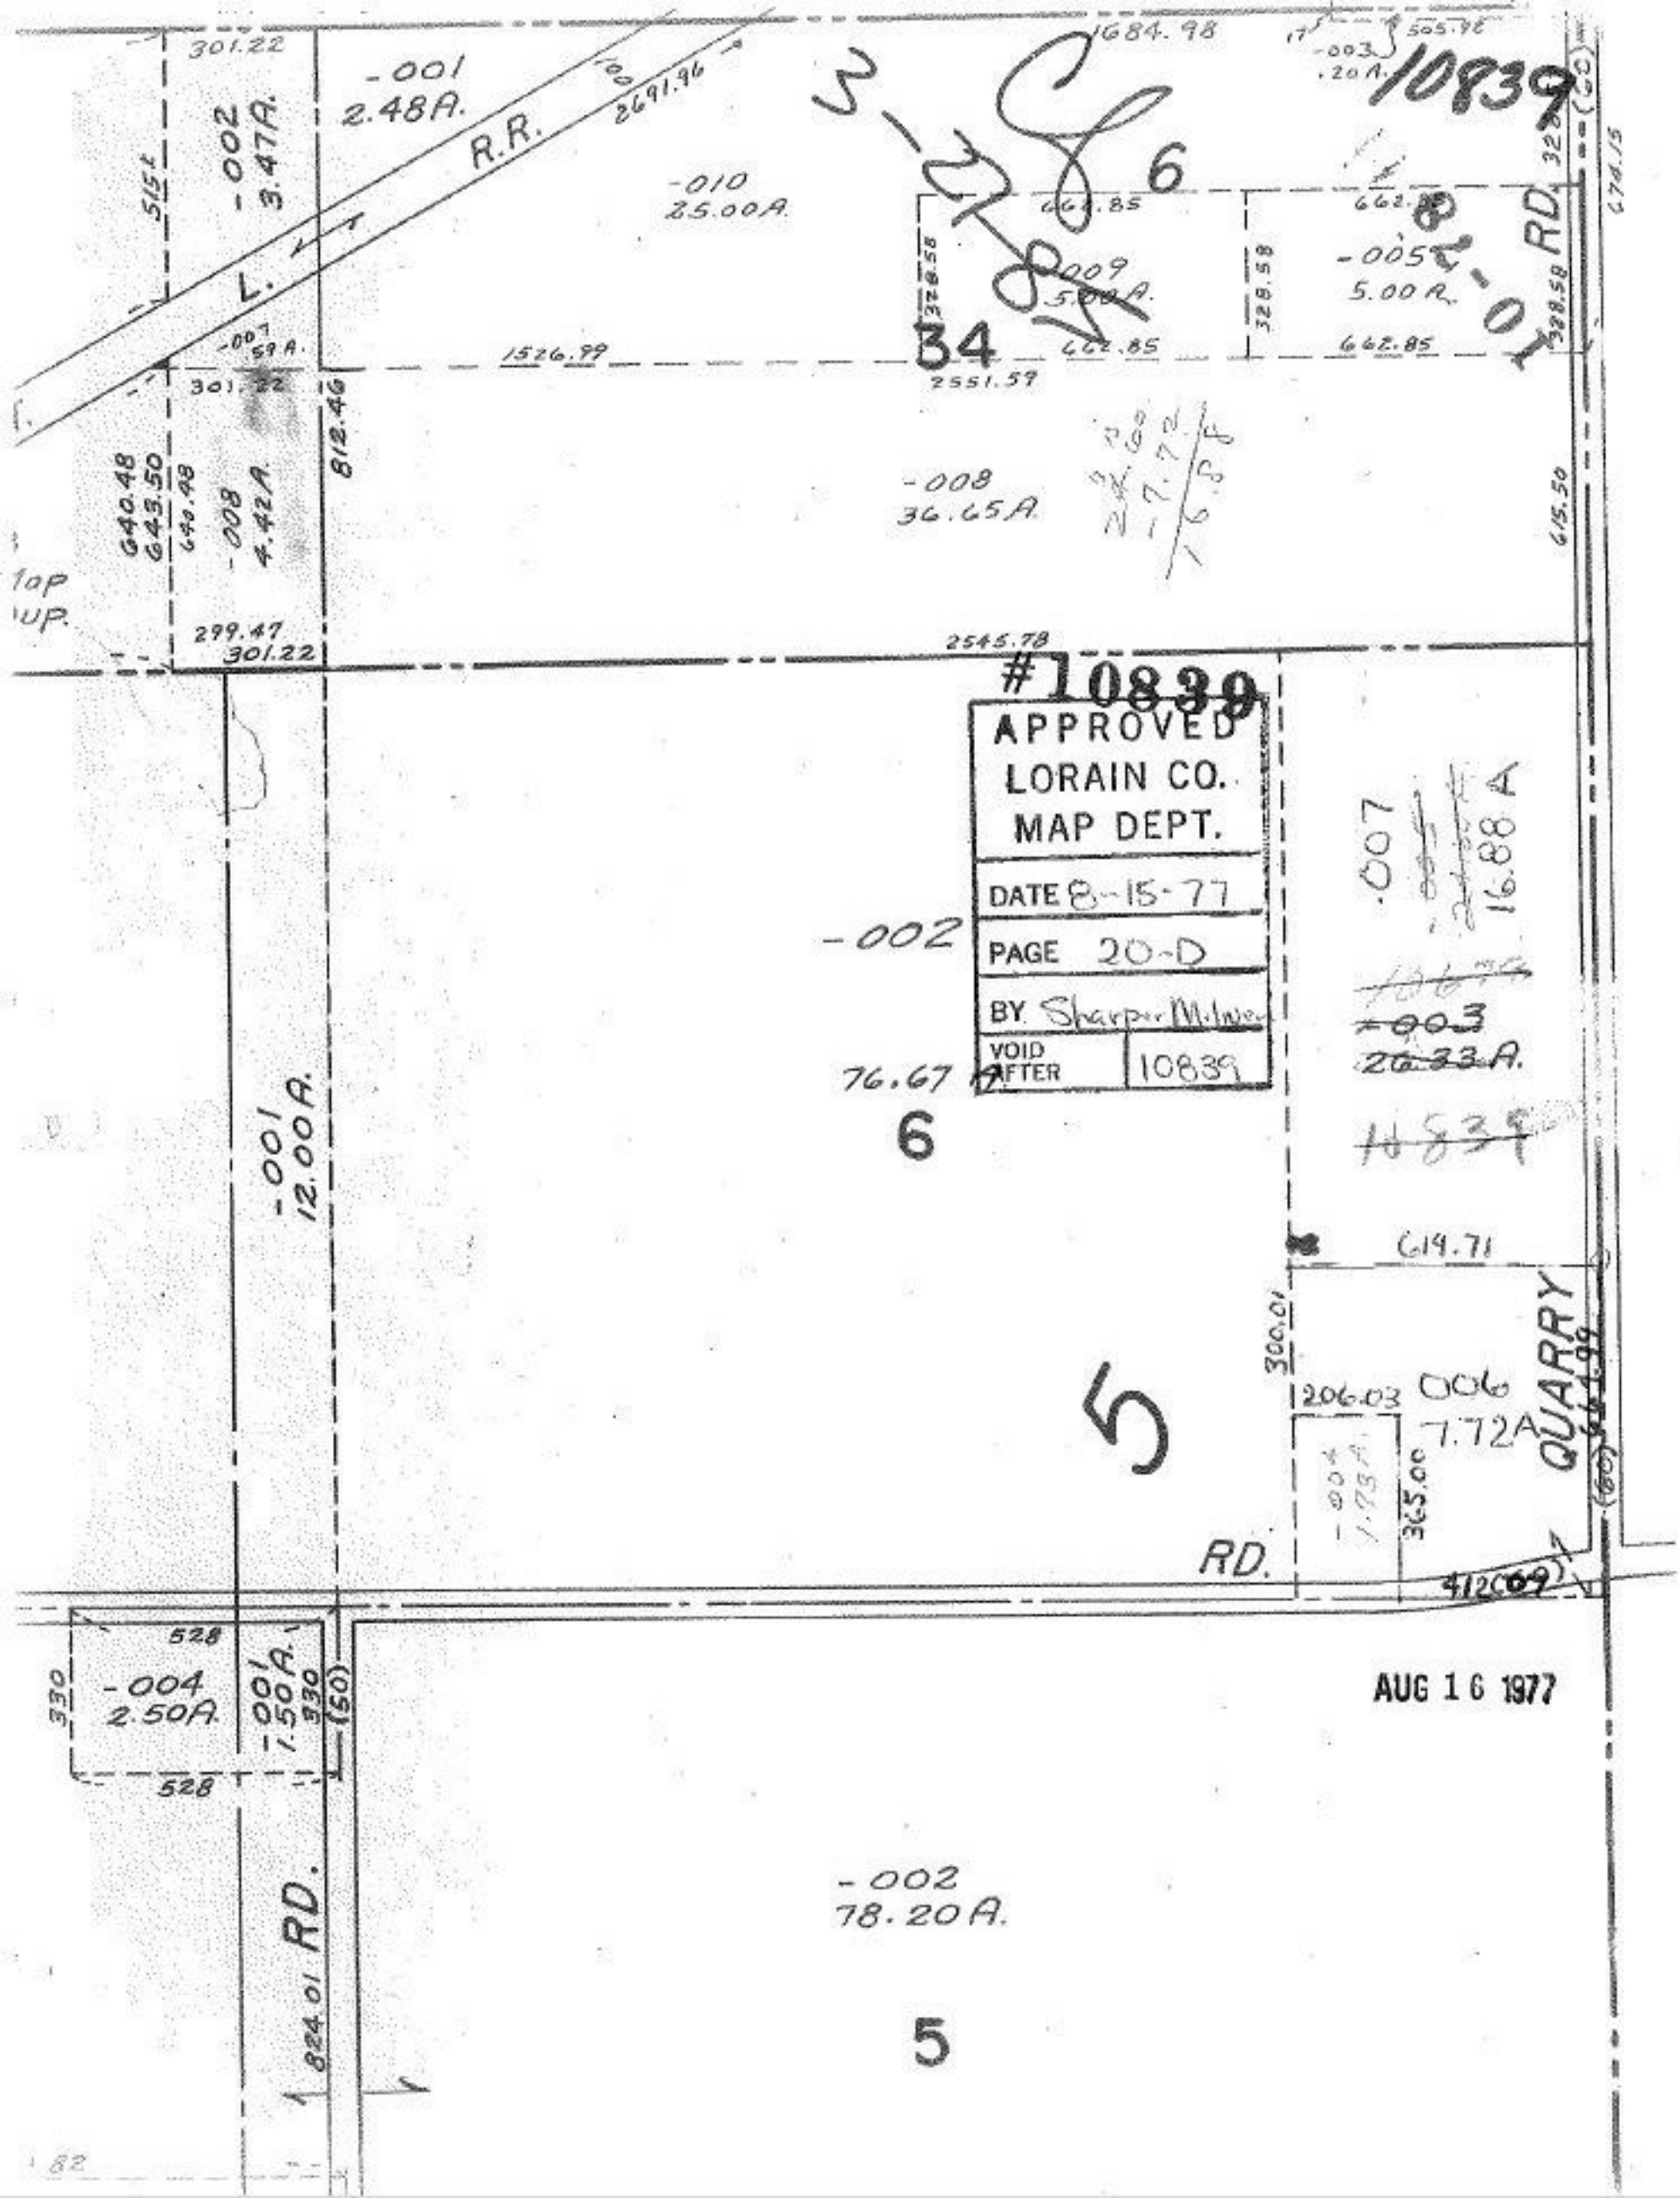

301.22
-001
2.48A.
-002
3.47A.
R.R.
2691.96
1684.98
505.98
-003
.20A.
10839
6
-010
25.00A.
662.85
-009
5.00A.
-005
5.00A.
RD.
328.58
34
1526.99
2551.59
-007
59A.
301.22
812.46
640.48
643.50
640.48
-008
4.42A.
-008
36.65A.
615.50
299.47
301.22
2545.78
#10839
APPROVED
LORAIN CO.
MAP DEPT.
DATE 8-15-77
PAGE 20-D
BY Sharper Milner
VOID AFTER 10839
-002
76.67 A.
6
-001
12.00A.
.007
16.88 A
-003
26.33 A.
10839
614.71
300.01
206.03
006
7.72A
QUARRY
5
365.00
RD.
412(69)
528
330
-004
2.50A.
-001
1.50A.
330
(50)
528
AUG 16 1977
-002
78.20A.
RD.
824.01
5