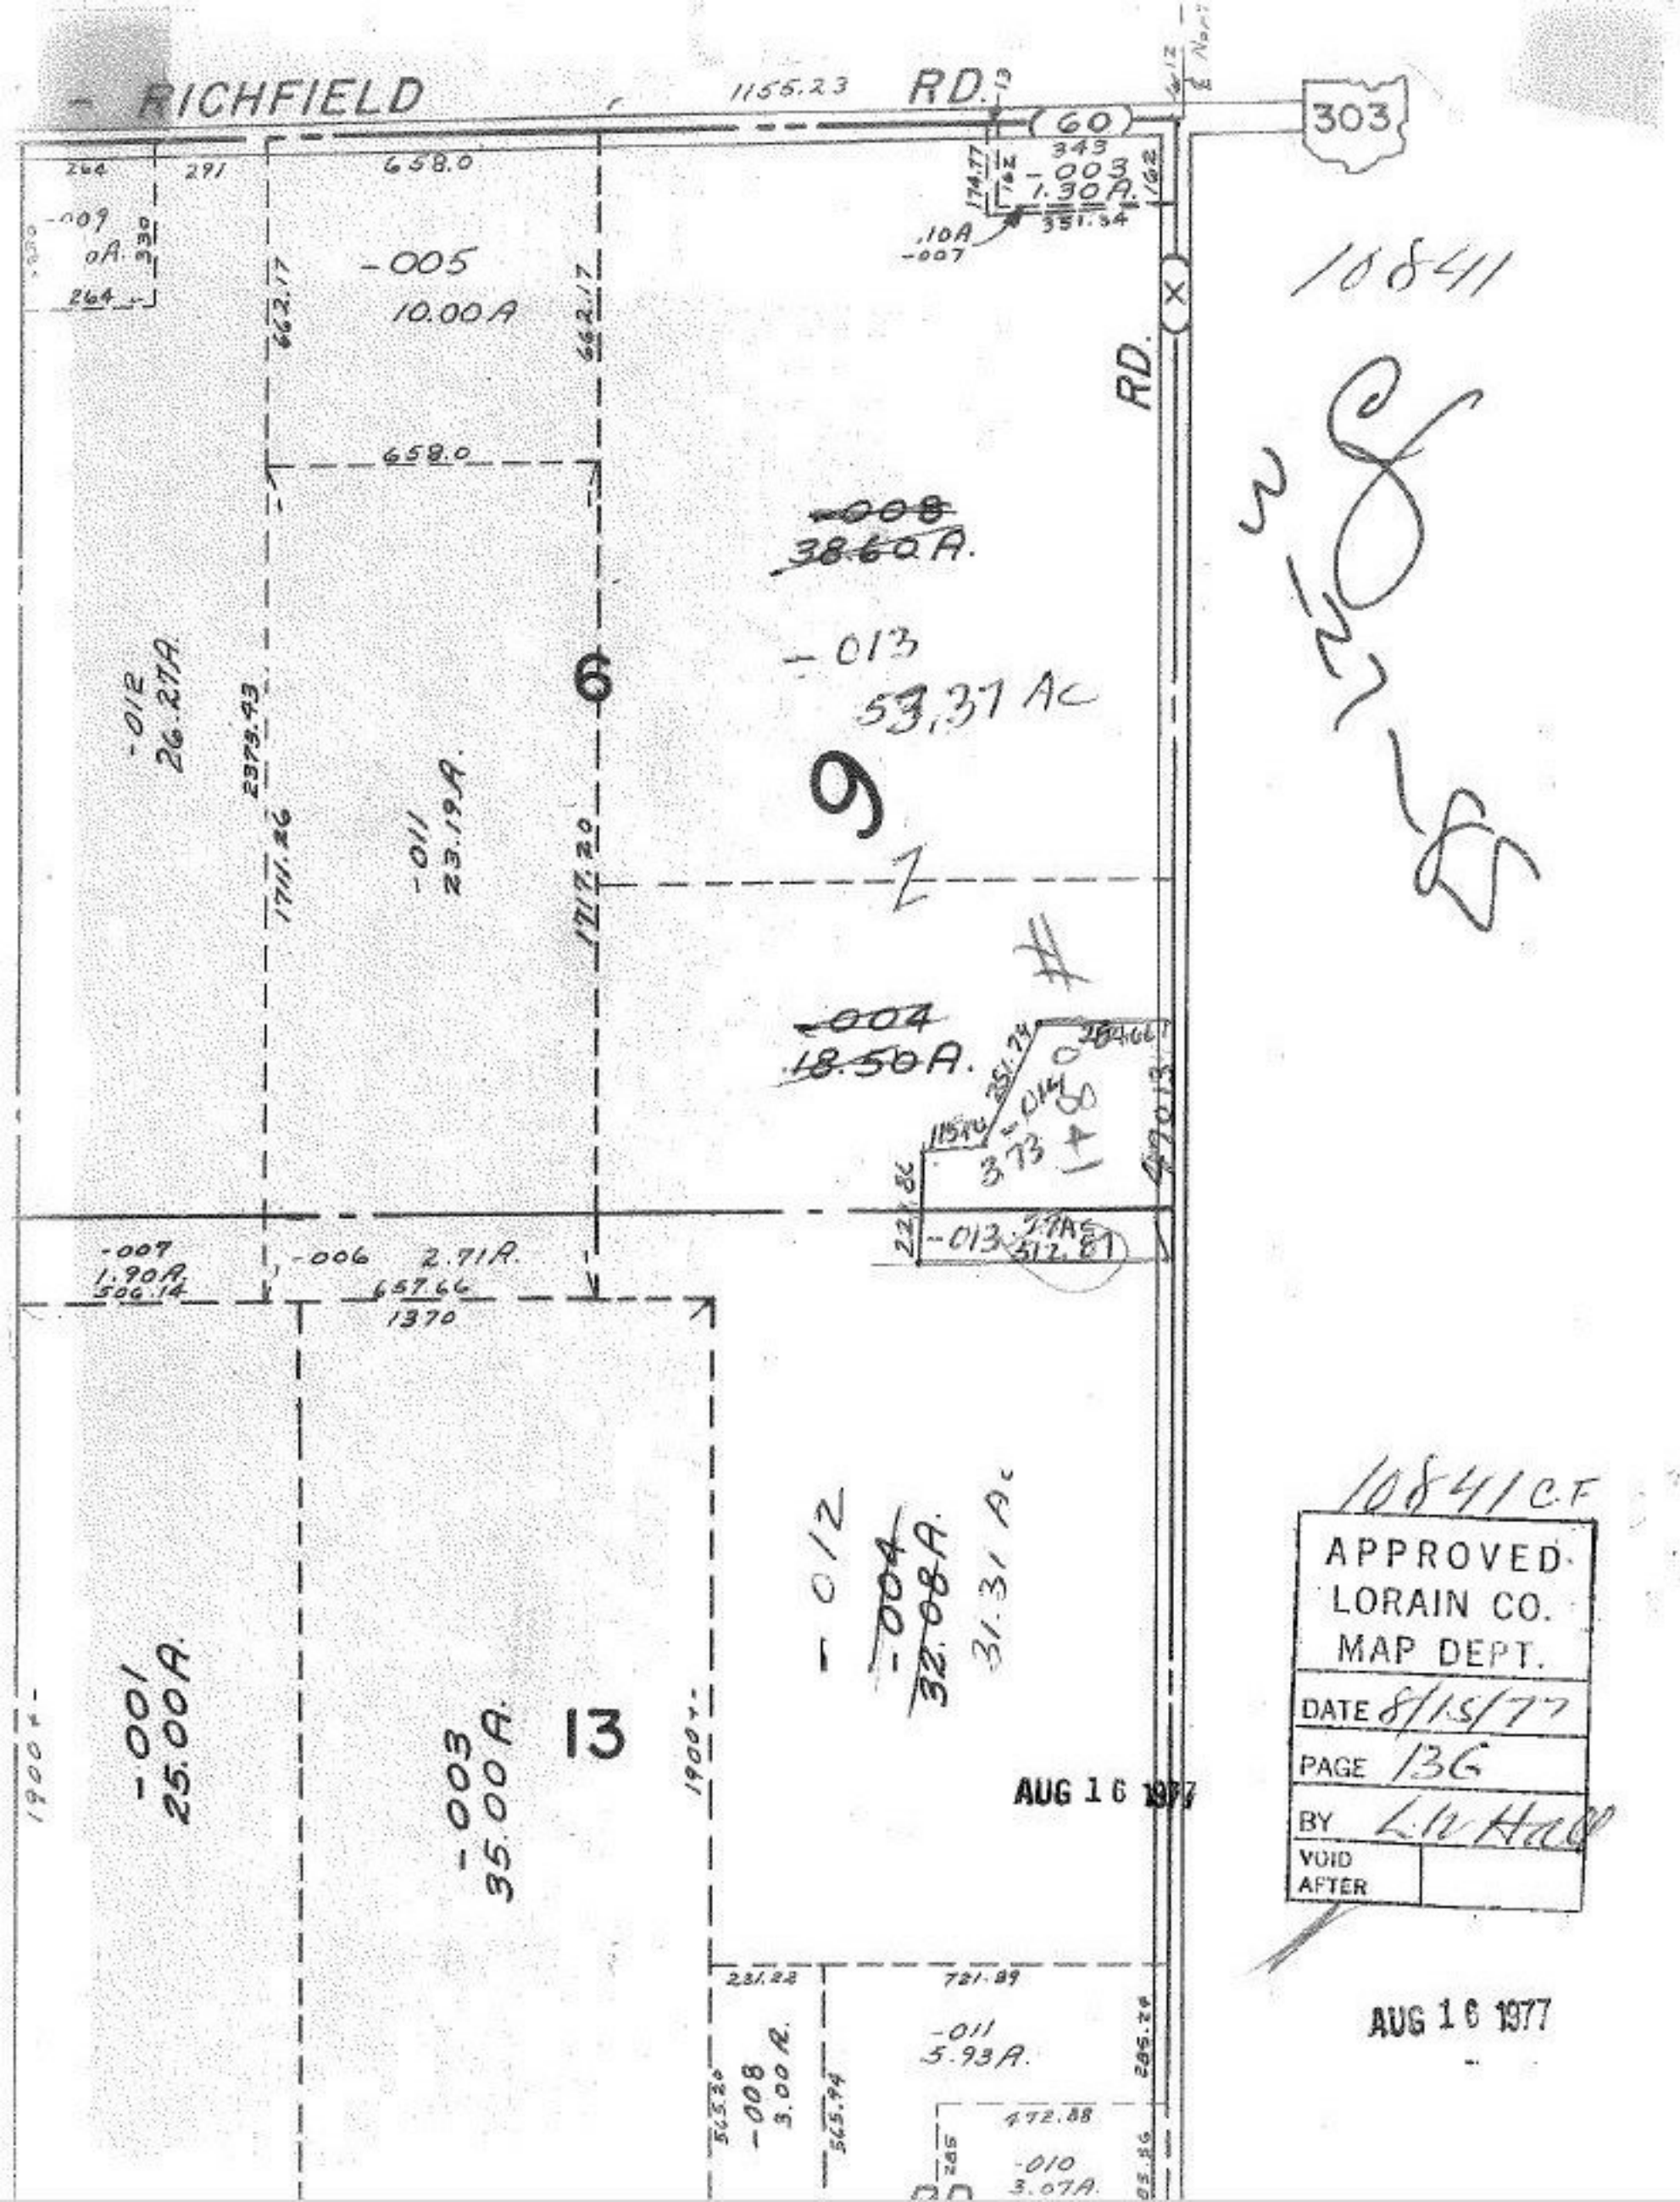
RICHFIELD RD.
1155.23
60
303
343
-003
1.30A.
351.34
.10A
-007
10841
RD.
658.0
-005
10.00A
662.17
-009
0A.
264
291
658.0
~~-008~~
~~38.60A.~~
-013
53.37 Ac
6
9
-012
26.27A
2373.43
1711.26
-011
23.19A.
1717.20
~~-004~~
~~18.50A.~~
-014
3.73
-013
512.81
-007
1.90A.
506.14
-006
2.71A.
657.66
1370
-012
~~-004~~
~~32.08A.~~
31.31 Ac
-001
25.00A.
-003
35.00A.
13
1900+
AUG 16 1977
231.22
721.89
-011
5.93A.
-008
3.00A.
565.20
565.94
472.88
-010
3.07A.
10841 C.F
APPROVED
LORAIN CO.
MAP DEPT.
DATE 8/15/77
PAGE 136
BY L.W. Hall
VOID AFTER
AUG 16 1977