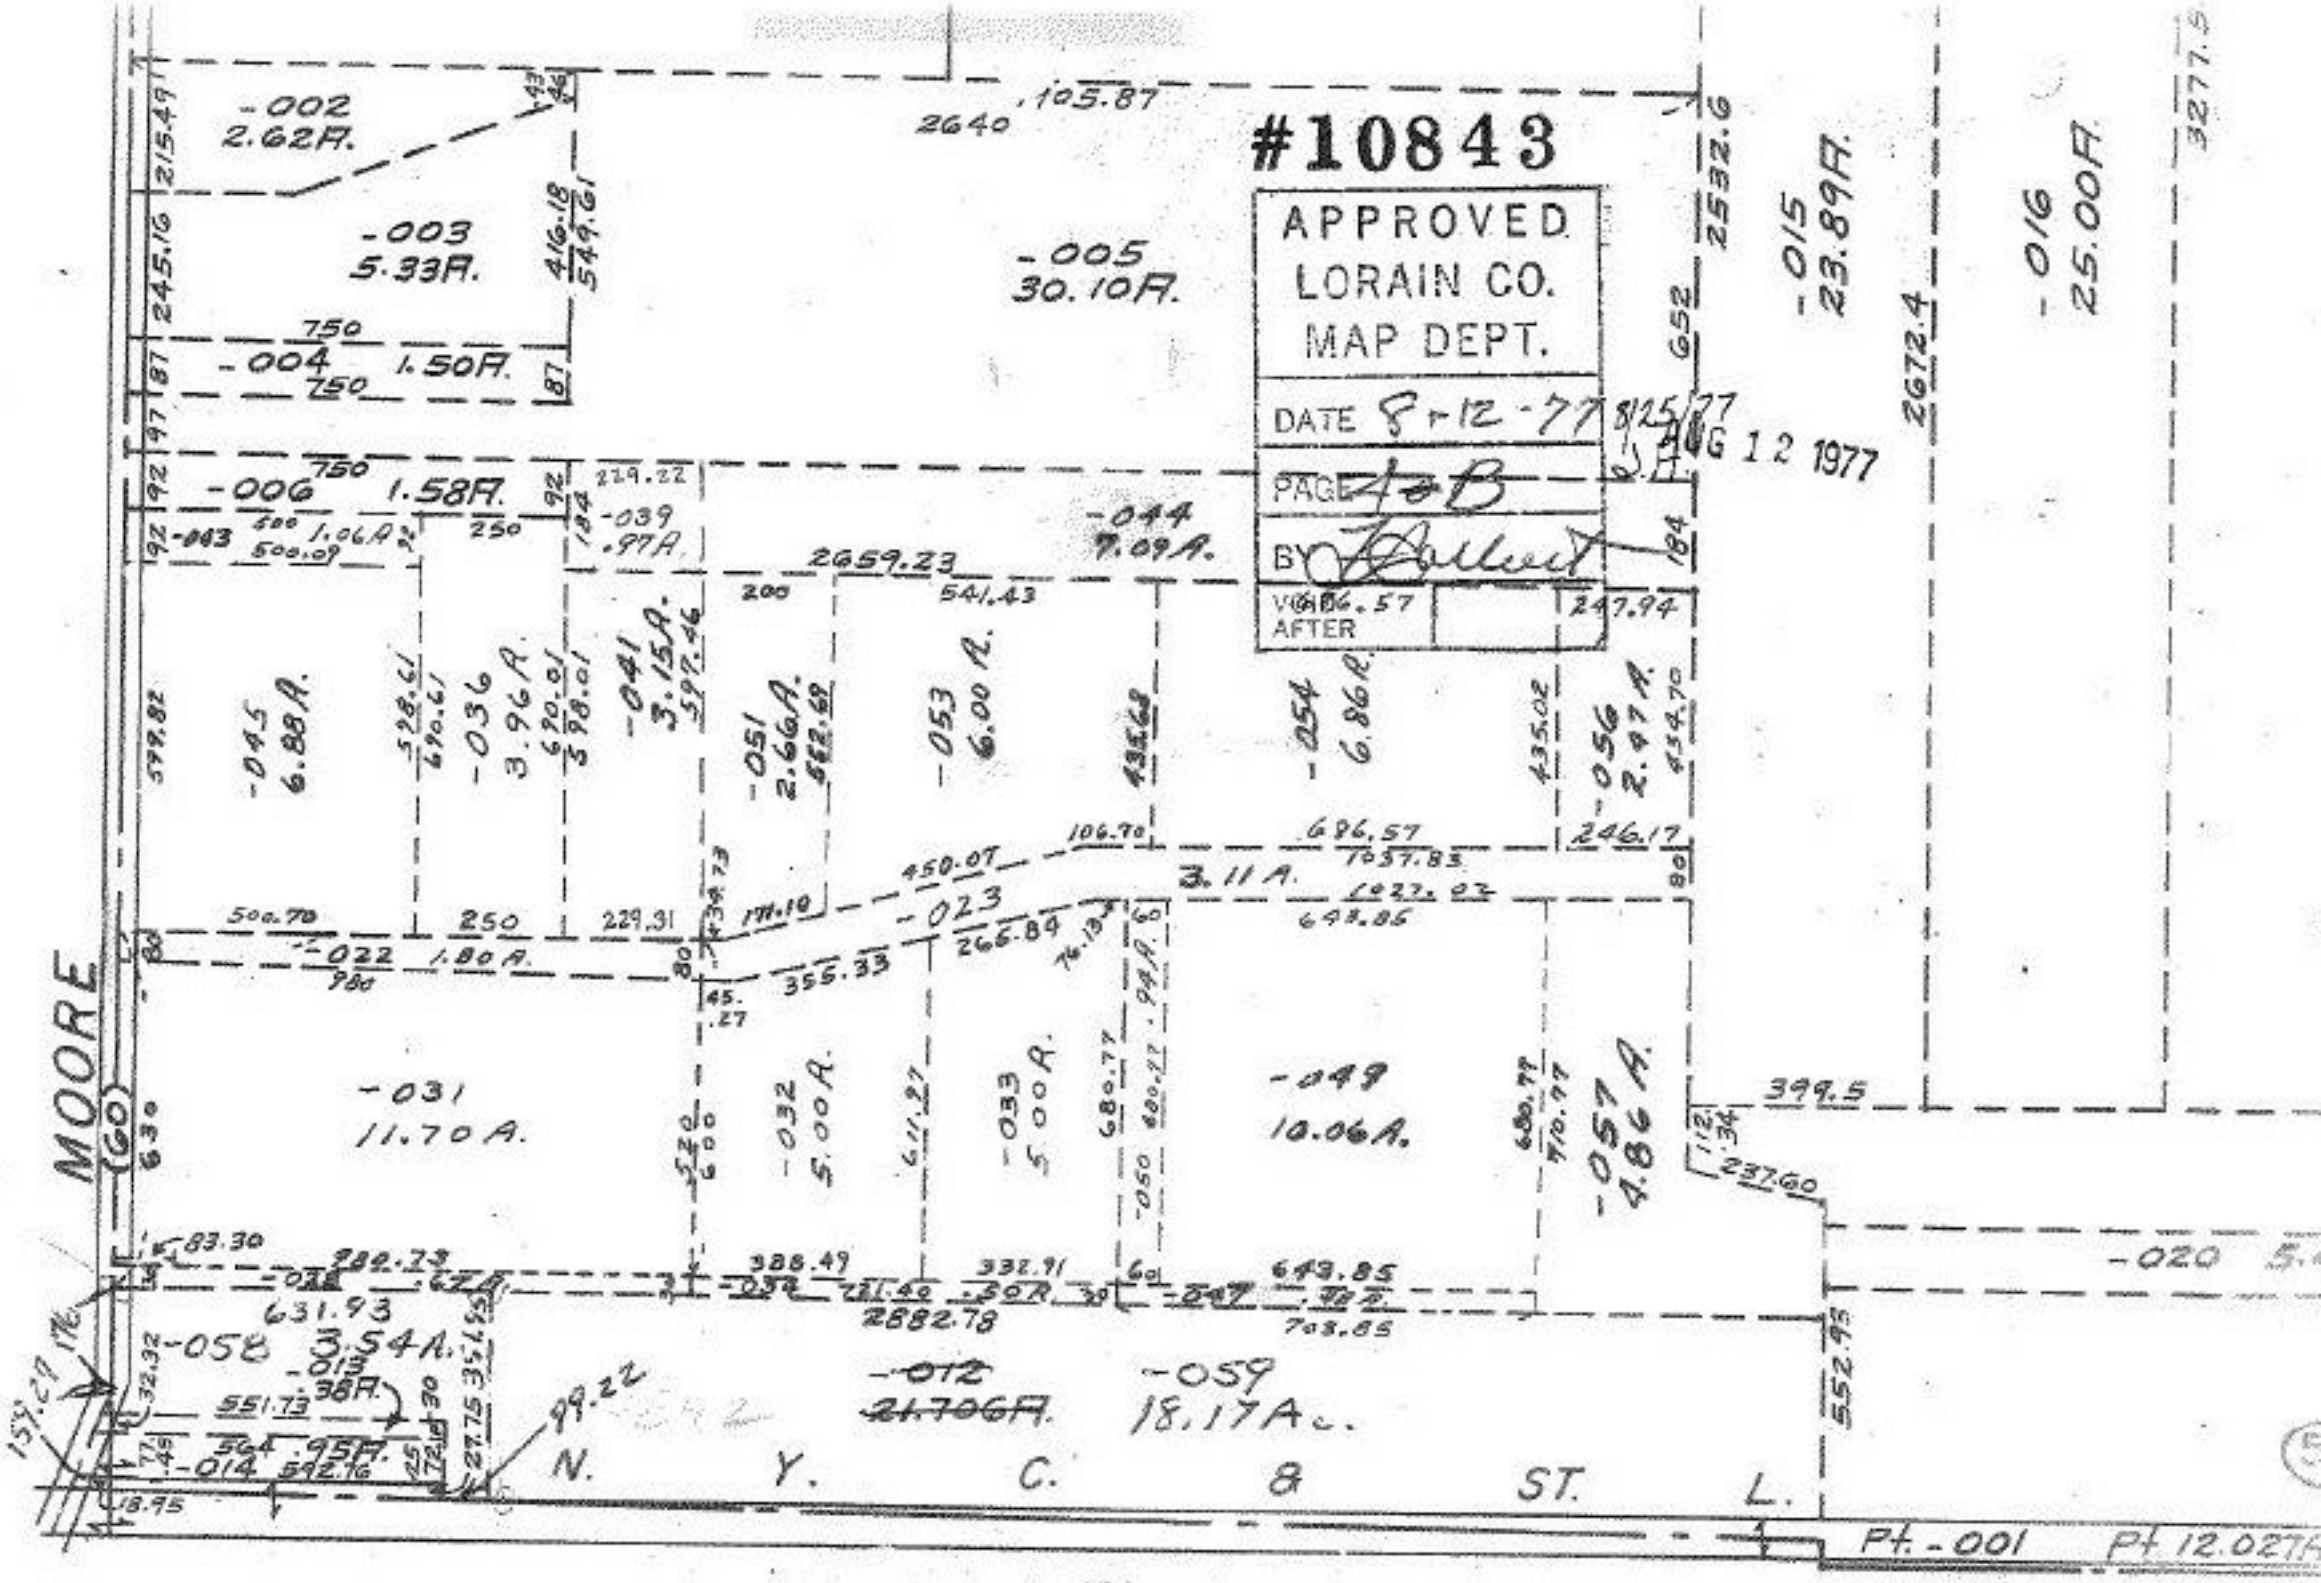

4.87Ac.
1.33
3.54

.38
.95
1.33

21.71
3.54
18.17

AVON LAKE CITY

SCALE: 1" = 400'

10843