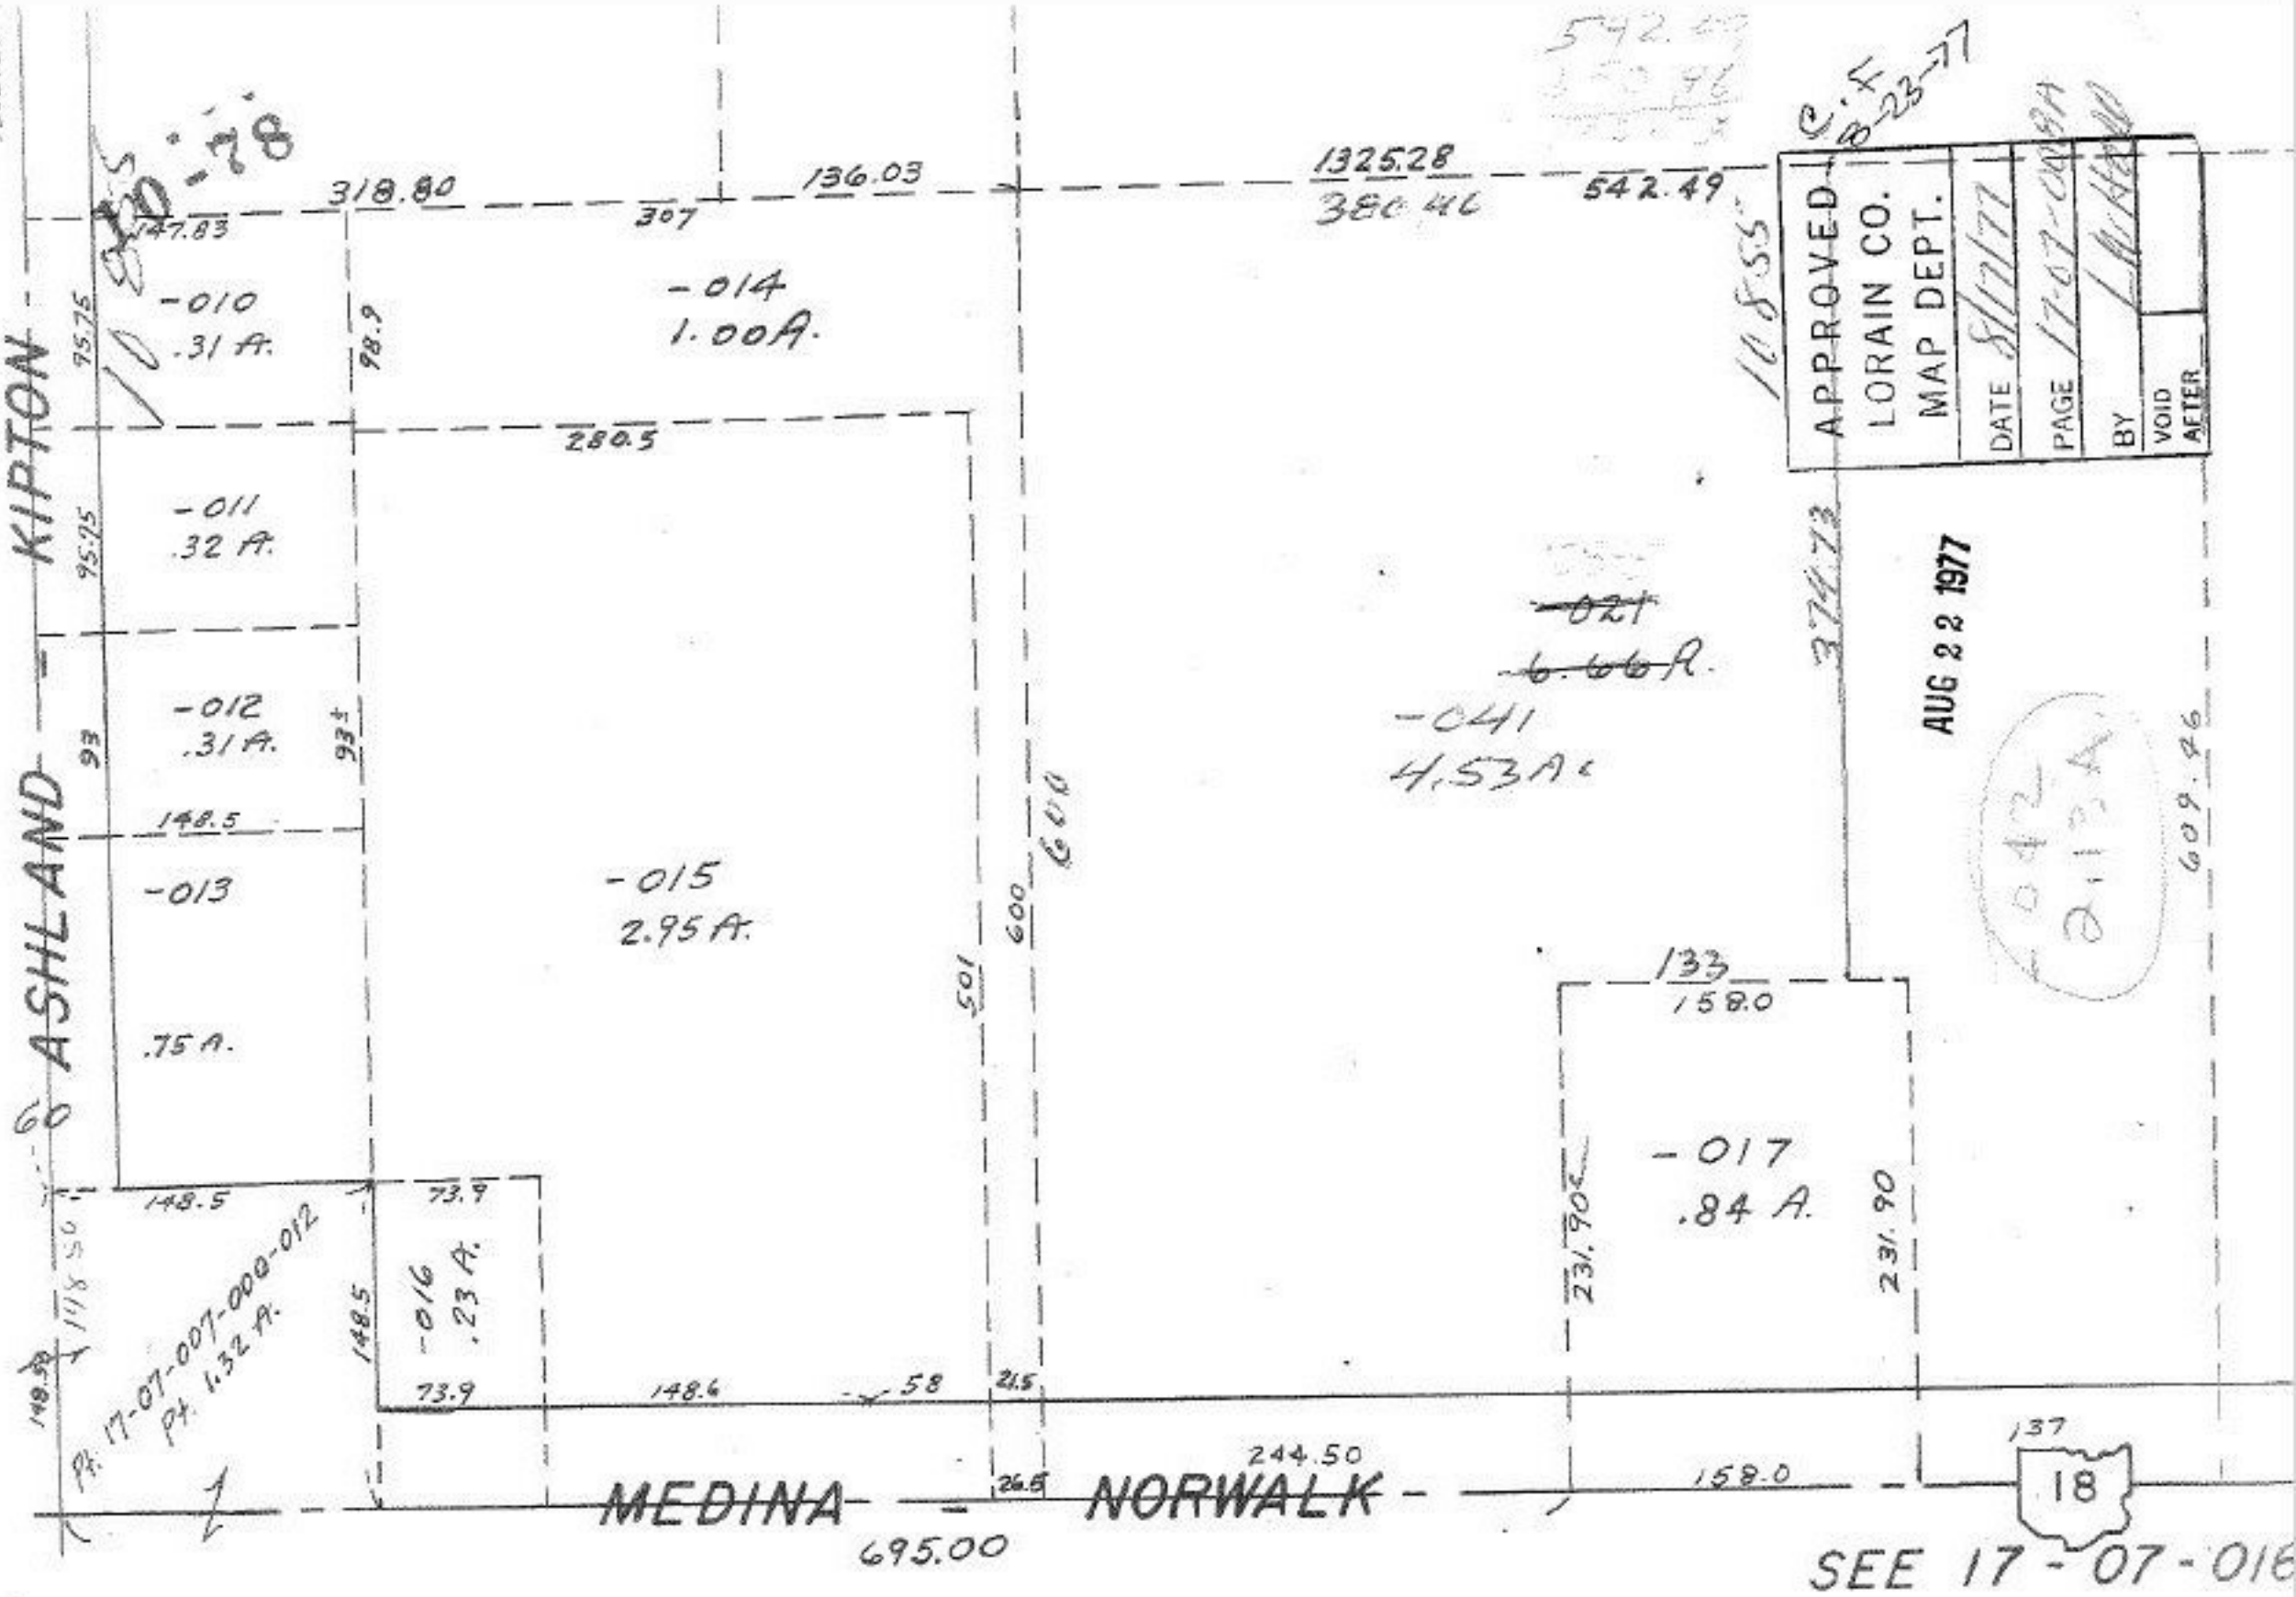

BRIGHTON TWP.