


18858

121

SEE 101-00

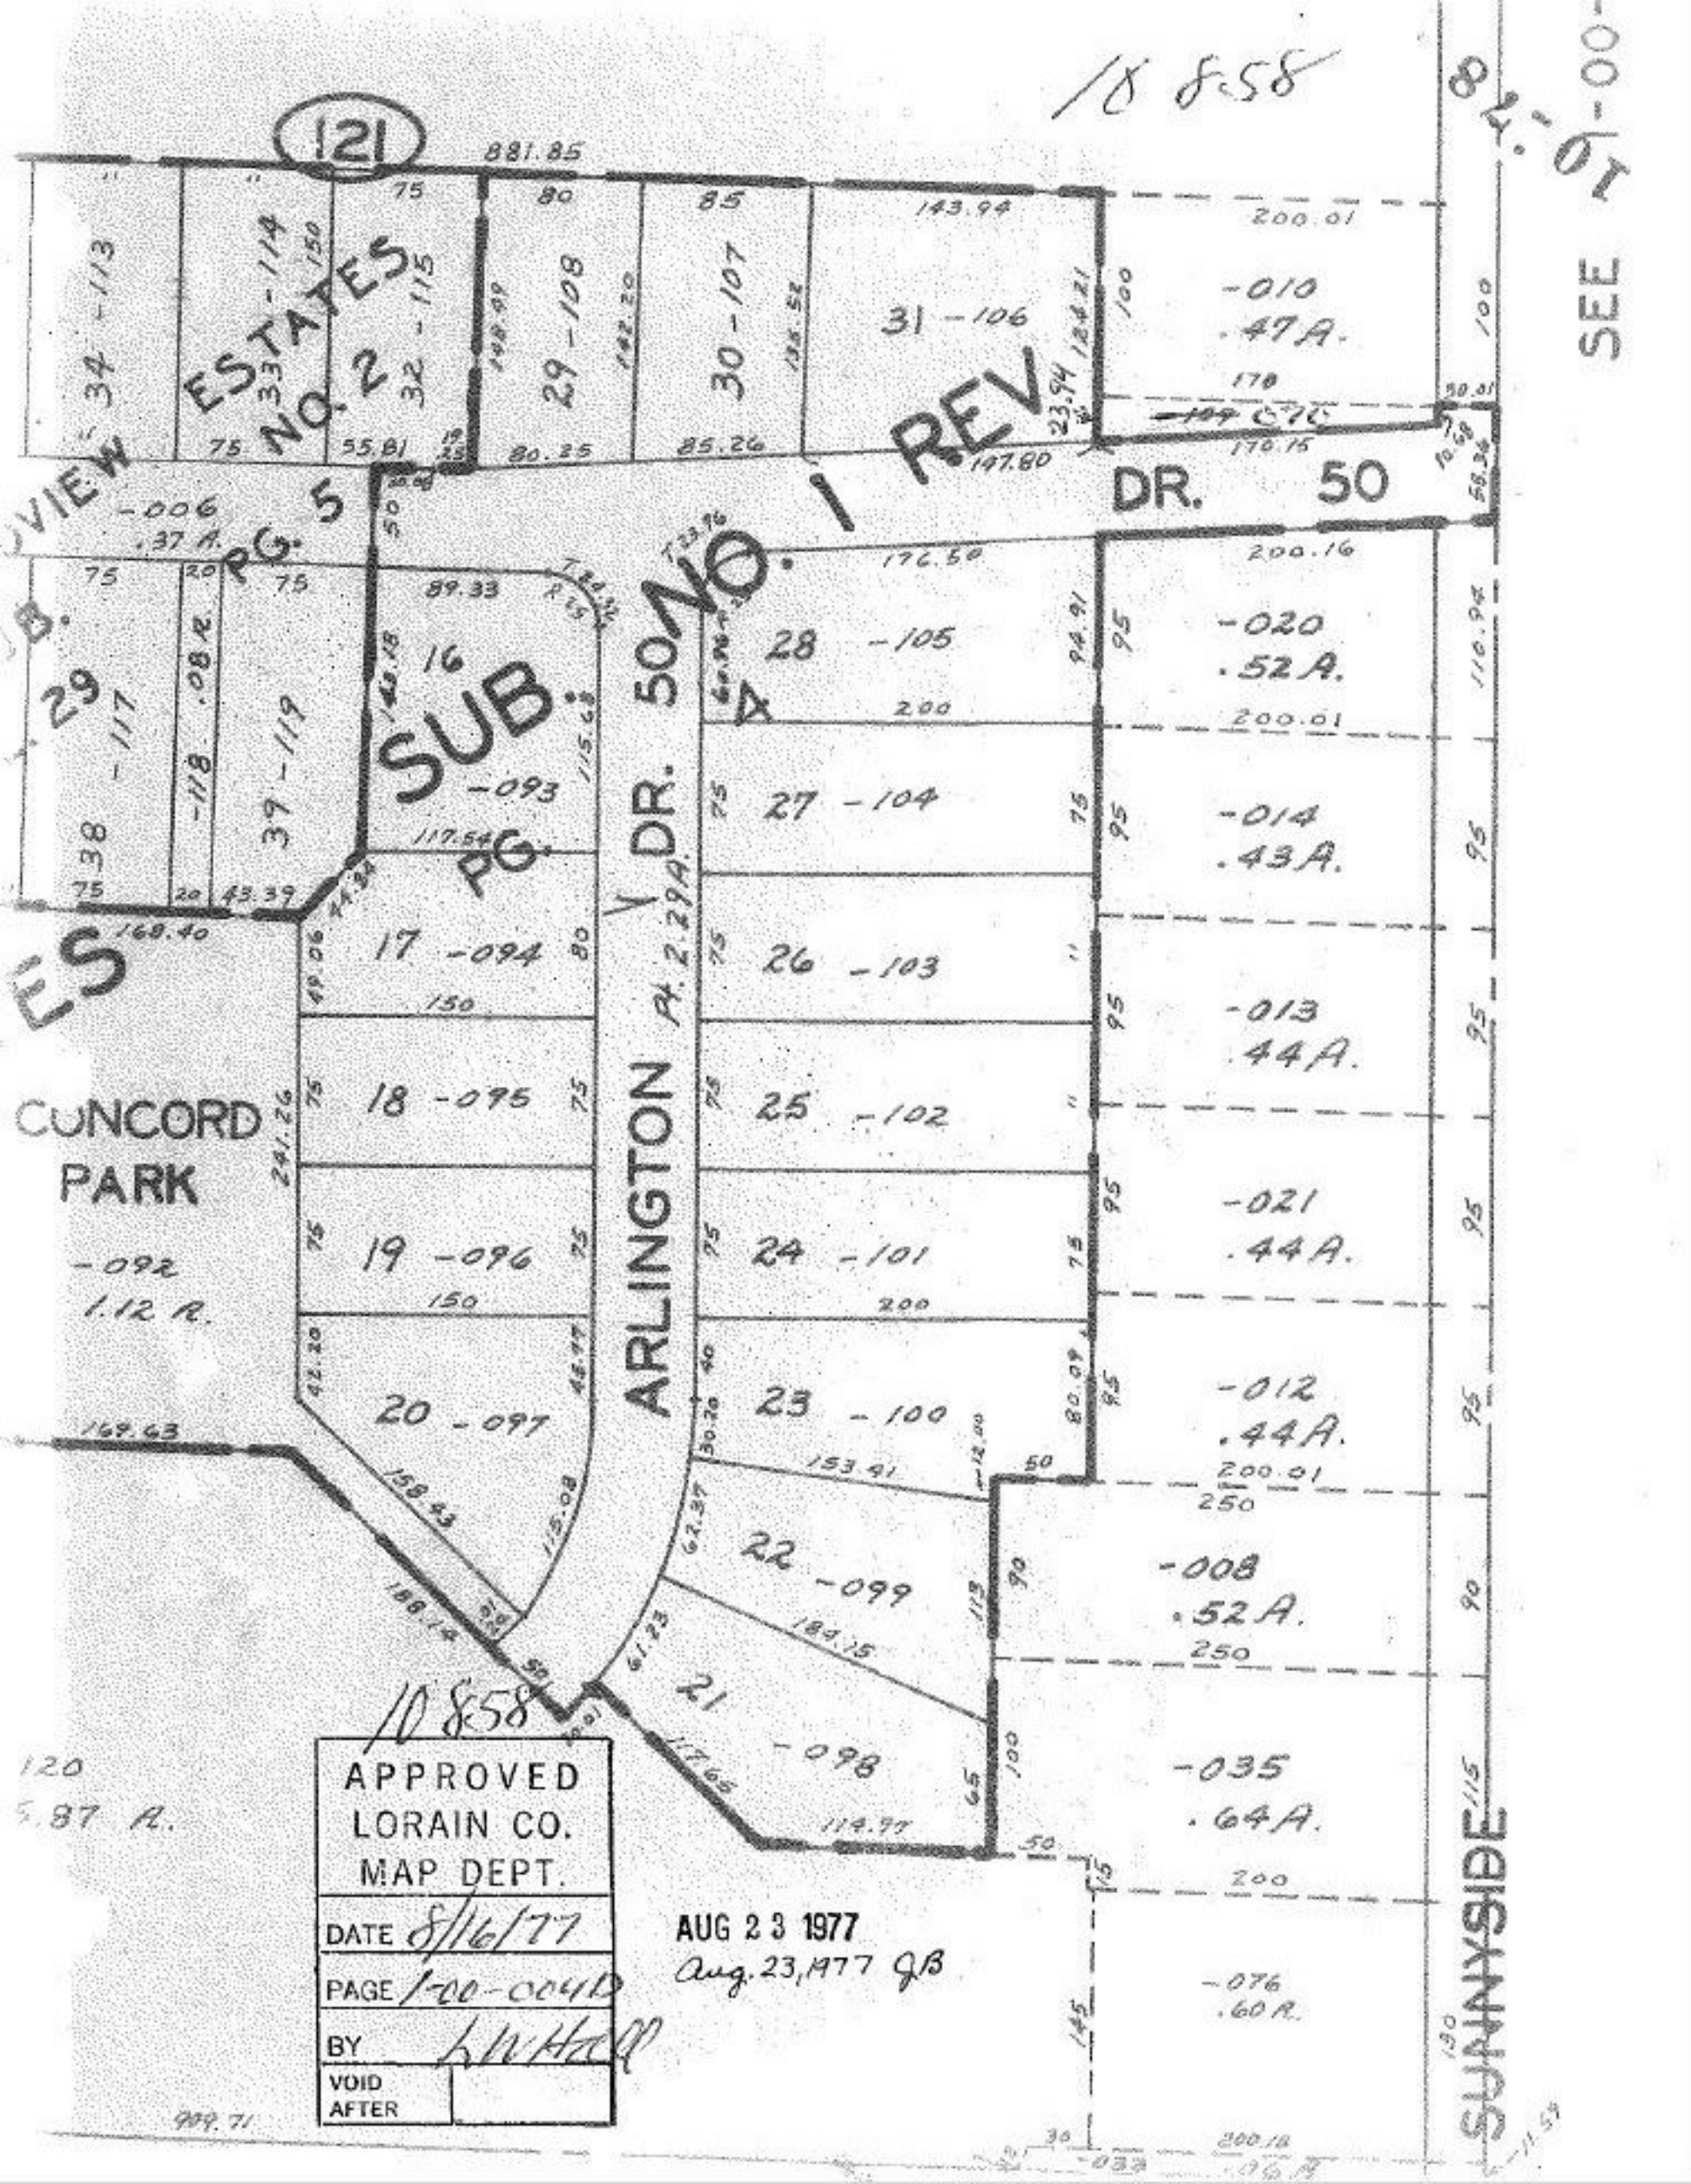

CONCORD PARK
-092
1.12 R.

APPROVED
LORAIN CO.
MAP DEPT.
DATE 8/16/77
PAGE 100-004D
BY LWH
VOID AFTER

AUG 23 1977
Aug. 23, 1977 QB

SUNNYSIDE

120
5.87 R.

909.71

11.52