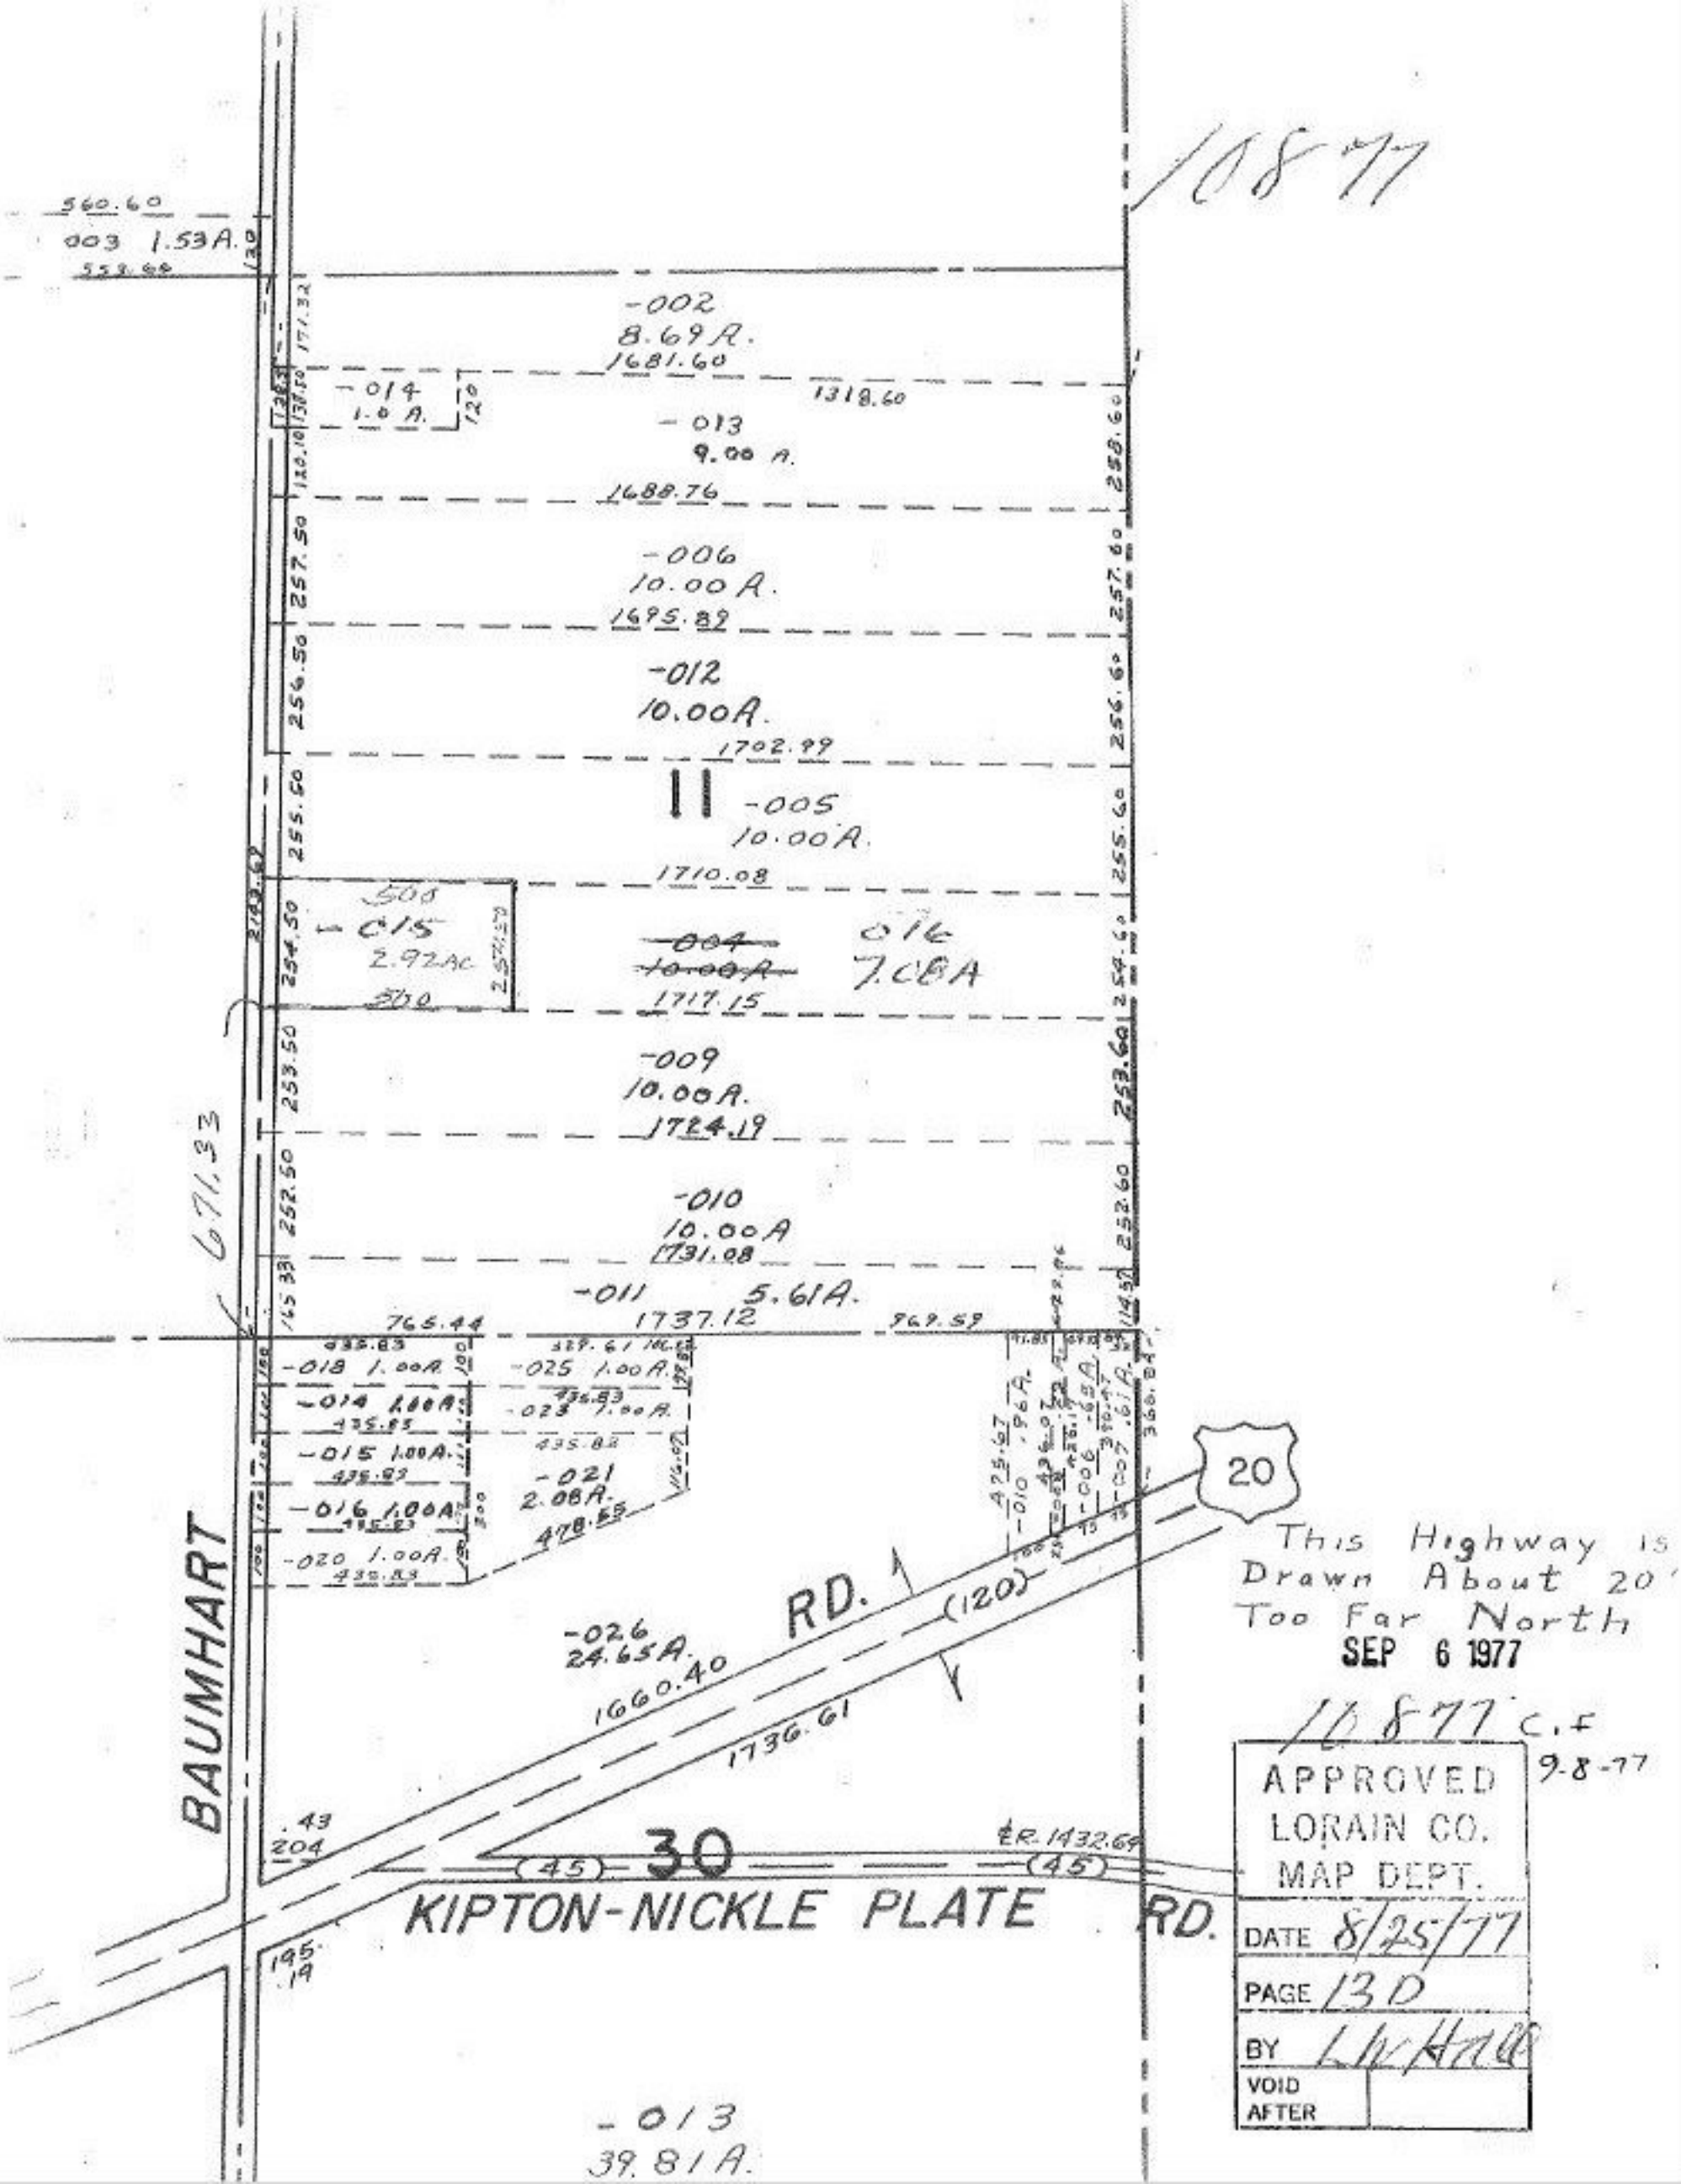
10877
560.60
003 1.53A.
-002
8.69A.
1681.60
-014
1.0 A.
1318.60
-013
9.00 A.
1688.76
-006
10.00A.
1695.89
-012
10.00A.
1702.99
-005
10.00A.
1710.08
-015
2.92AC
-004
10.00A
016
7.08A
1717.15
-009
10.00A.
1724.19
-010
10.00A
1731.08
-011
5.61A.
1737.12
765.44
969.59
-018 1.00A.
-025 1.00A.
-014 1.00A.
-023 1.00A.
-015 1.00A.
-021
2.08A.
-016 1.00A.
-020 1.00A.
-026
24.65A.
1660.40
1736.61
RD.
(120)
20
BAUMHART
30
(45)
KIPTON-NICKLE PLATE RD.
-013
39.81A.
This Highway is Drawn About 20' Too Far North
SEP 6 1977
10877 C.F
9-8-77
APPROVED
LORAIN CO.
MAP DEPT.
DATE 8/25/77
PAGE 13D
BY
VOID AFTER