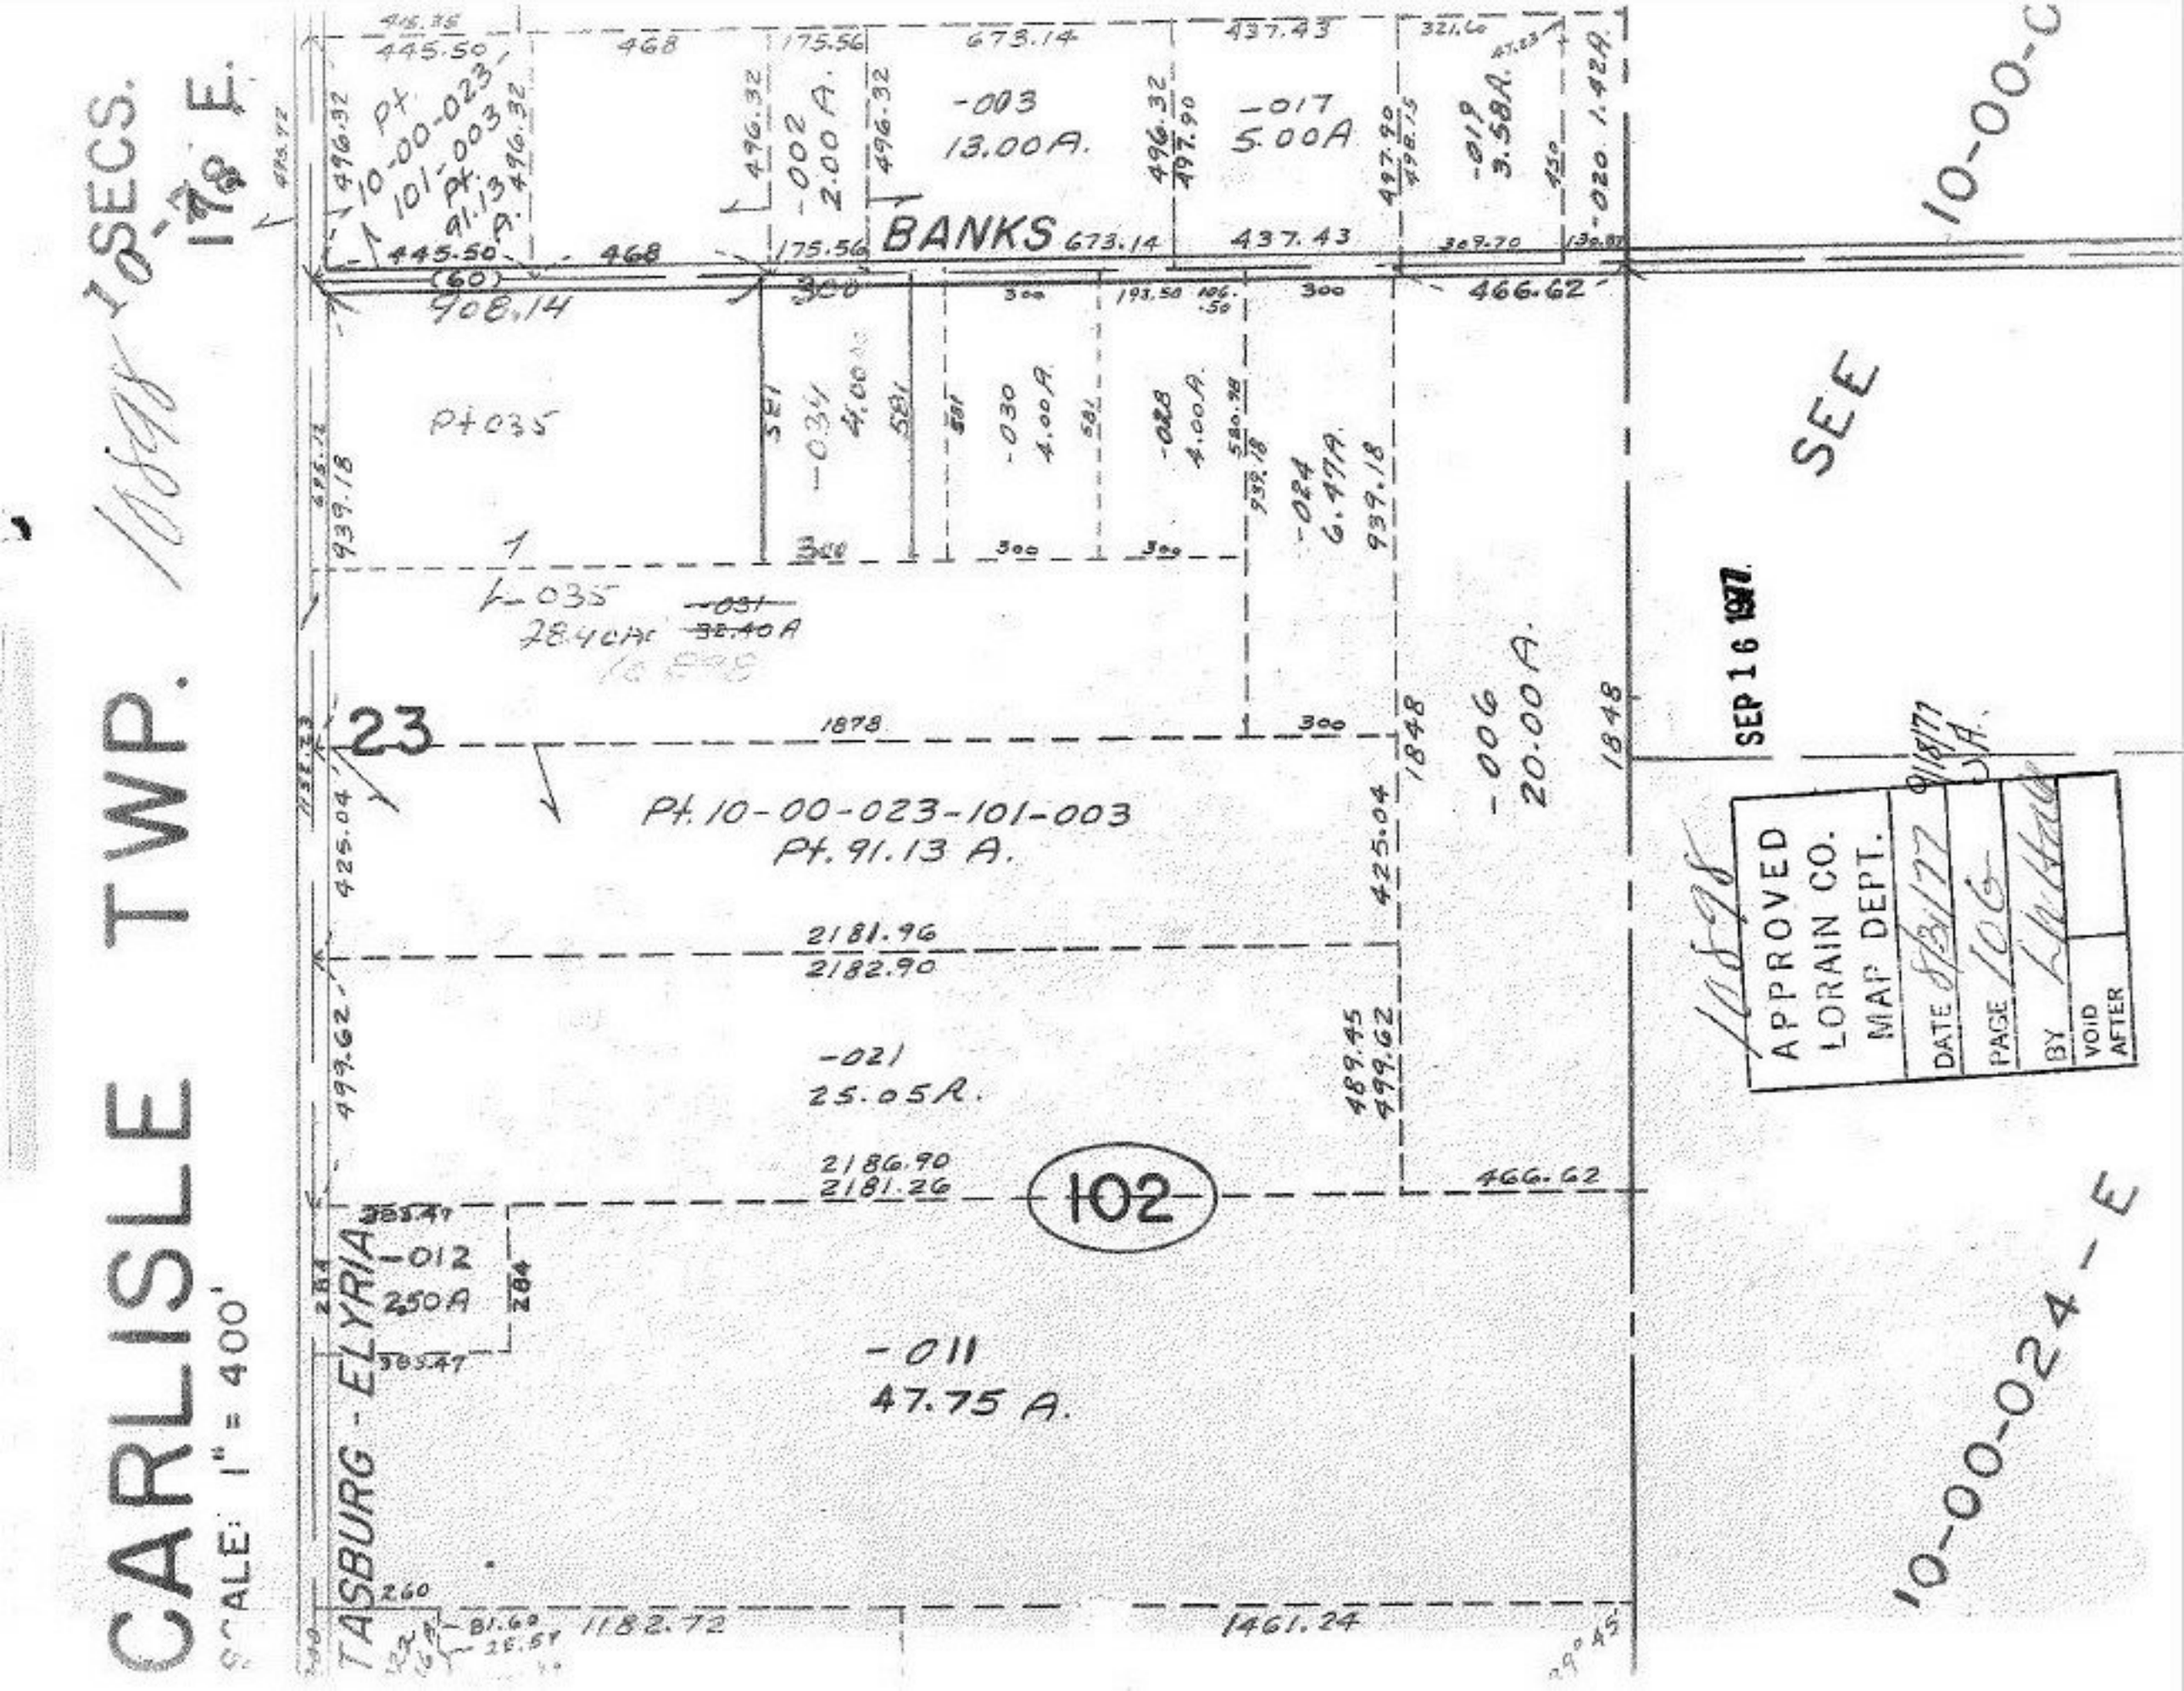
CARLISLE TWP.
SCALE: 1" = 400'
10-00-023-101-003 Pt. 91.13 A.
-003 13.00A.
-017 5.00A
-019 3.58A.
-020 1.42A.
-002 2.00 A.
BANKS
Pt 035
-034 4.00A
-030 4.00A
-028 4.00A
-024 6.47A.
-035 28.40A
-031 32.40A
23
Pt. 10-00-023-101-003
Pt. 91.13 A.
-006 20.00 A.
-021 25.05A.
102
-012 2.50A
-011 47.75 A.
TASBURG - ELYRIA
SEE 10-00-024-E
10-00-C
SEP 16 1977
APPROVED
LORAIN CO.
MAP DEPT.
DATE 8/31/77
PAGE 106
BY
VOID AFTER
10898