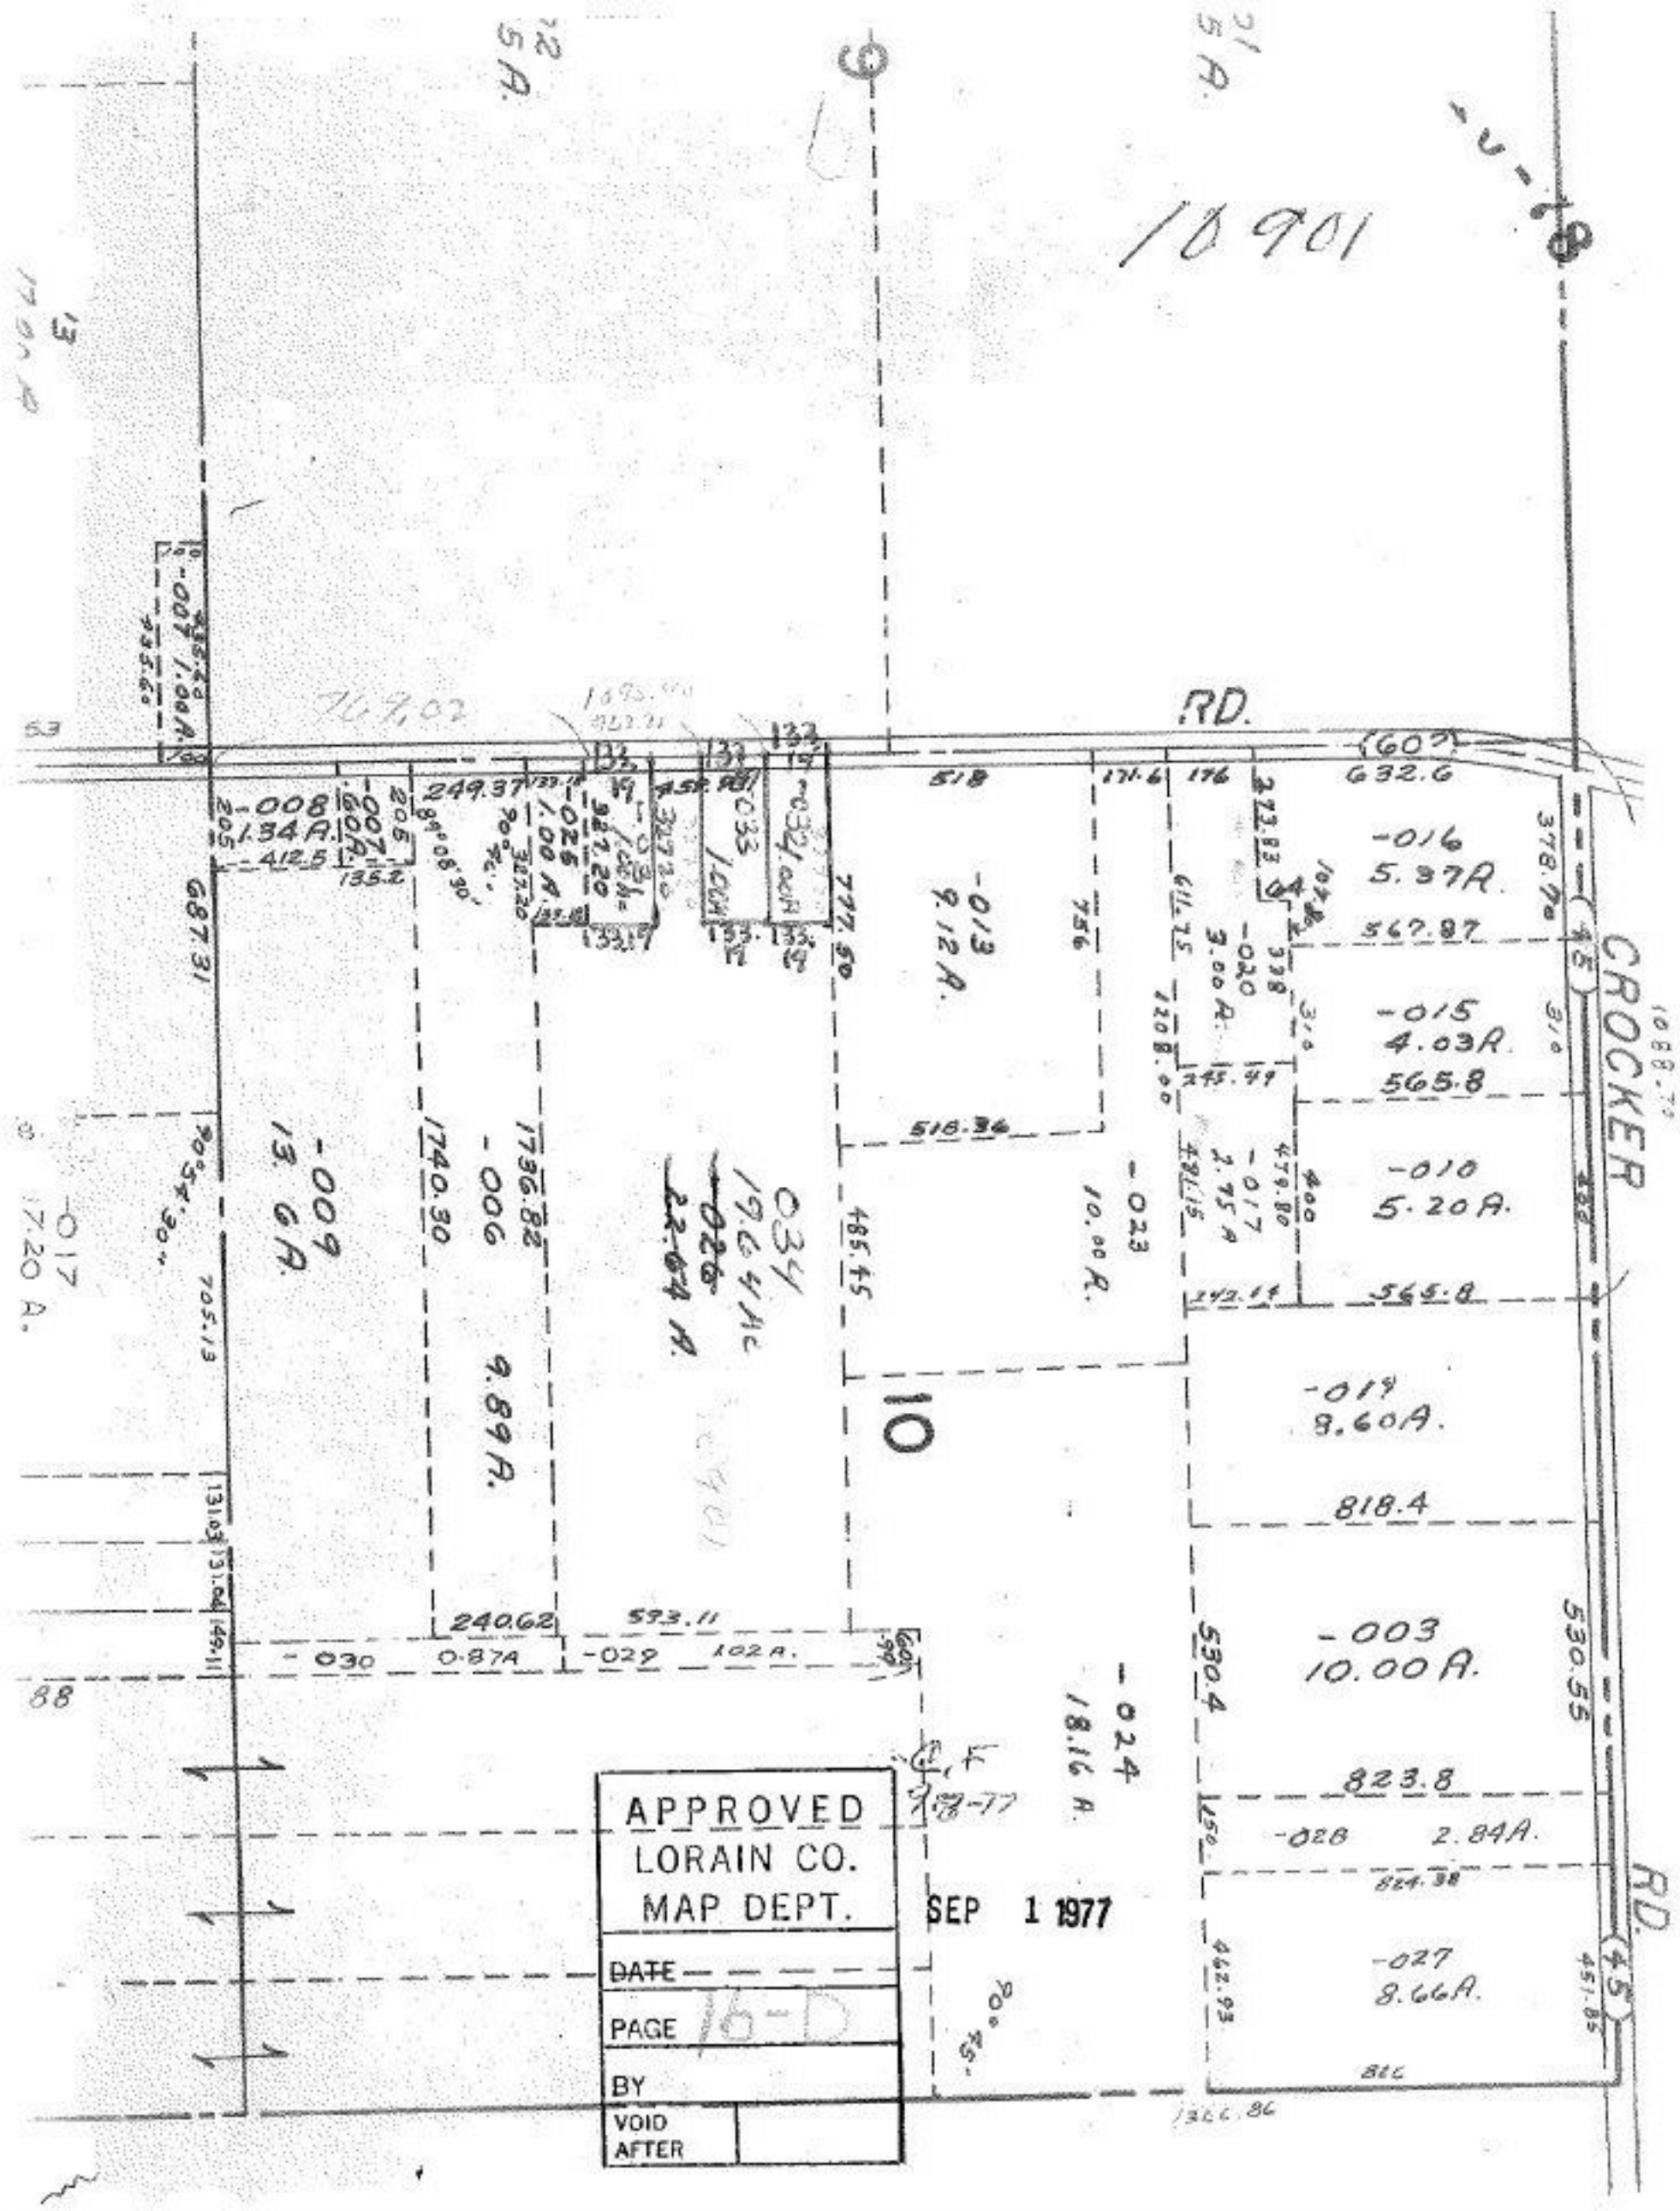
10901
RD.
CROCKER
RD.
-008
1.34 A.
-007
-009
13.6 A.
-006
9.89 A.
-013
9.12 A.
-016
5.37 A.
-015
4.03 A.
-010
5.20 A.
-019
8.60 A.
-003
10.00 A.
-027
8.66 A.
-024
18.16 A.
-023
10.00 A.
-020
3.00 A.
-017
2.75 A.
-030
0.87 A.
-029
1.02 A.
-028
2.84 A.
10
APPROVED
LORAIN CO.
MAP DEPT.
SEP 1 1977
DATE
PAGE 16-D
BY
VOID
AFTER