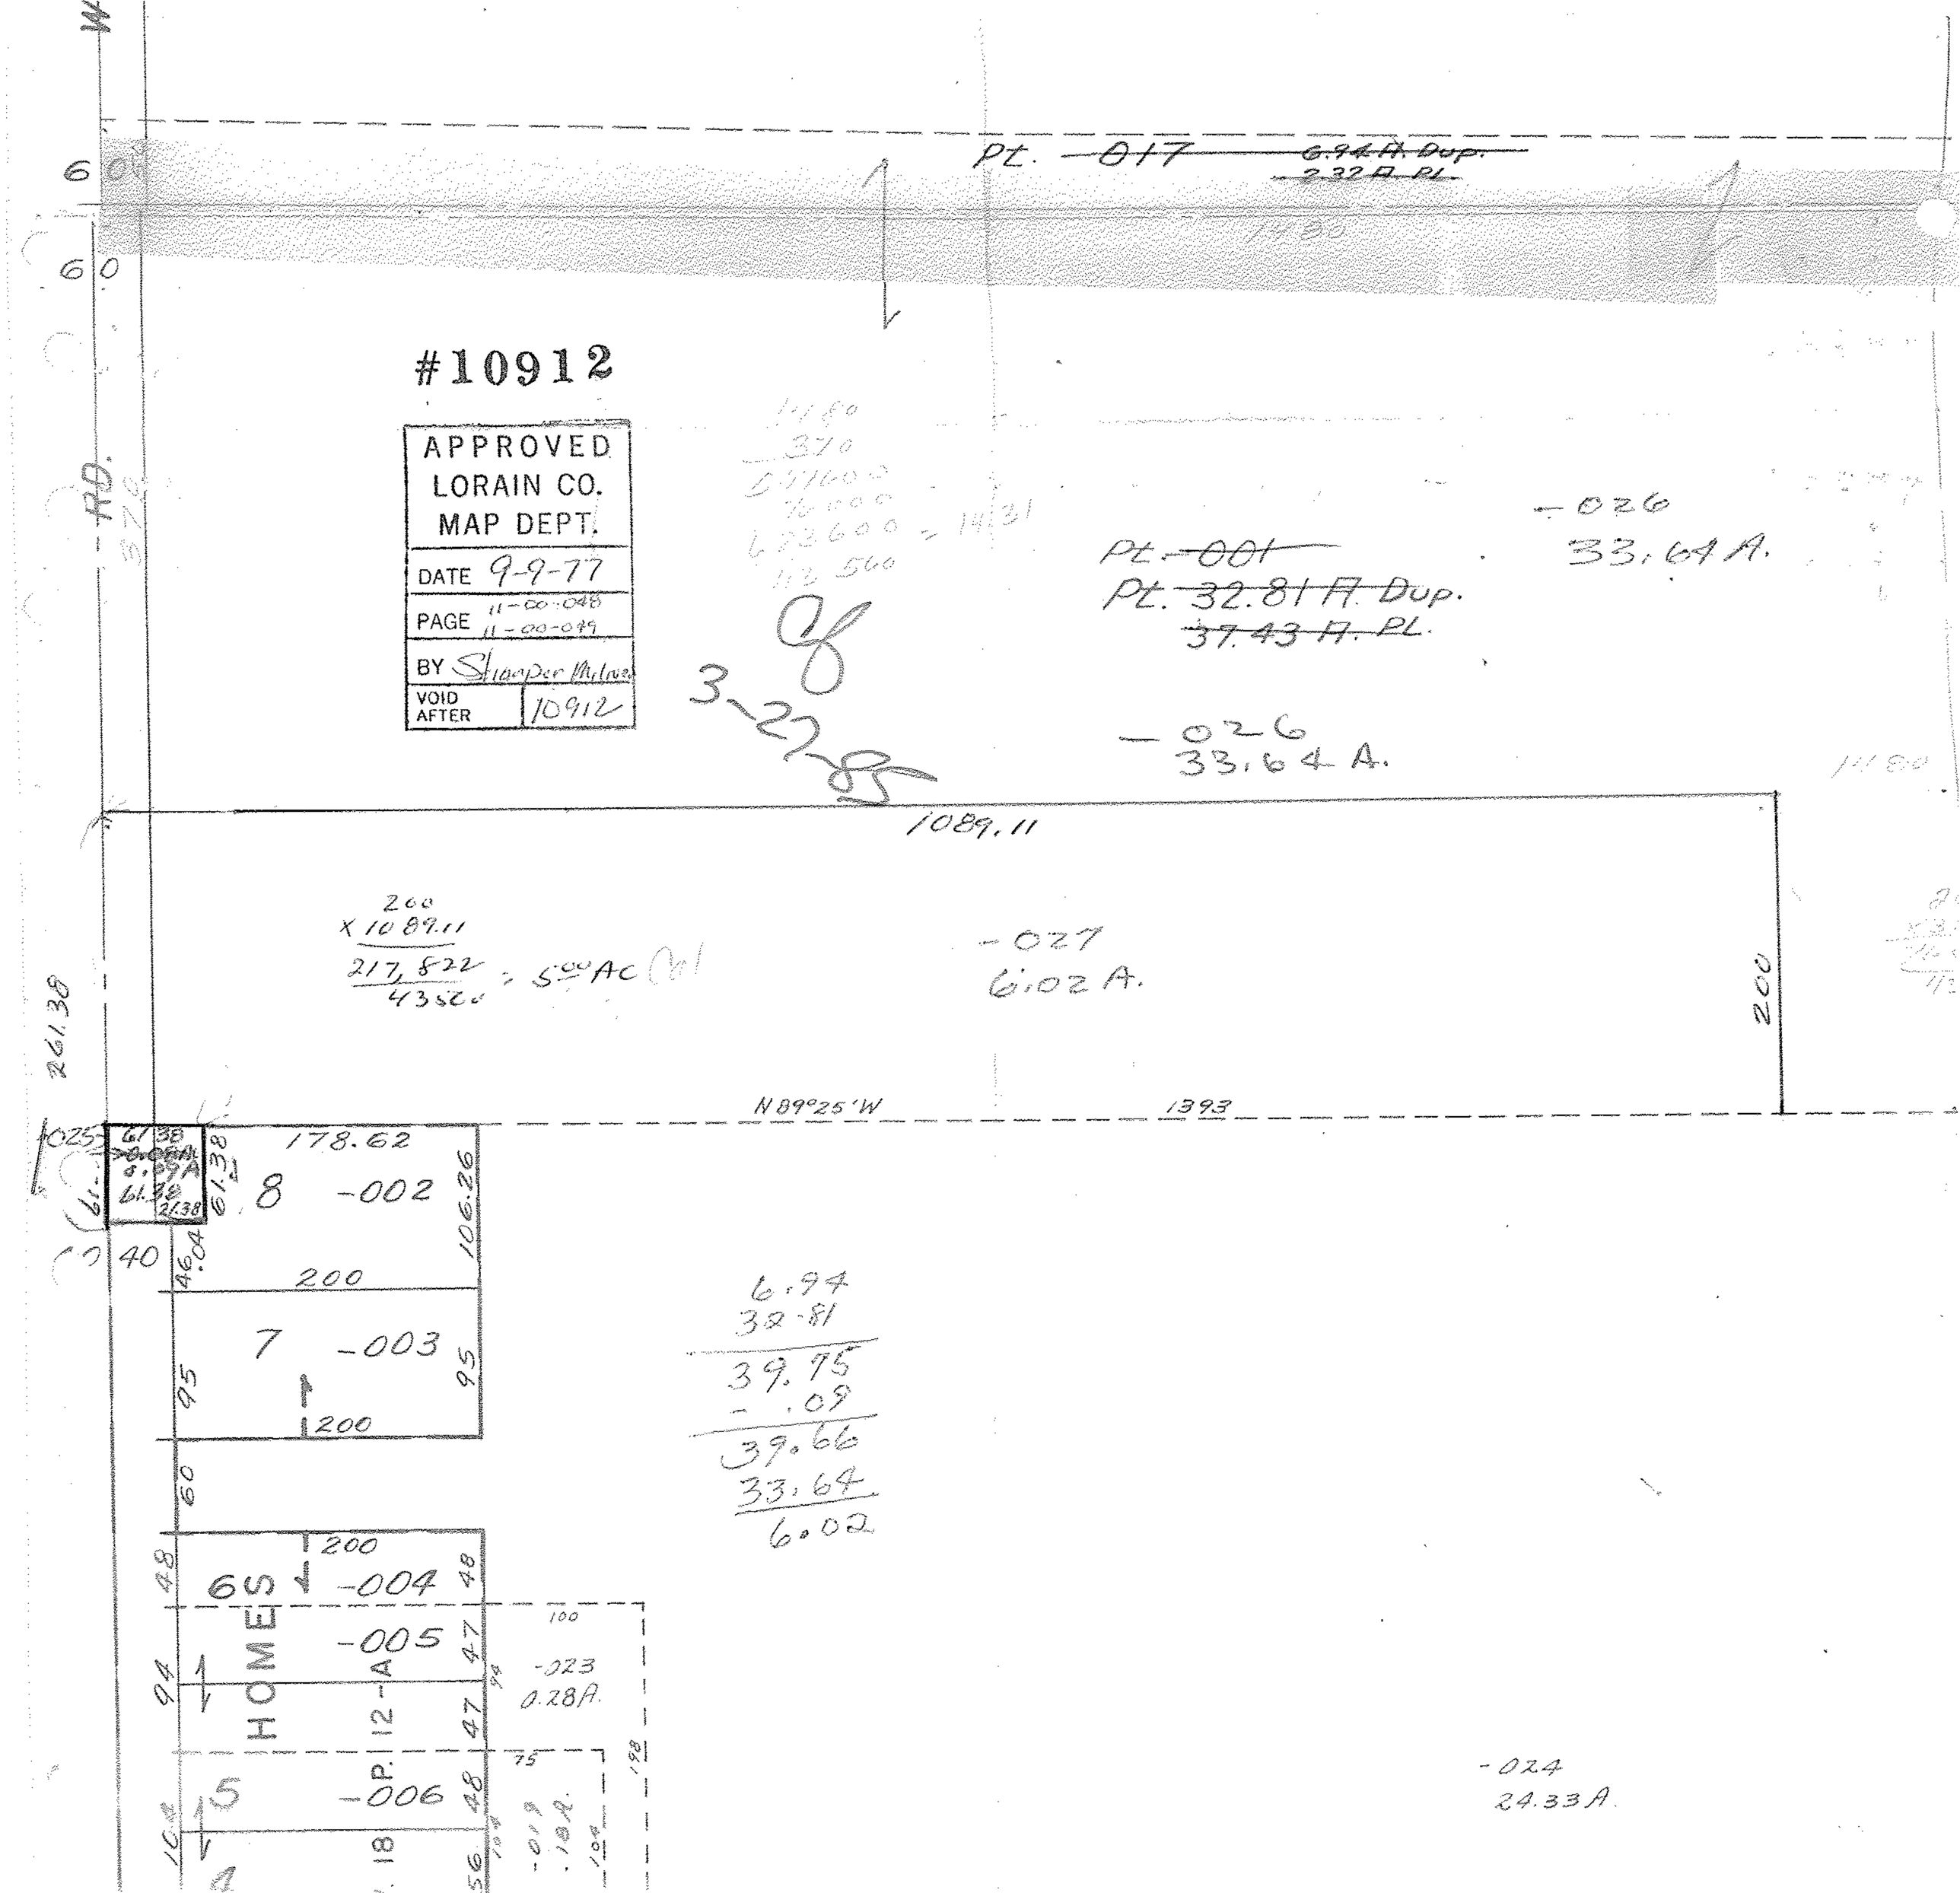

Pt. ~~017~~ ~~6.94 A. Dup.~~ ~~2.32 A. Pl.~~
#10912
APPROVED
LORAIN CO.
MAP DEPT.
DATE 9-9-77
PAGE 11-00-048 11-00-049
BY Stamper Milner
VOID AFTER 10912
3-27-85
Pt. ~~001~~
Pt. ~~32.81 A. Dup.~~
~~37.43 A. Pl.~~
-026
33.64 A.
-026
33.64 A.
1089.11
200
x 1089.11
217,822
43560 = 5.00 AC
-027
6.02 A.
N89°25'W
1393
178.62
8 -002
106.26
200
7 -003
95
200
6.94
32.81
39.75
- .09
39.66
33.64
6.02
200
6 -004
HOMES
-005
-023
0.28A.
5 -006
-024
24.33 A.