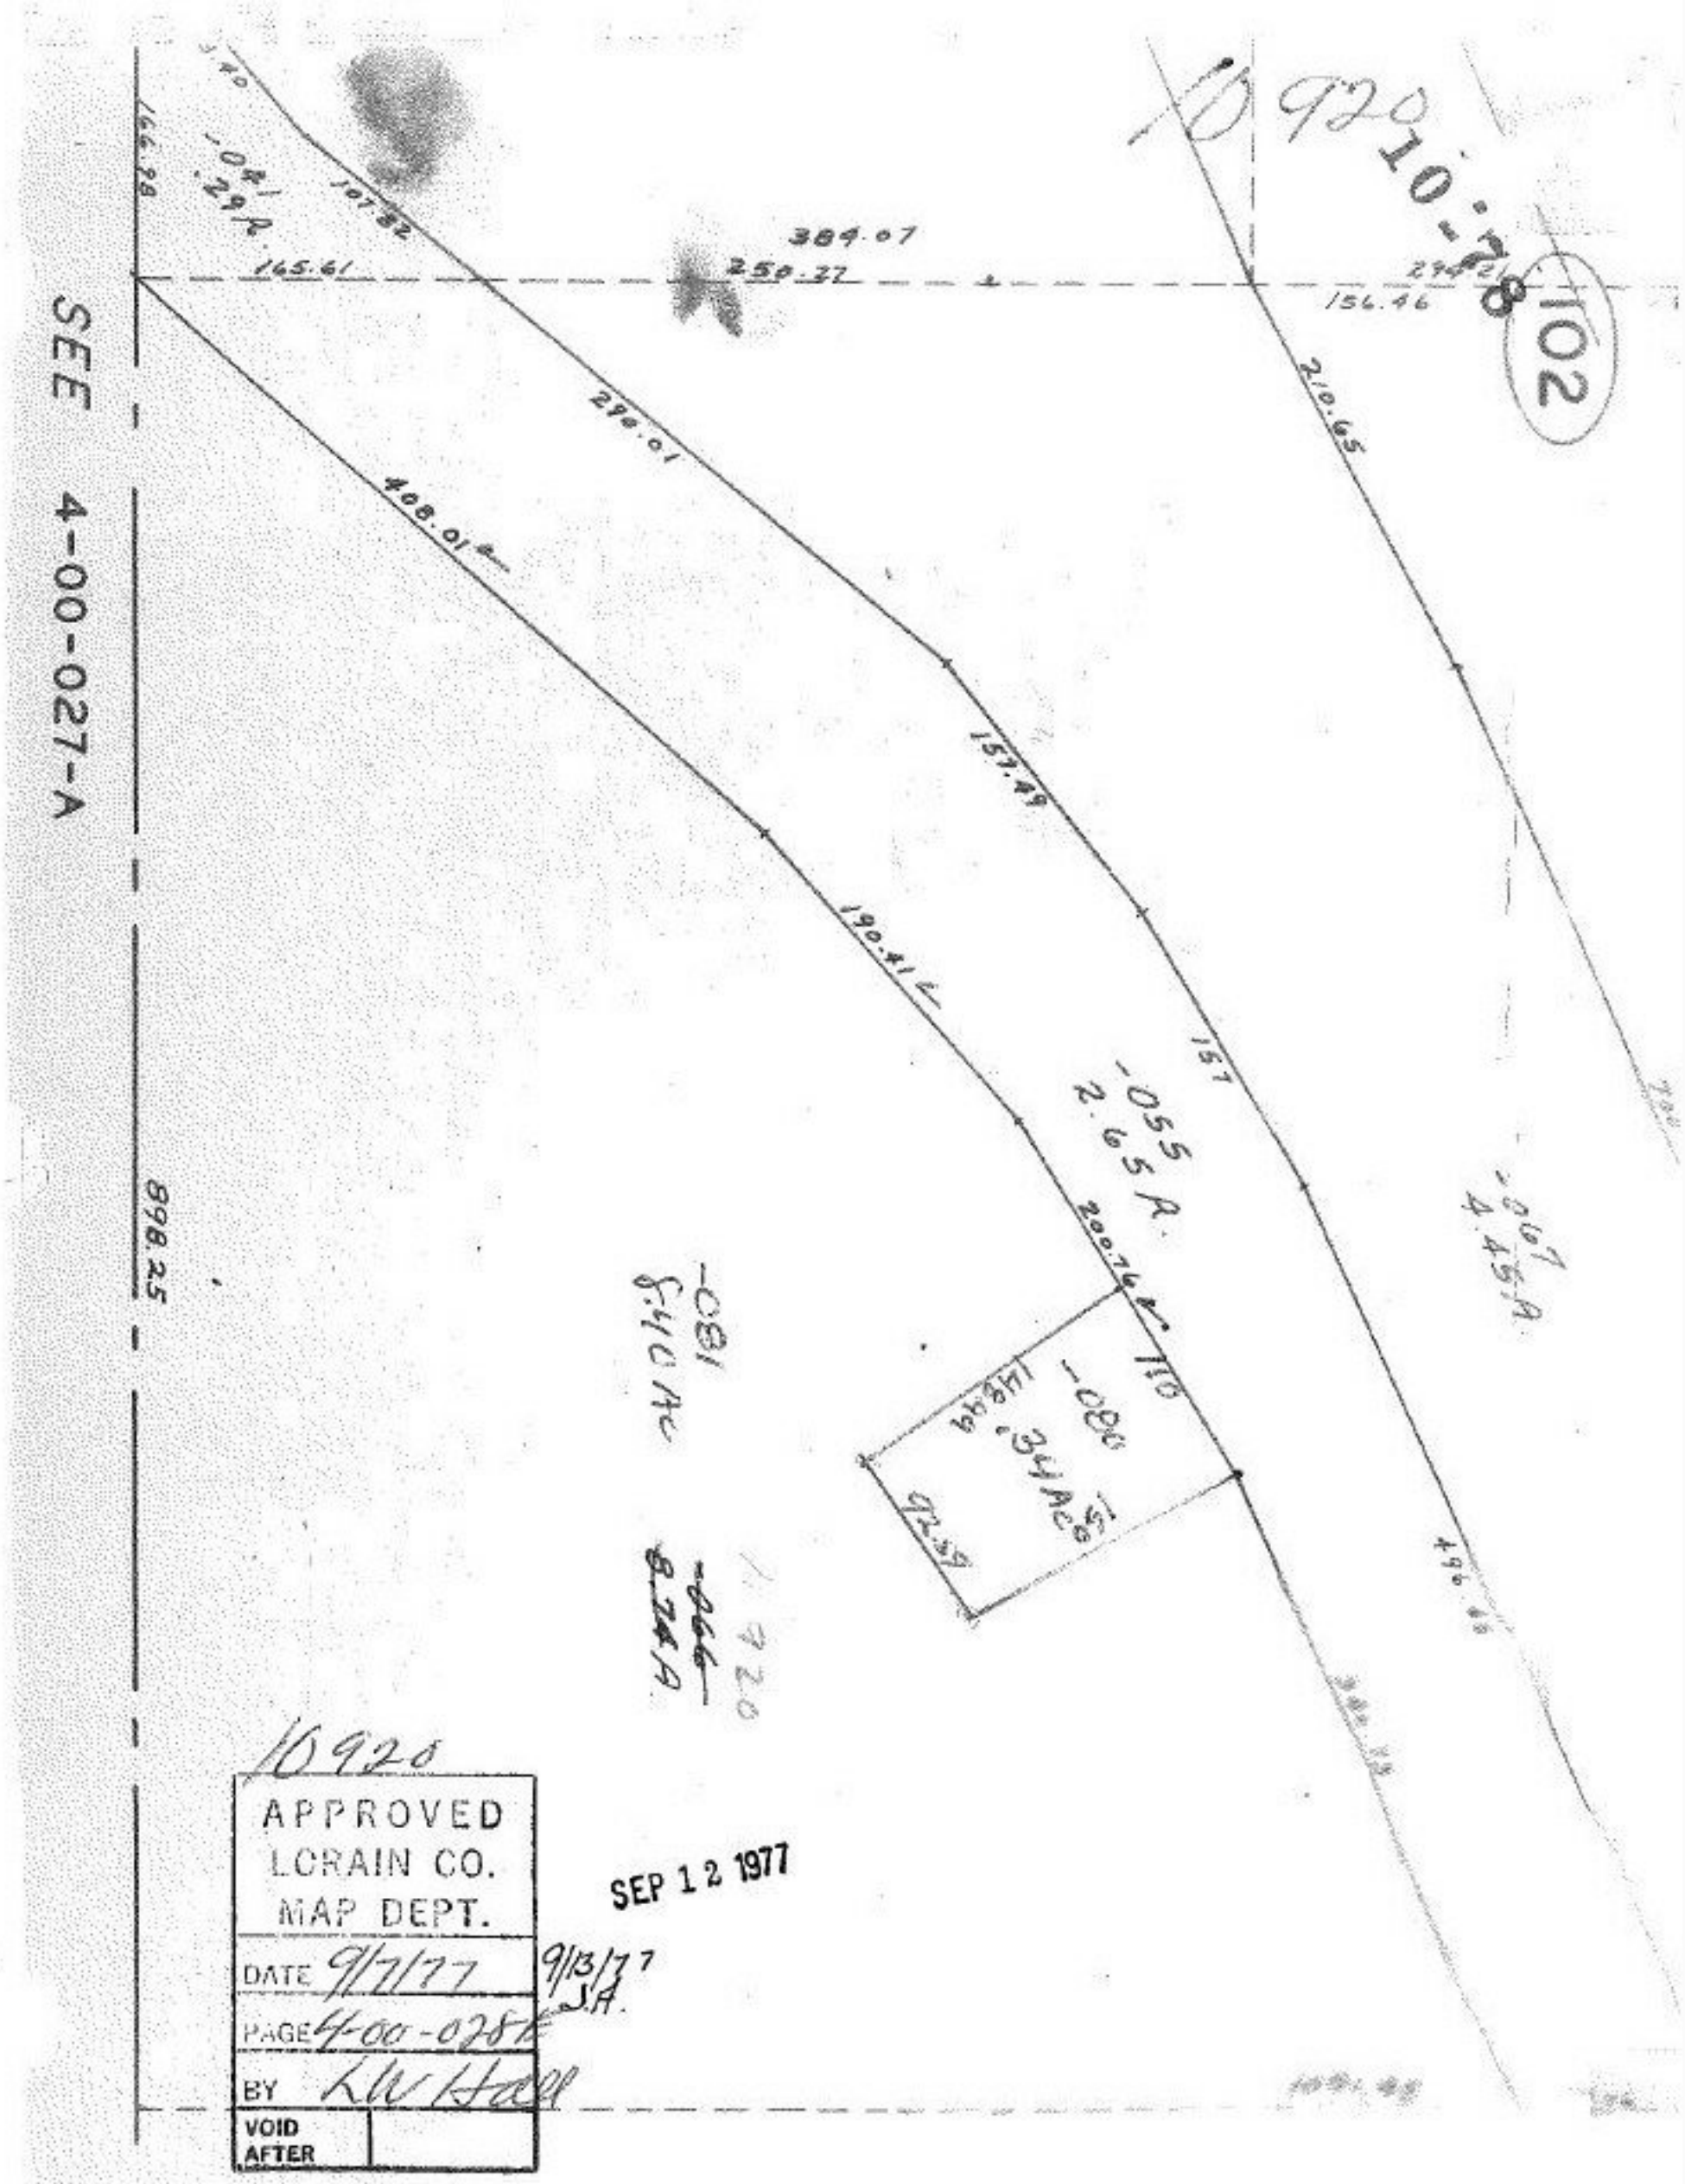

10920
10-78
102
SEE 4-00-027-A
384.07
250.27
165.61
156.46
294.21
166.98
107.82
290.01
408.01
210.65
157.49
190.41
157
-055
2.65 A.
-067
4.45 A.
200.76
110
-080
.34 Ac
148.44
150
92.59
-081
8.40 Ac
-066
8.74 A
898.25
496.46
10920
APPROVED
LORAIN CO.
MAP DEPT.
DATE 9/7/77
PAGE 4-00-028
BY LW Hall
VOID AFTER
SEP 12 1977
9/13/77
J.A.