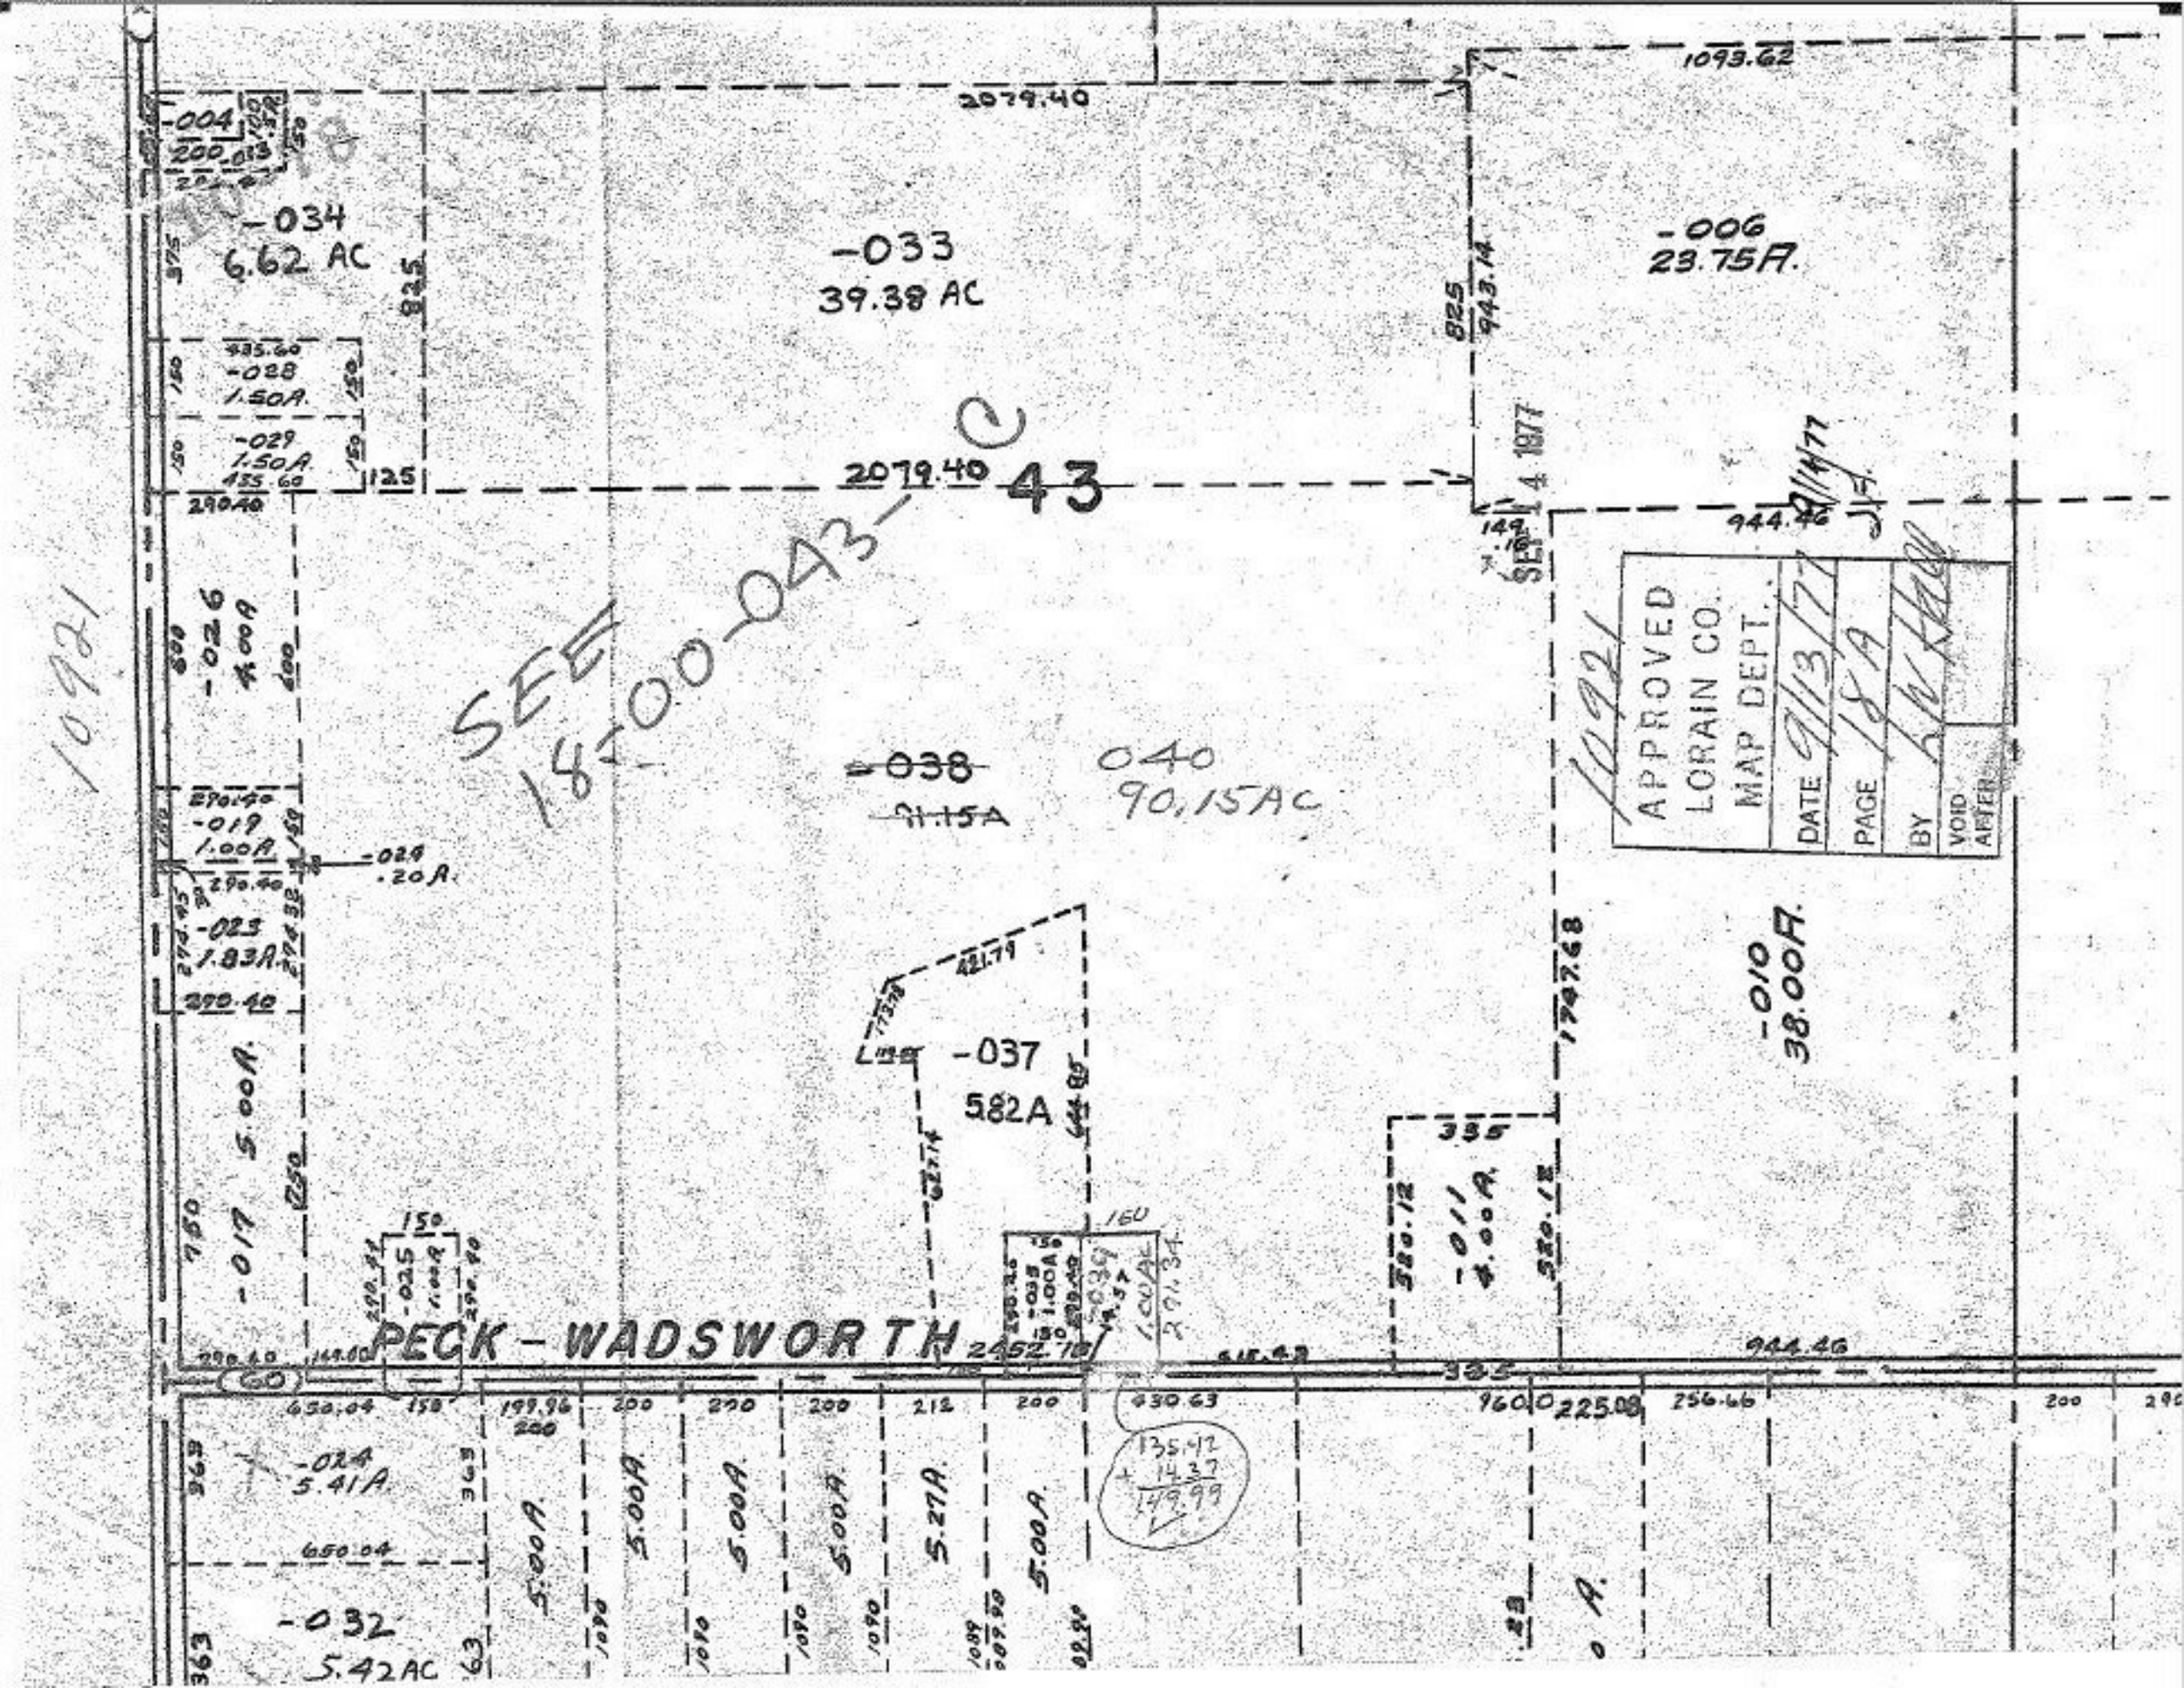

10921
-034
6.62 AC
-033
39.38 AC
-006
23.75A.
2079.40
1093.62
2079.40
43
SEE 18-00-043-C
~~-038~~
~~91.15A~~
040
90.15AC
-037
5.82A
-010
38.00A.
-017
5.00A.
-024
5.41A.
-032
5.42AC
PECK - WADSWORTH
2452.18
944.46
1747.68
APPROVED
LORAIN CO.
MAP DEPT.
DATE 9/13/77
PAGE 18A
BY
VOID AFTER