10931

1.07
47
.60

#10931

APPROVED
LORAIN CO.
MAP DEPT.

DATE 9-12-77

PAGE 4-00-011-H

BY S. Milne

VOID AFTER 10931
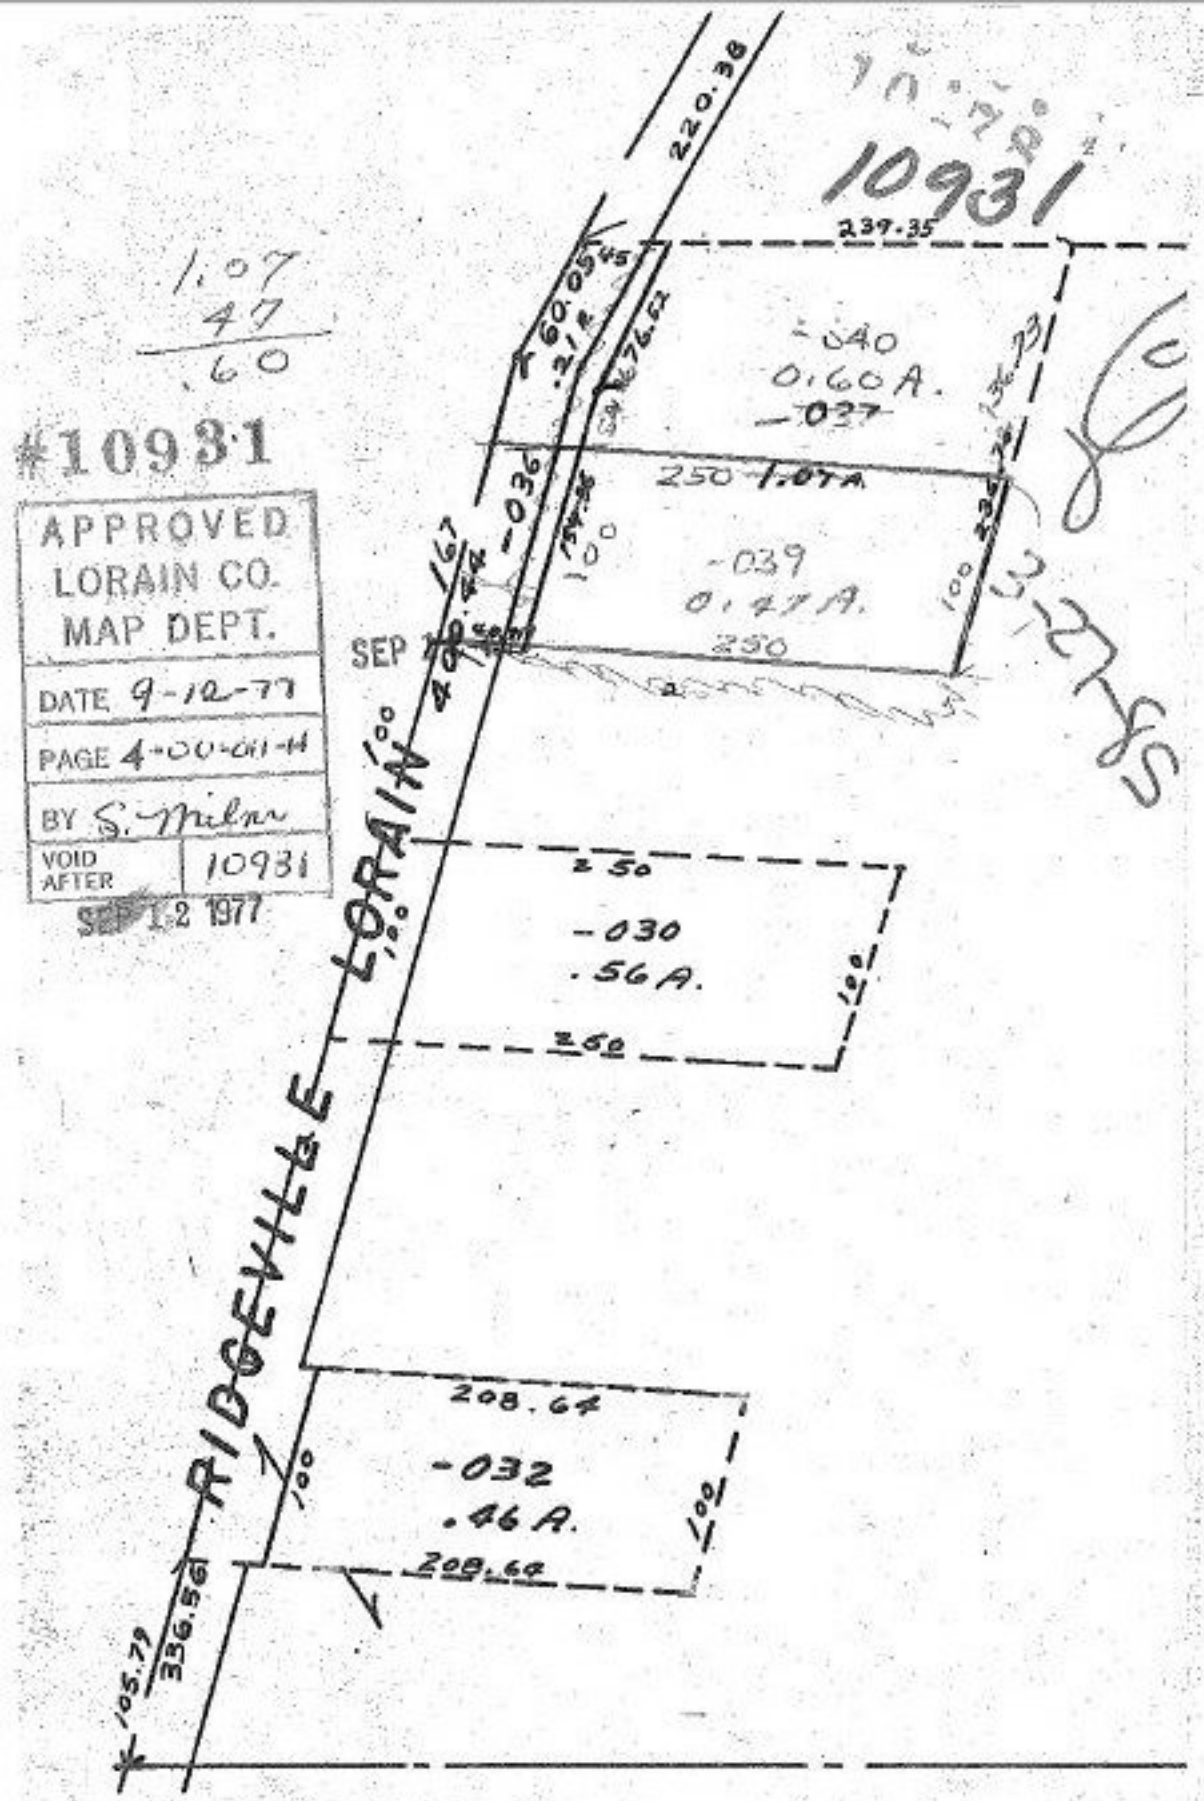
SEP 12 1977