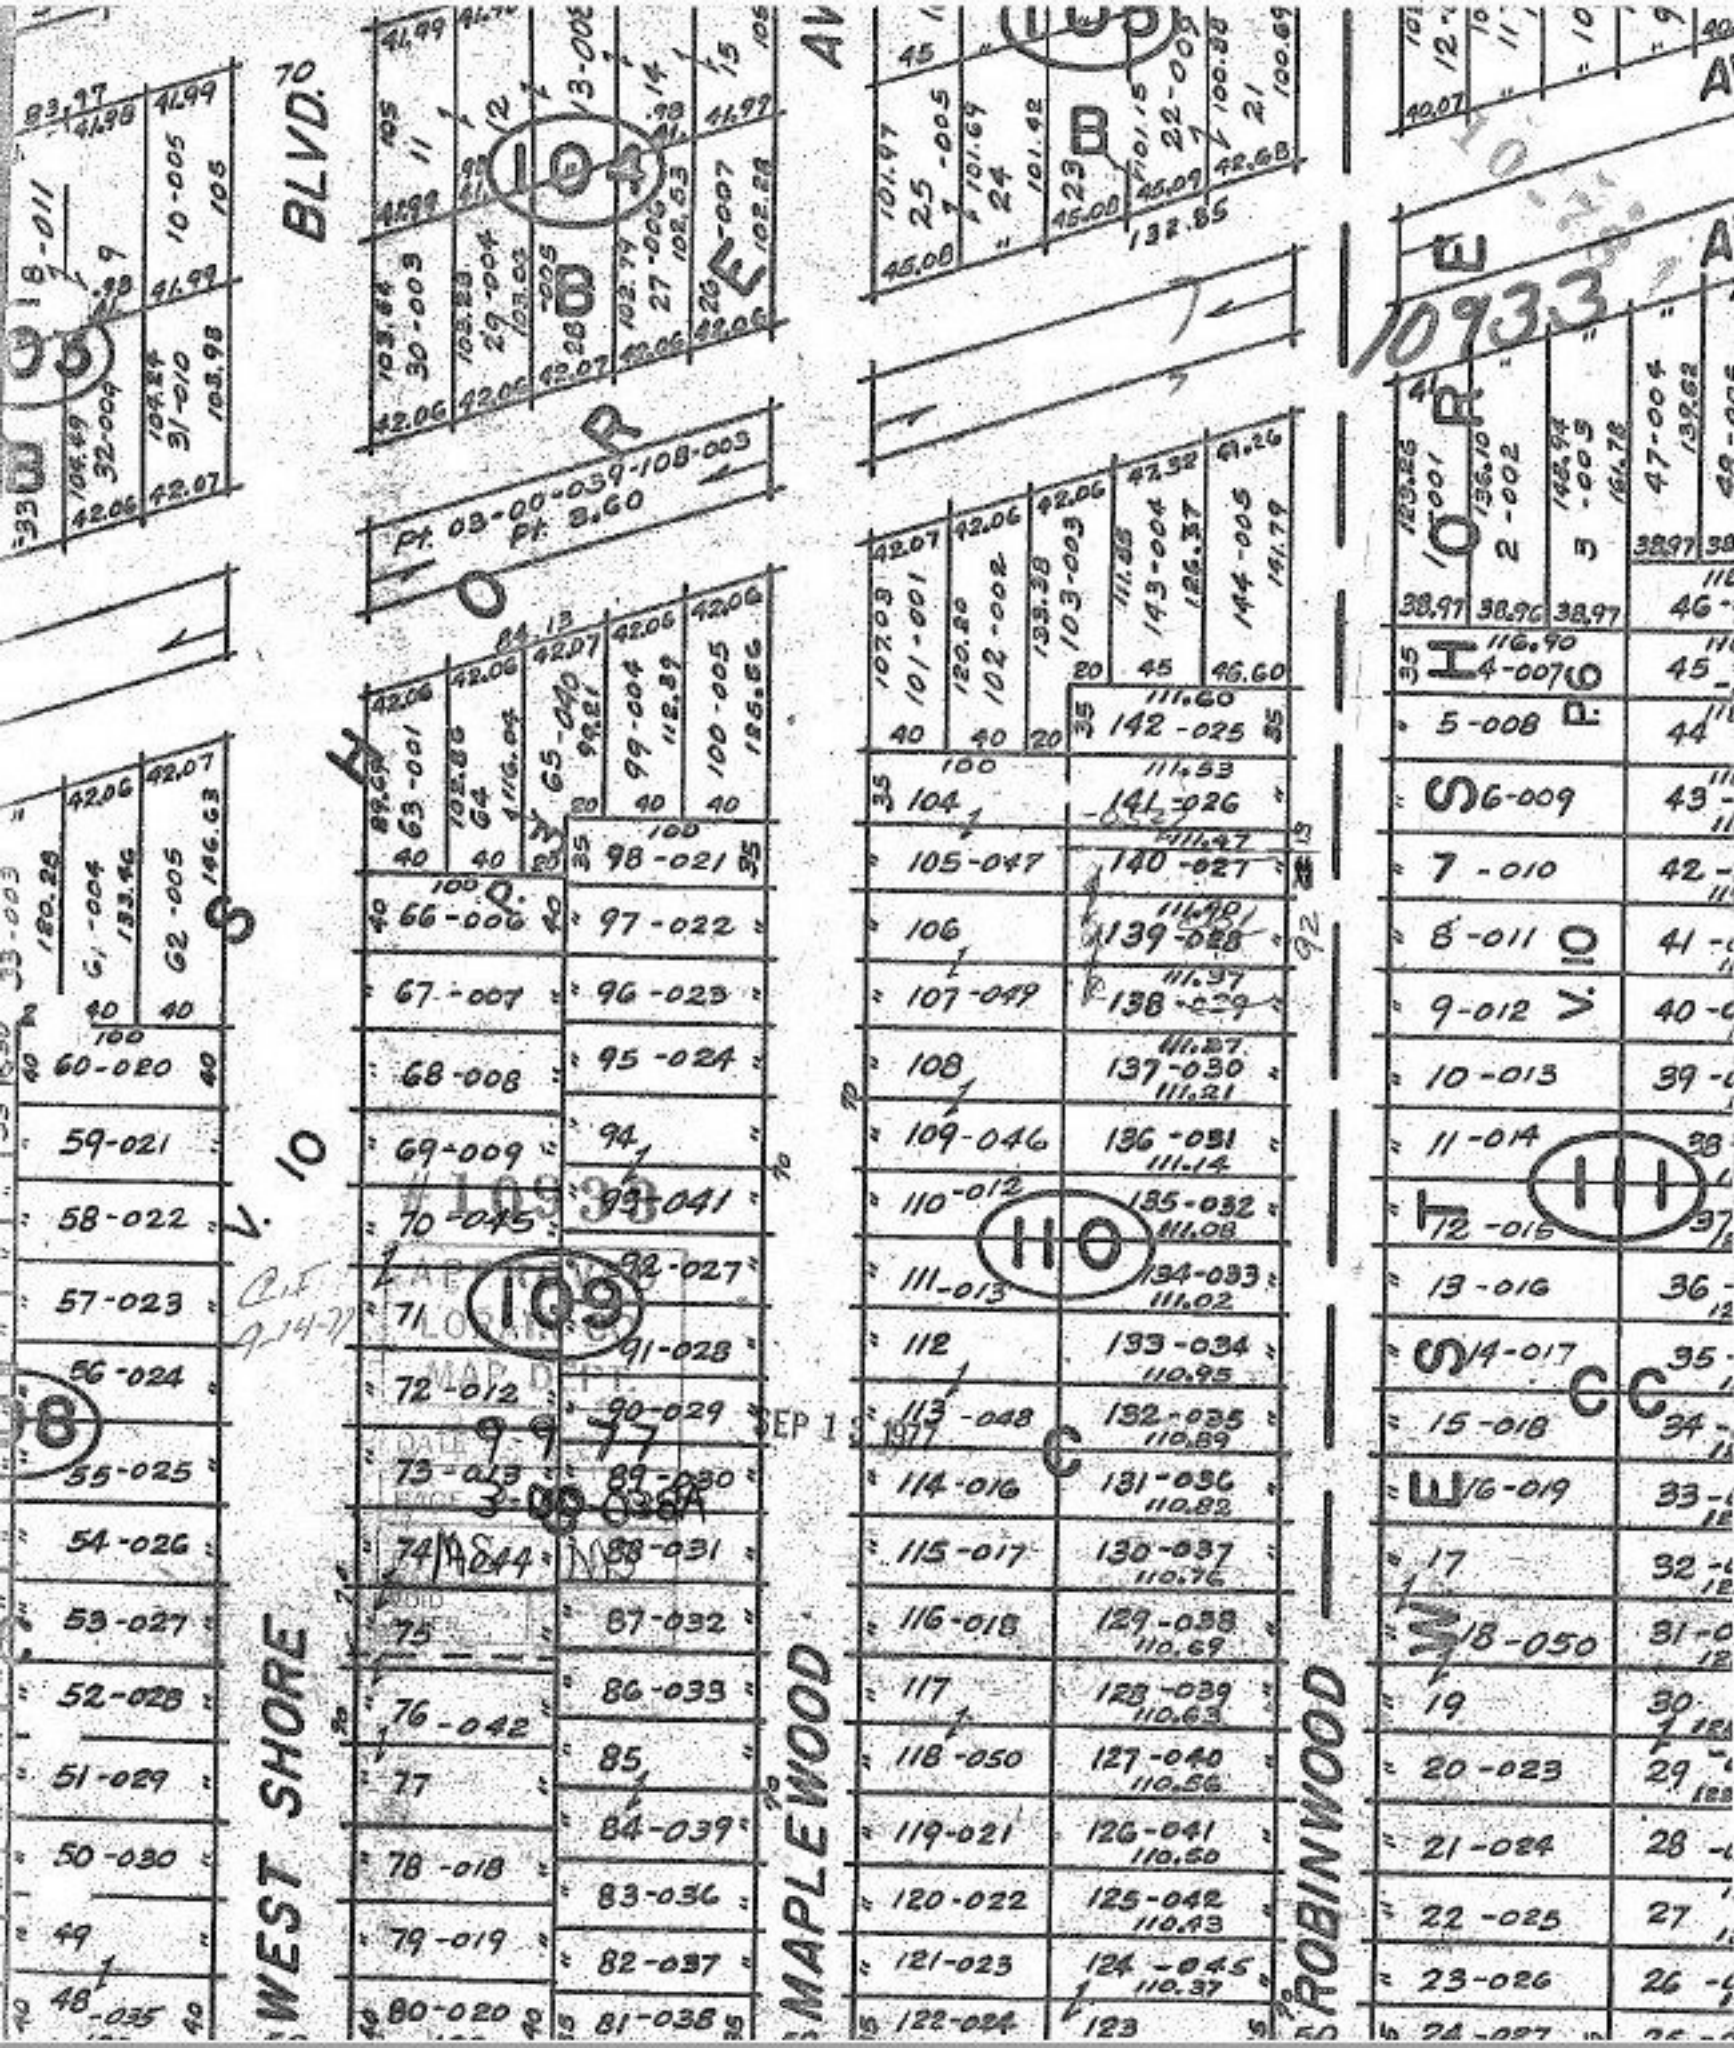

BLVD.
WEST SHORE
MAPLEWOOD
ROBINWOOD
104
109
110
111
10933
Pt. 03-00-039-108-003
Pt. 3.60
#10933
SEP 13 1977