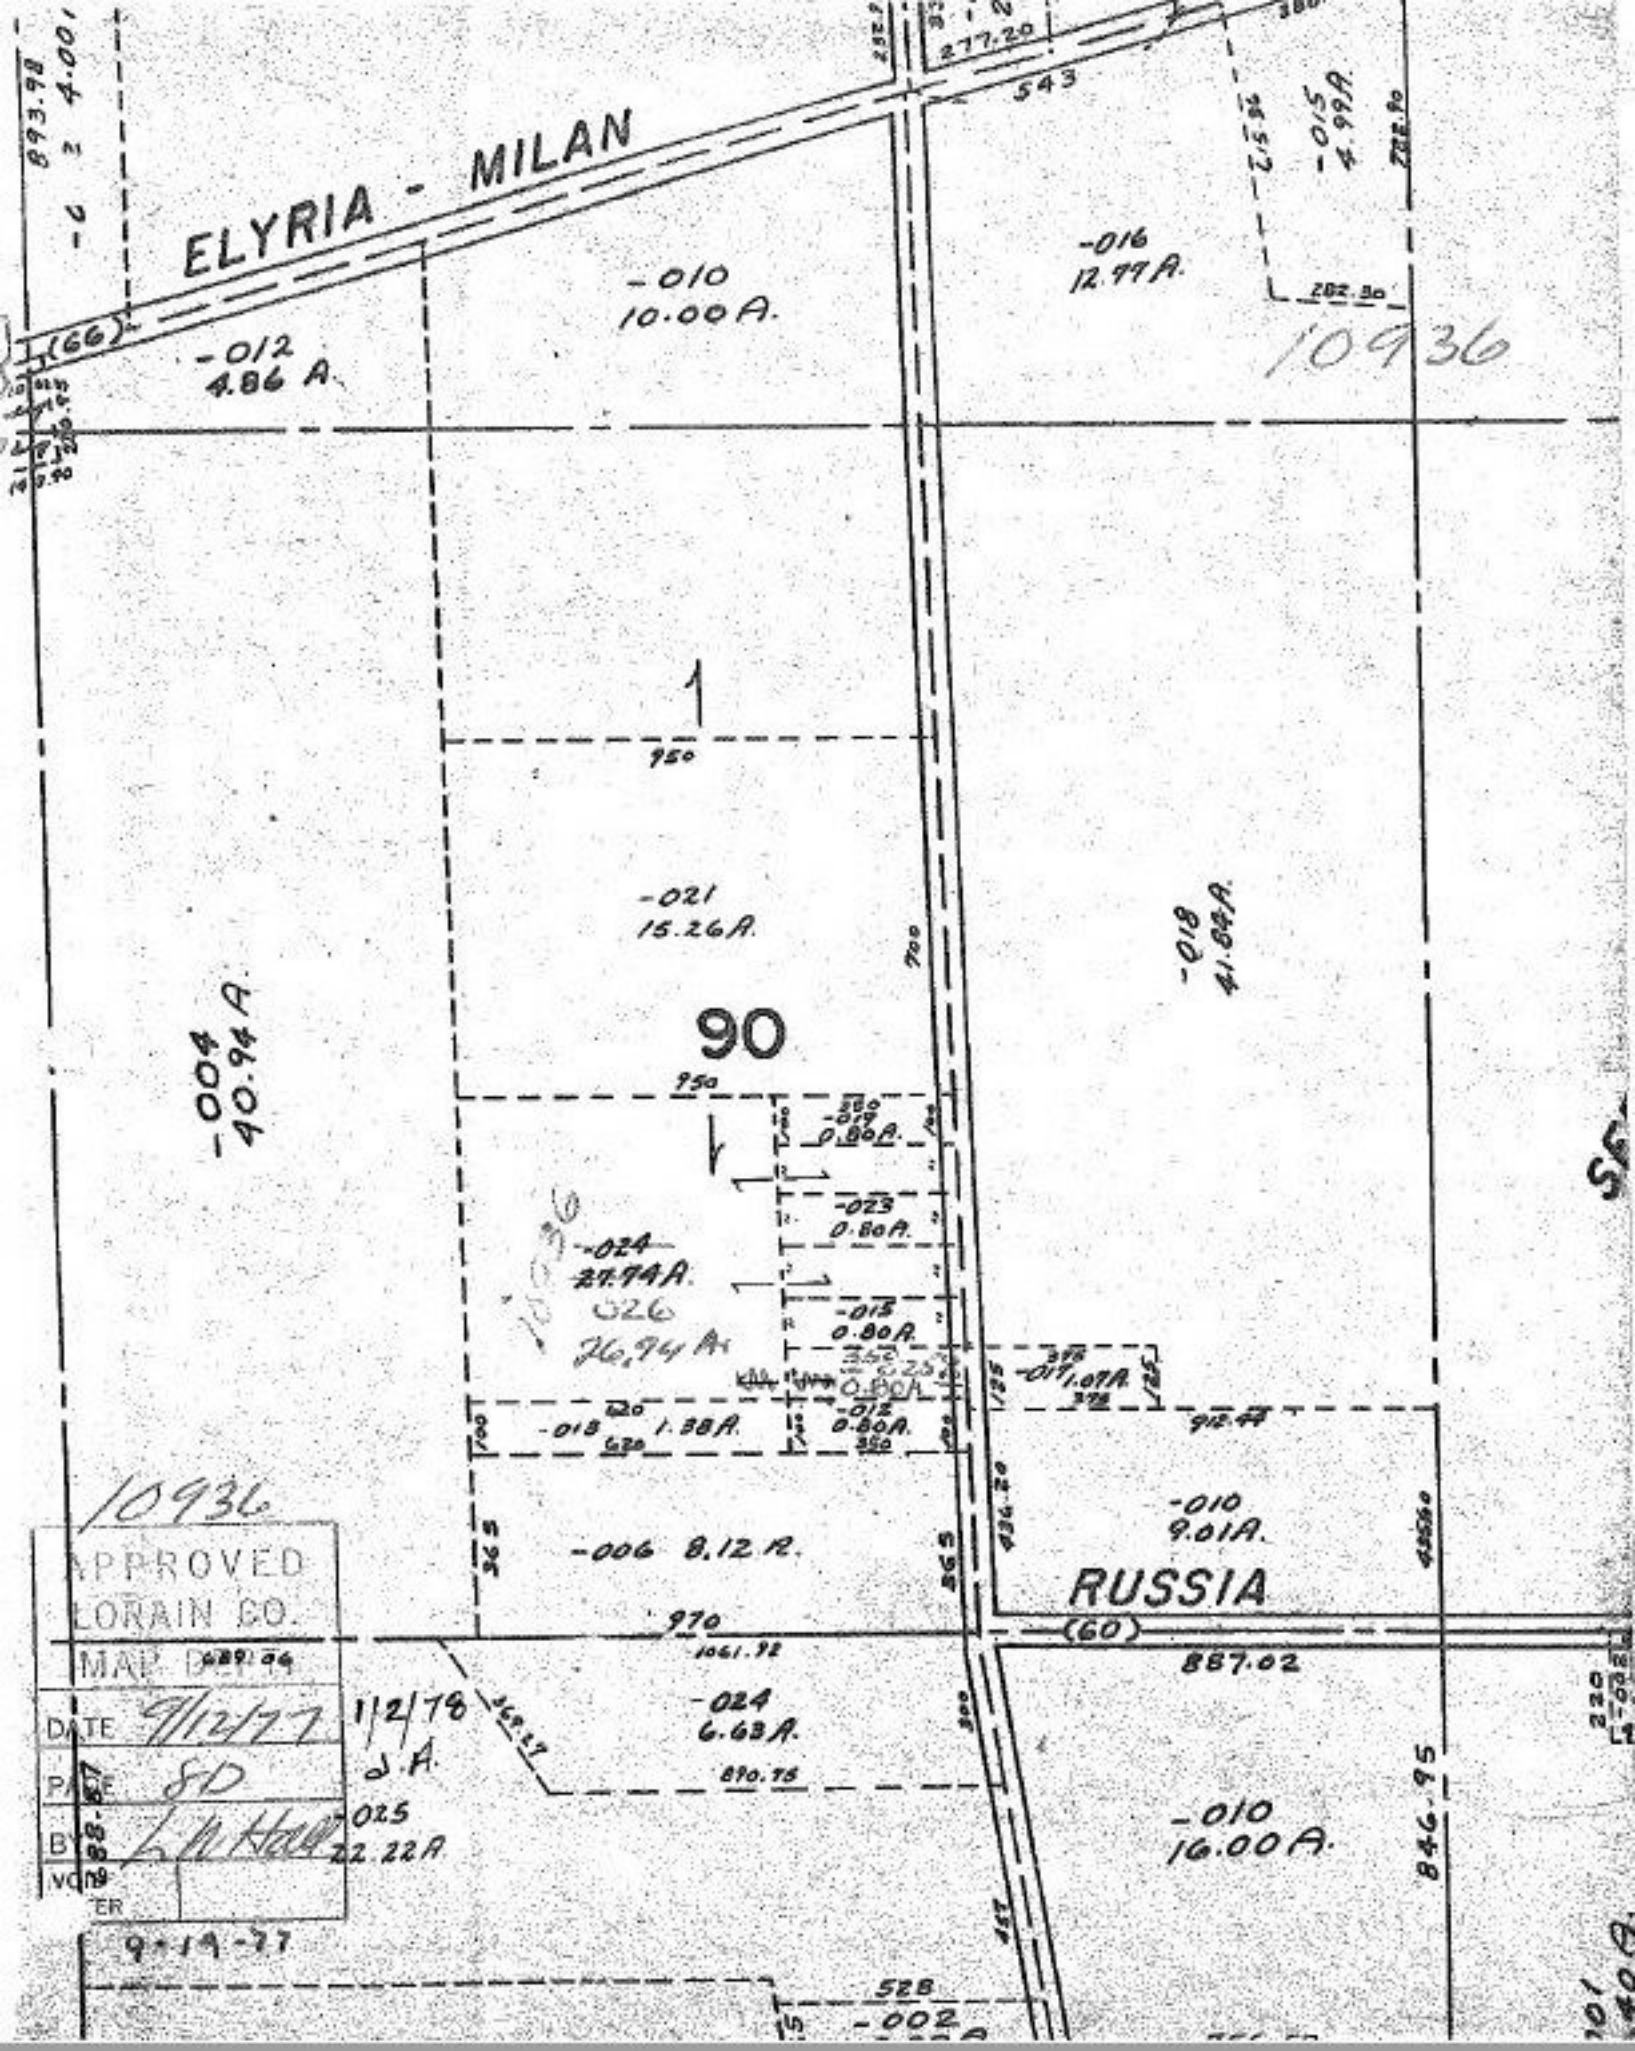
ELYRIA - MILAN
(66)
543
277.20
-010
10.00 A.
-012
4.86 A.
-016
12.99 A.
-015
4.99 A.
282.80
10936
1
950
-021
15.26 A.
700
-018
41.84 A.
-004
40.94 A.
90
950
-019
0.80 A.
-023
0.80 A.
-024
27.94 A.
026
26.94 Ac
-013
0.80 A.
-017
1.07 A.
-012
0.80 A.
-018
1.38 A.
912.44
-010
9.01 A.
-006 8.12 A.
970
1061.92
RUSSIA
(60)
887.02
-024
6.63 A.
810.75
-025
22.22 A.
-010
16.00 A.
846.95
528
-002
10936
APPROVED
LORAIN CO.
MAP DEPT
DATE 9/12/77 1/2/78
PAGE 80
BY L.A. Hall J.A.
VOL
ER
9-19-77