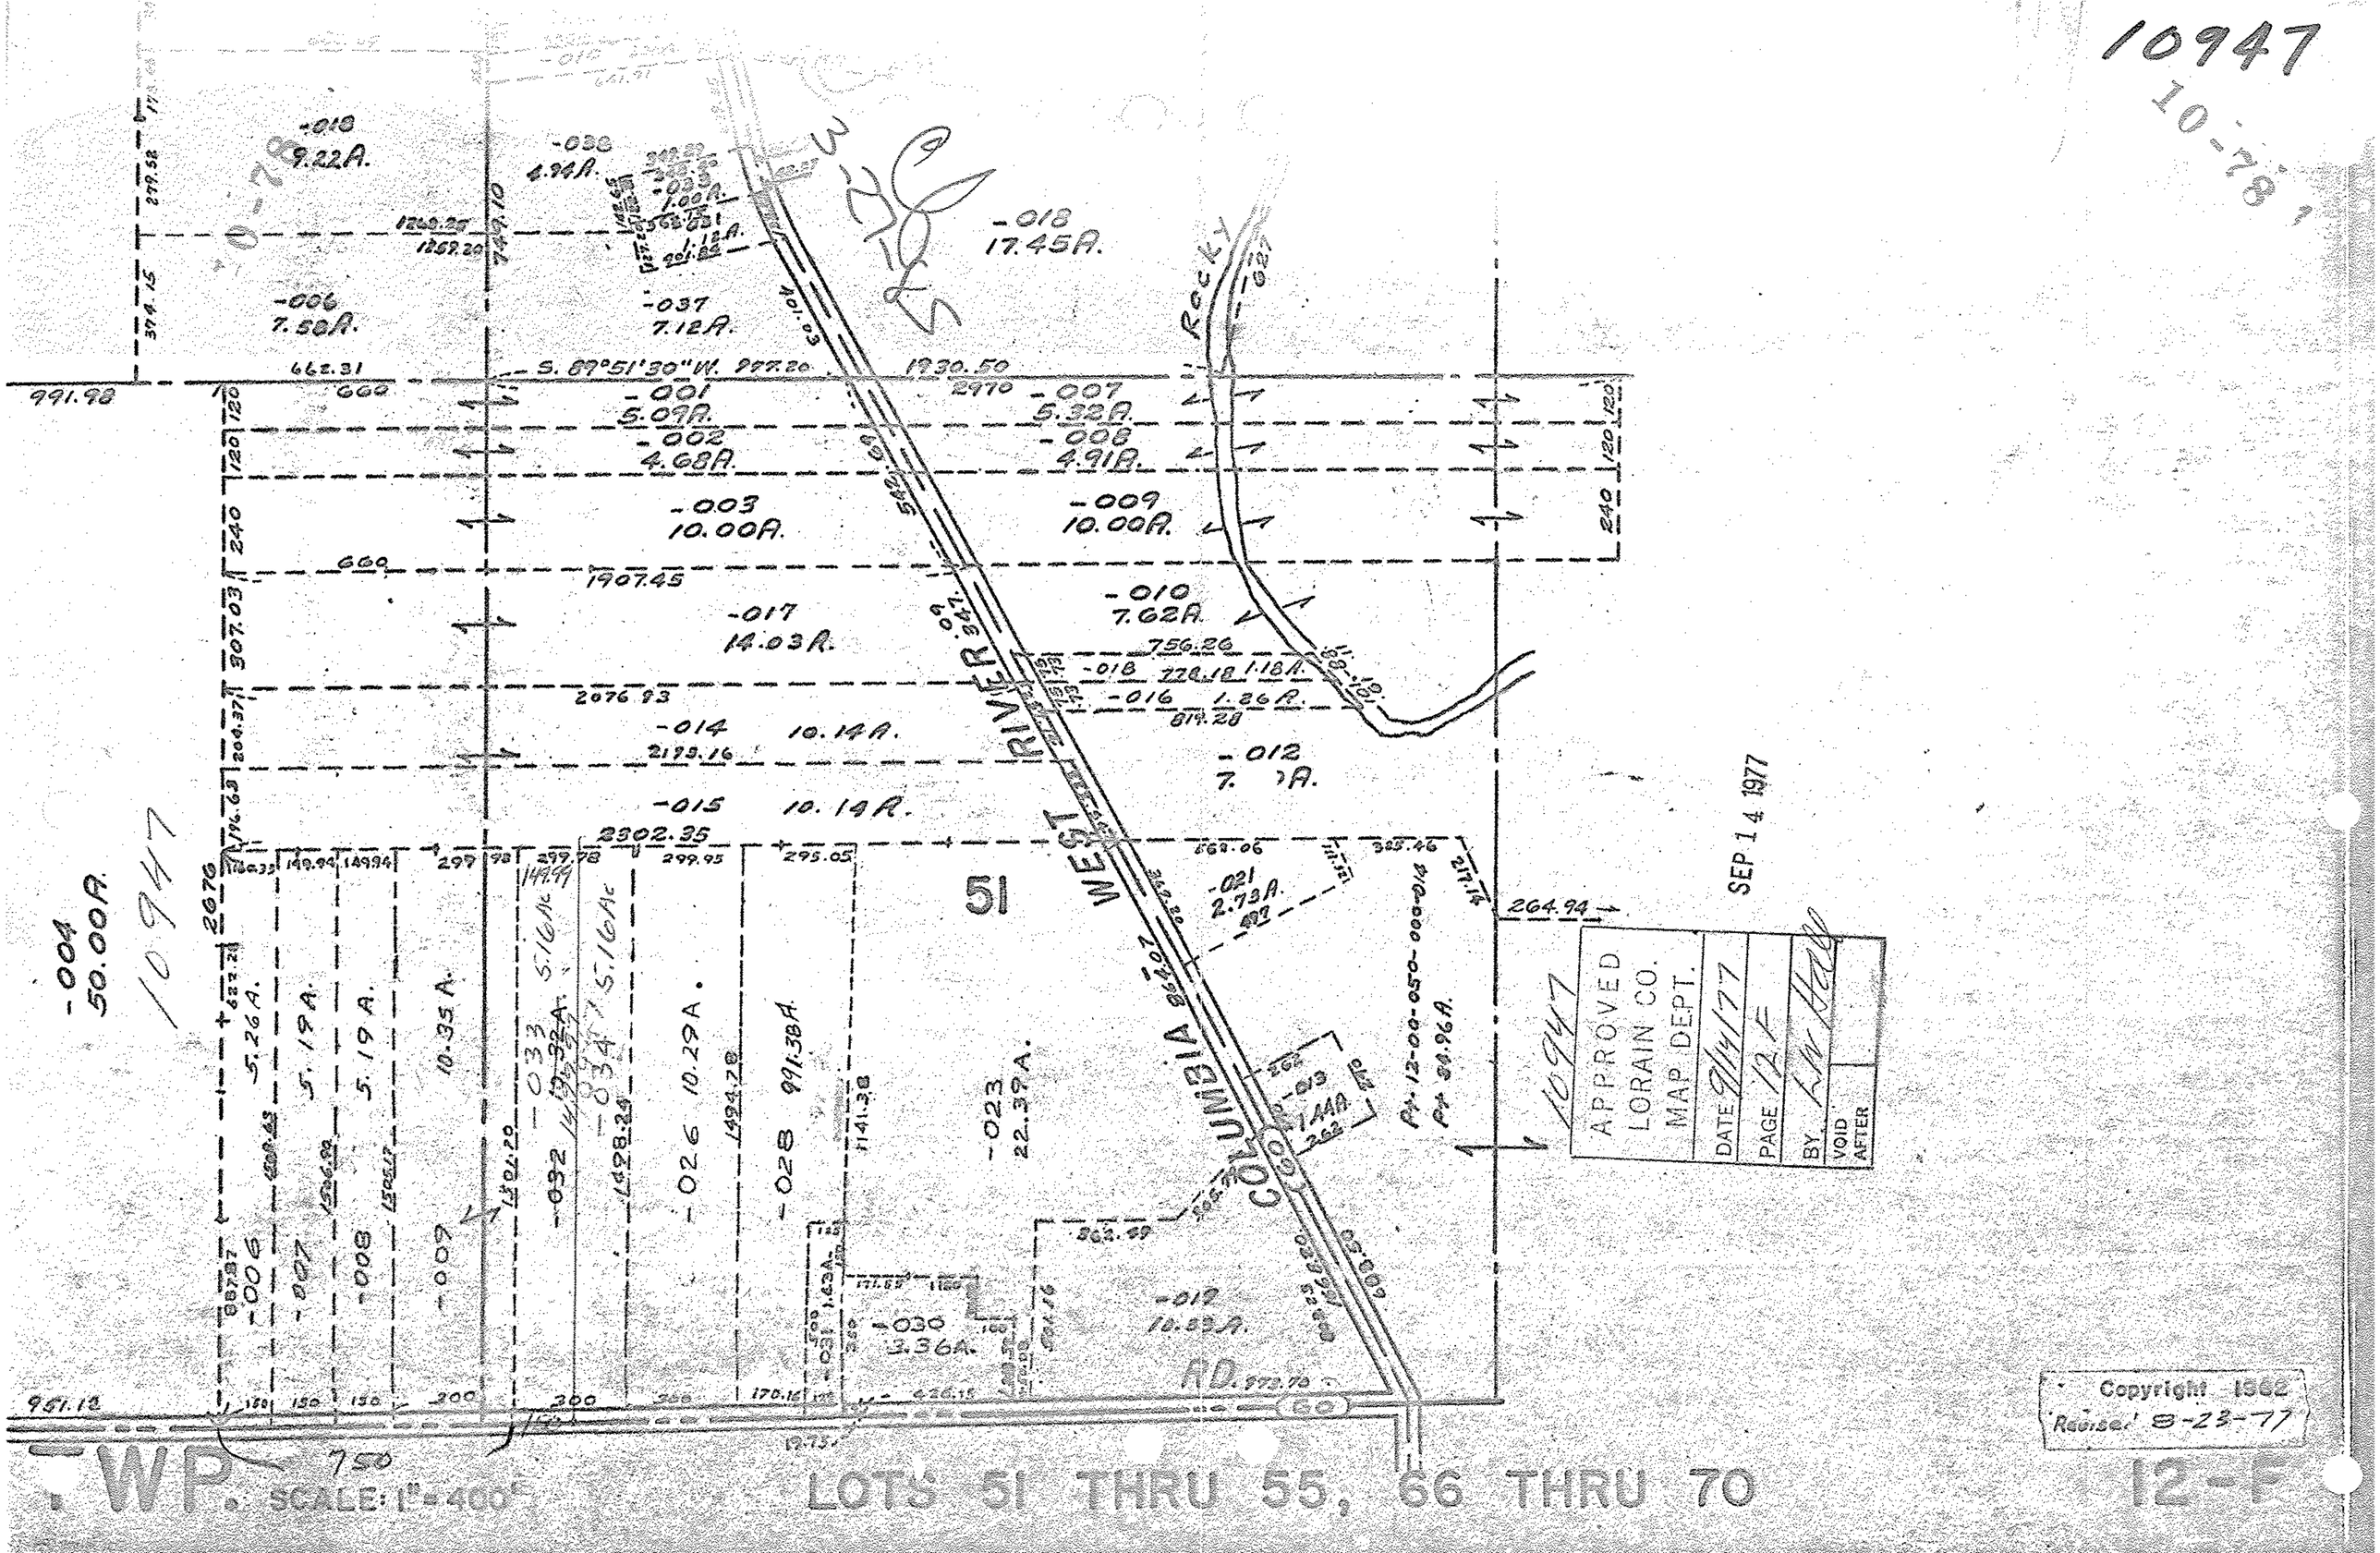
10947
10-78
-018
9.22A.
-038
4.94A.
-018
17.45A.
-006
7.58A.
-037
7.12A.
S. 89°51'30"W. 977.20
1930.50
2970
991.98
-001
5.09A.
-007
5.32A.
-002
4.68A.
-008
4.91A.
-003
10.00A.
-009
10.00A.
1907.45
-017
14.03A.
-010
7.62A.
756.26
-018
778.18
1.18A.
-016
1.26A.
819.28
2076.93
-014
10.14A.
2193.16
-012
-015
10.14A.
2302.35
51
-021
2.73A.
264.94
-004
50.00A.
10947
5.26A.
5.19A.
5.19A.
10.35A.
-033
5.16Ac
-034
5.16Ac
-032
-026
10.29A.
-028
991.38A.
-023
22.39A.
-013
1.44A.
-006
-007
-008
-009
-030
3.36A.
-019
10.33A.
RD.
951.12
750
SEP 14 1977
APPROVED
LORAIN CO.
MAP DEPT.
DATE 9/14/77
PAGE 12F
BY
VOID AFTER
Copyright 1962
Revised 8-23-77
TWP.
SCALE: 1"=400'
LOTS 51 THRU 55, 66 THRU 70
12-F