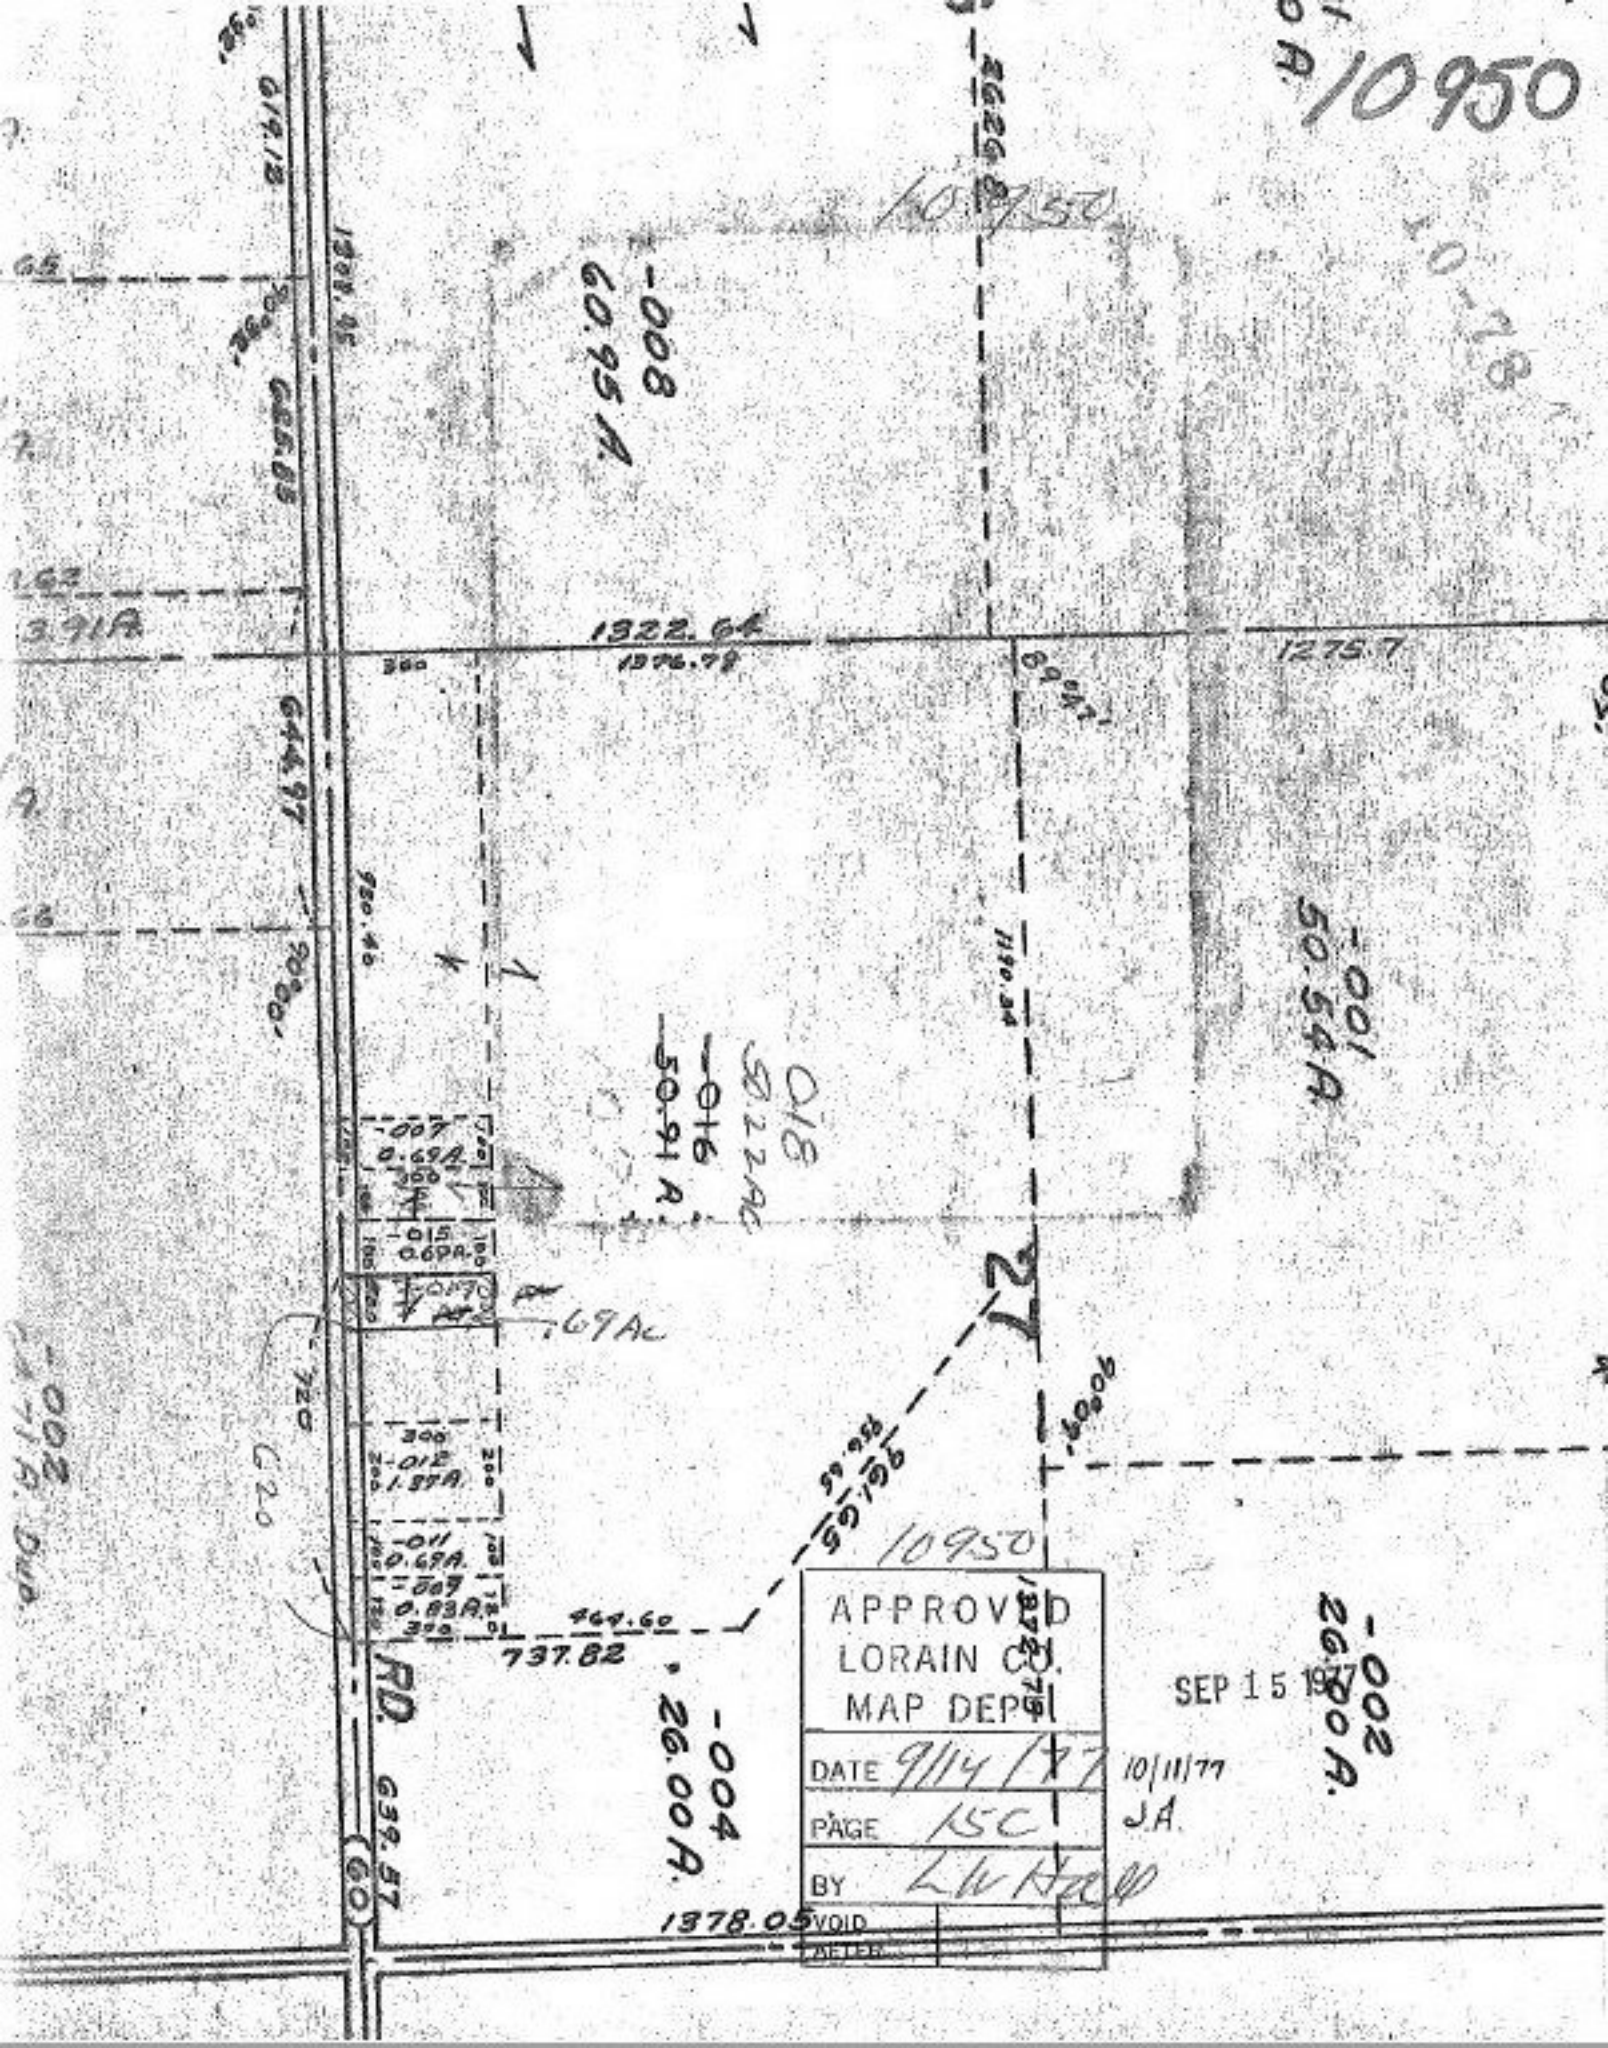
10950
10950
-008
60.95 A.
1322.64
1376.78
1275.7
-001
50.54 A.
-016
50.91 A.
-007
0.69A.
-015
0.69A.
.69Ac
-012
1.37A.
-011
0.69A.
-007
0.83A.
464.60
737.82
-004
26.00 A.
-002
26.00 A.
1378.05
RD.
639.57
(60)
APPROVED
LORAIN CO.
MAP DEPT.
DATE 9/14/77
PAGE 15C
BY LW Hall
VOID
AFTER
SEP 15 1977
10/11/77
J.A.