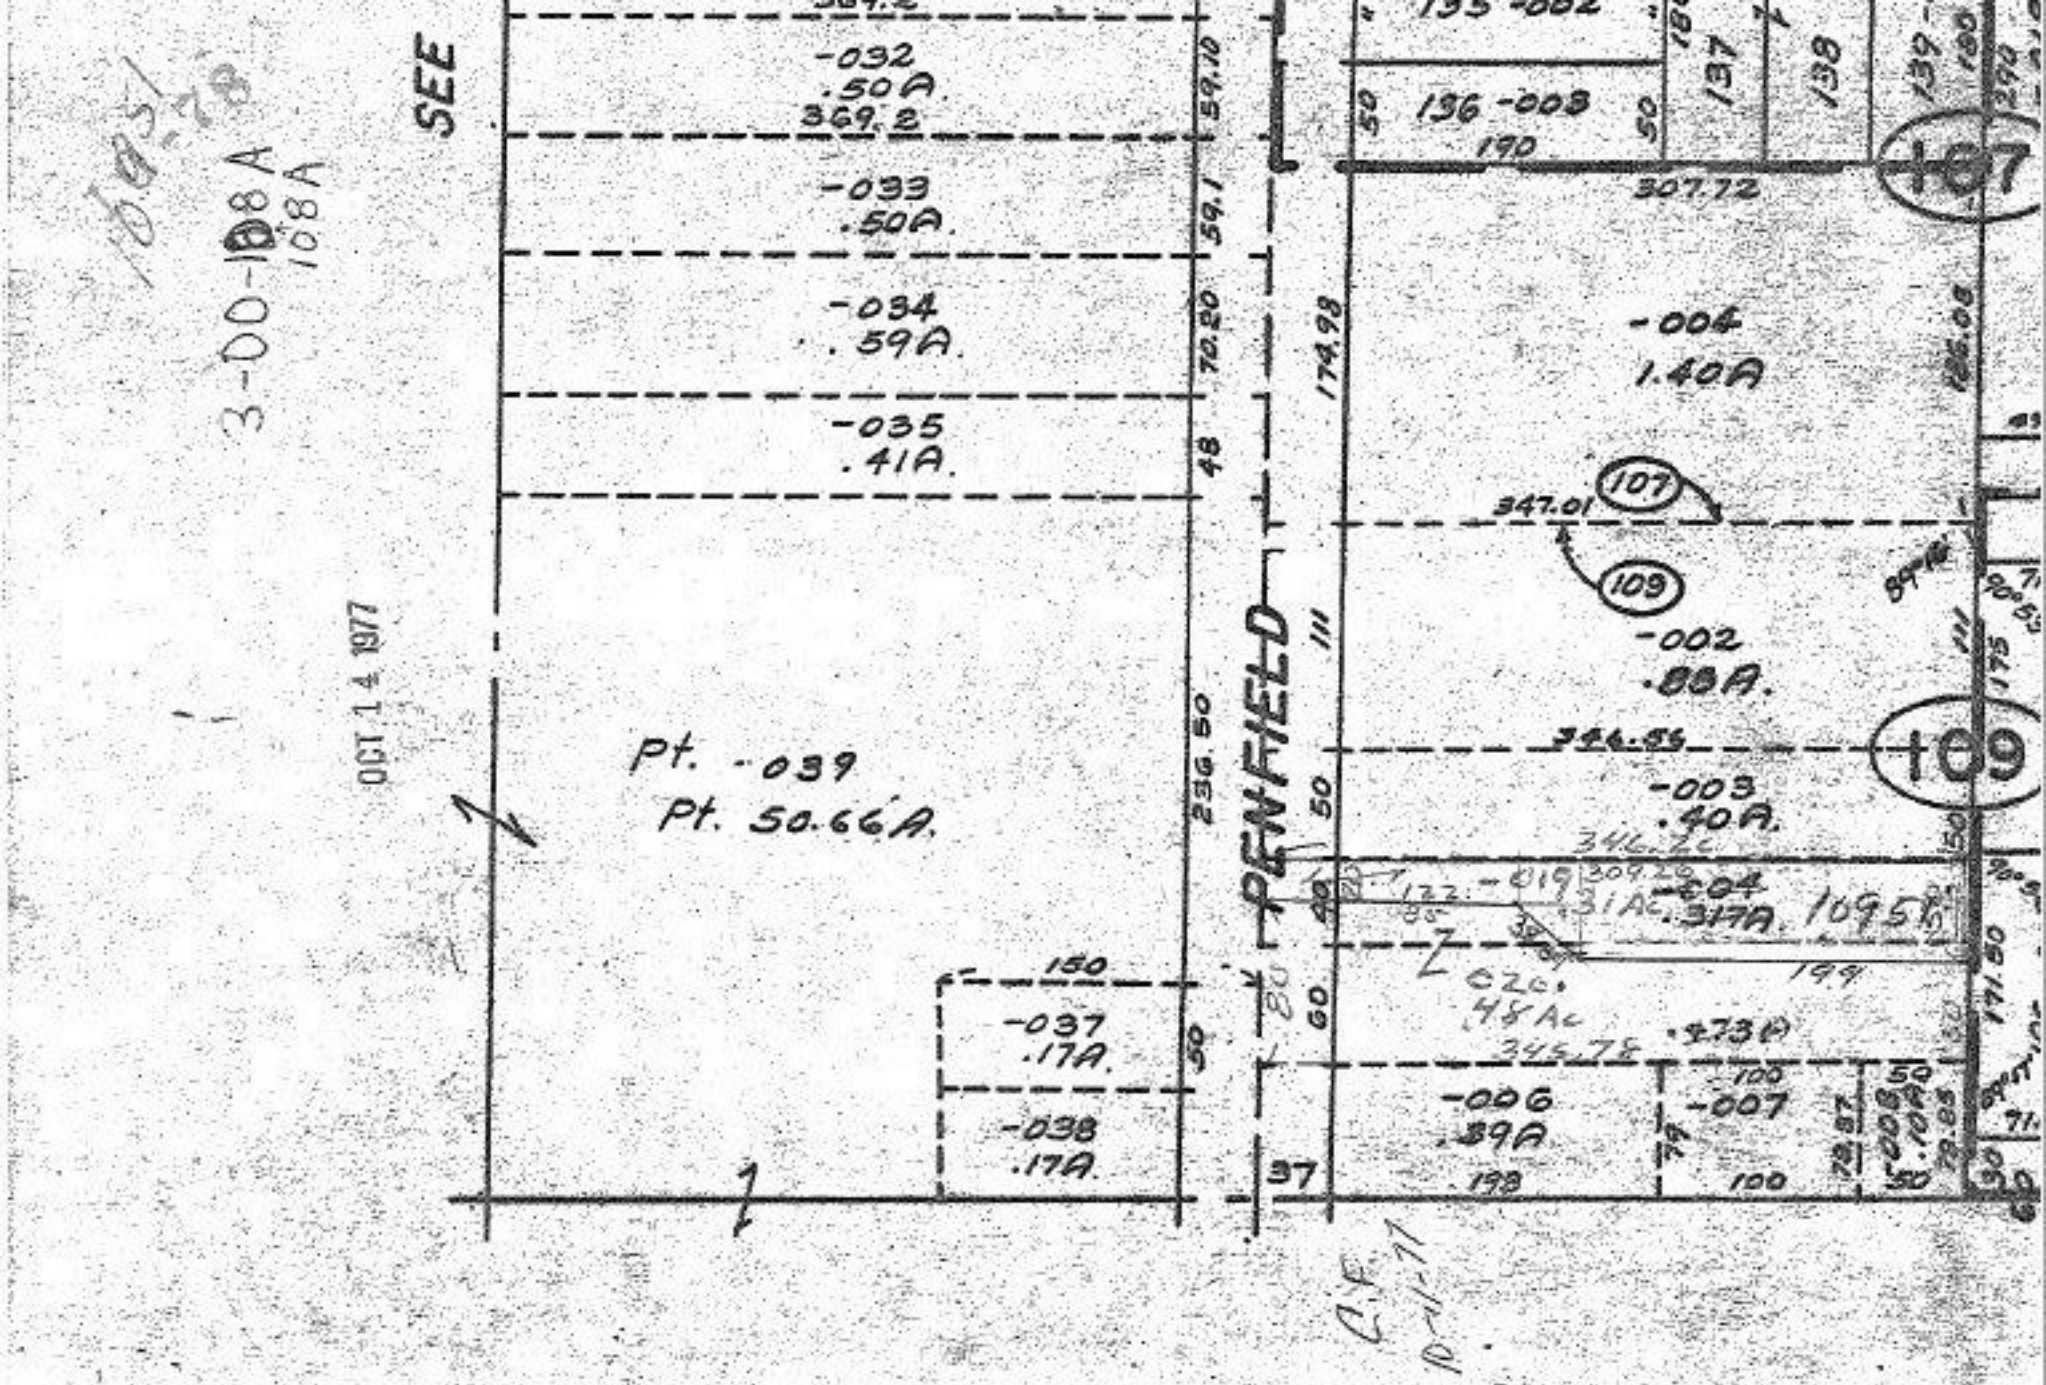

Copyright 1964

6-1

3-00-108-A

