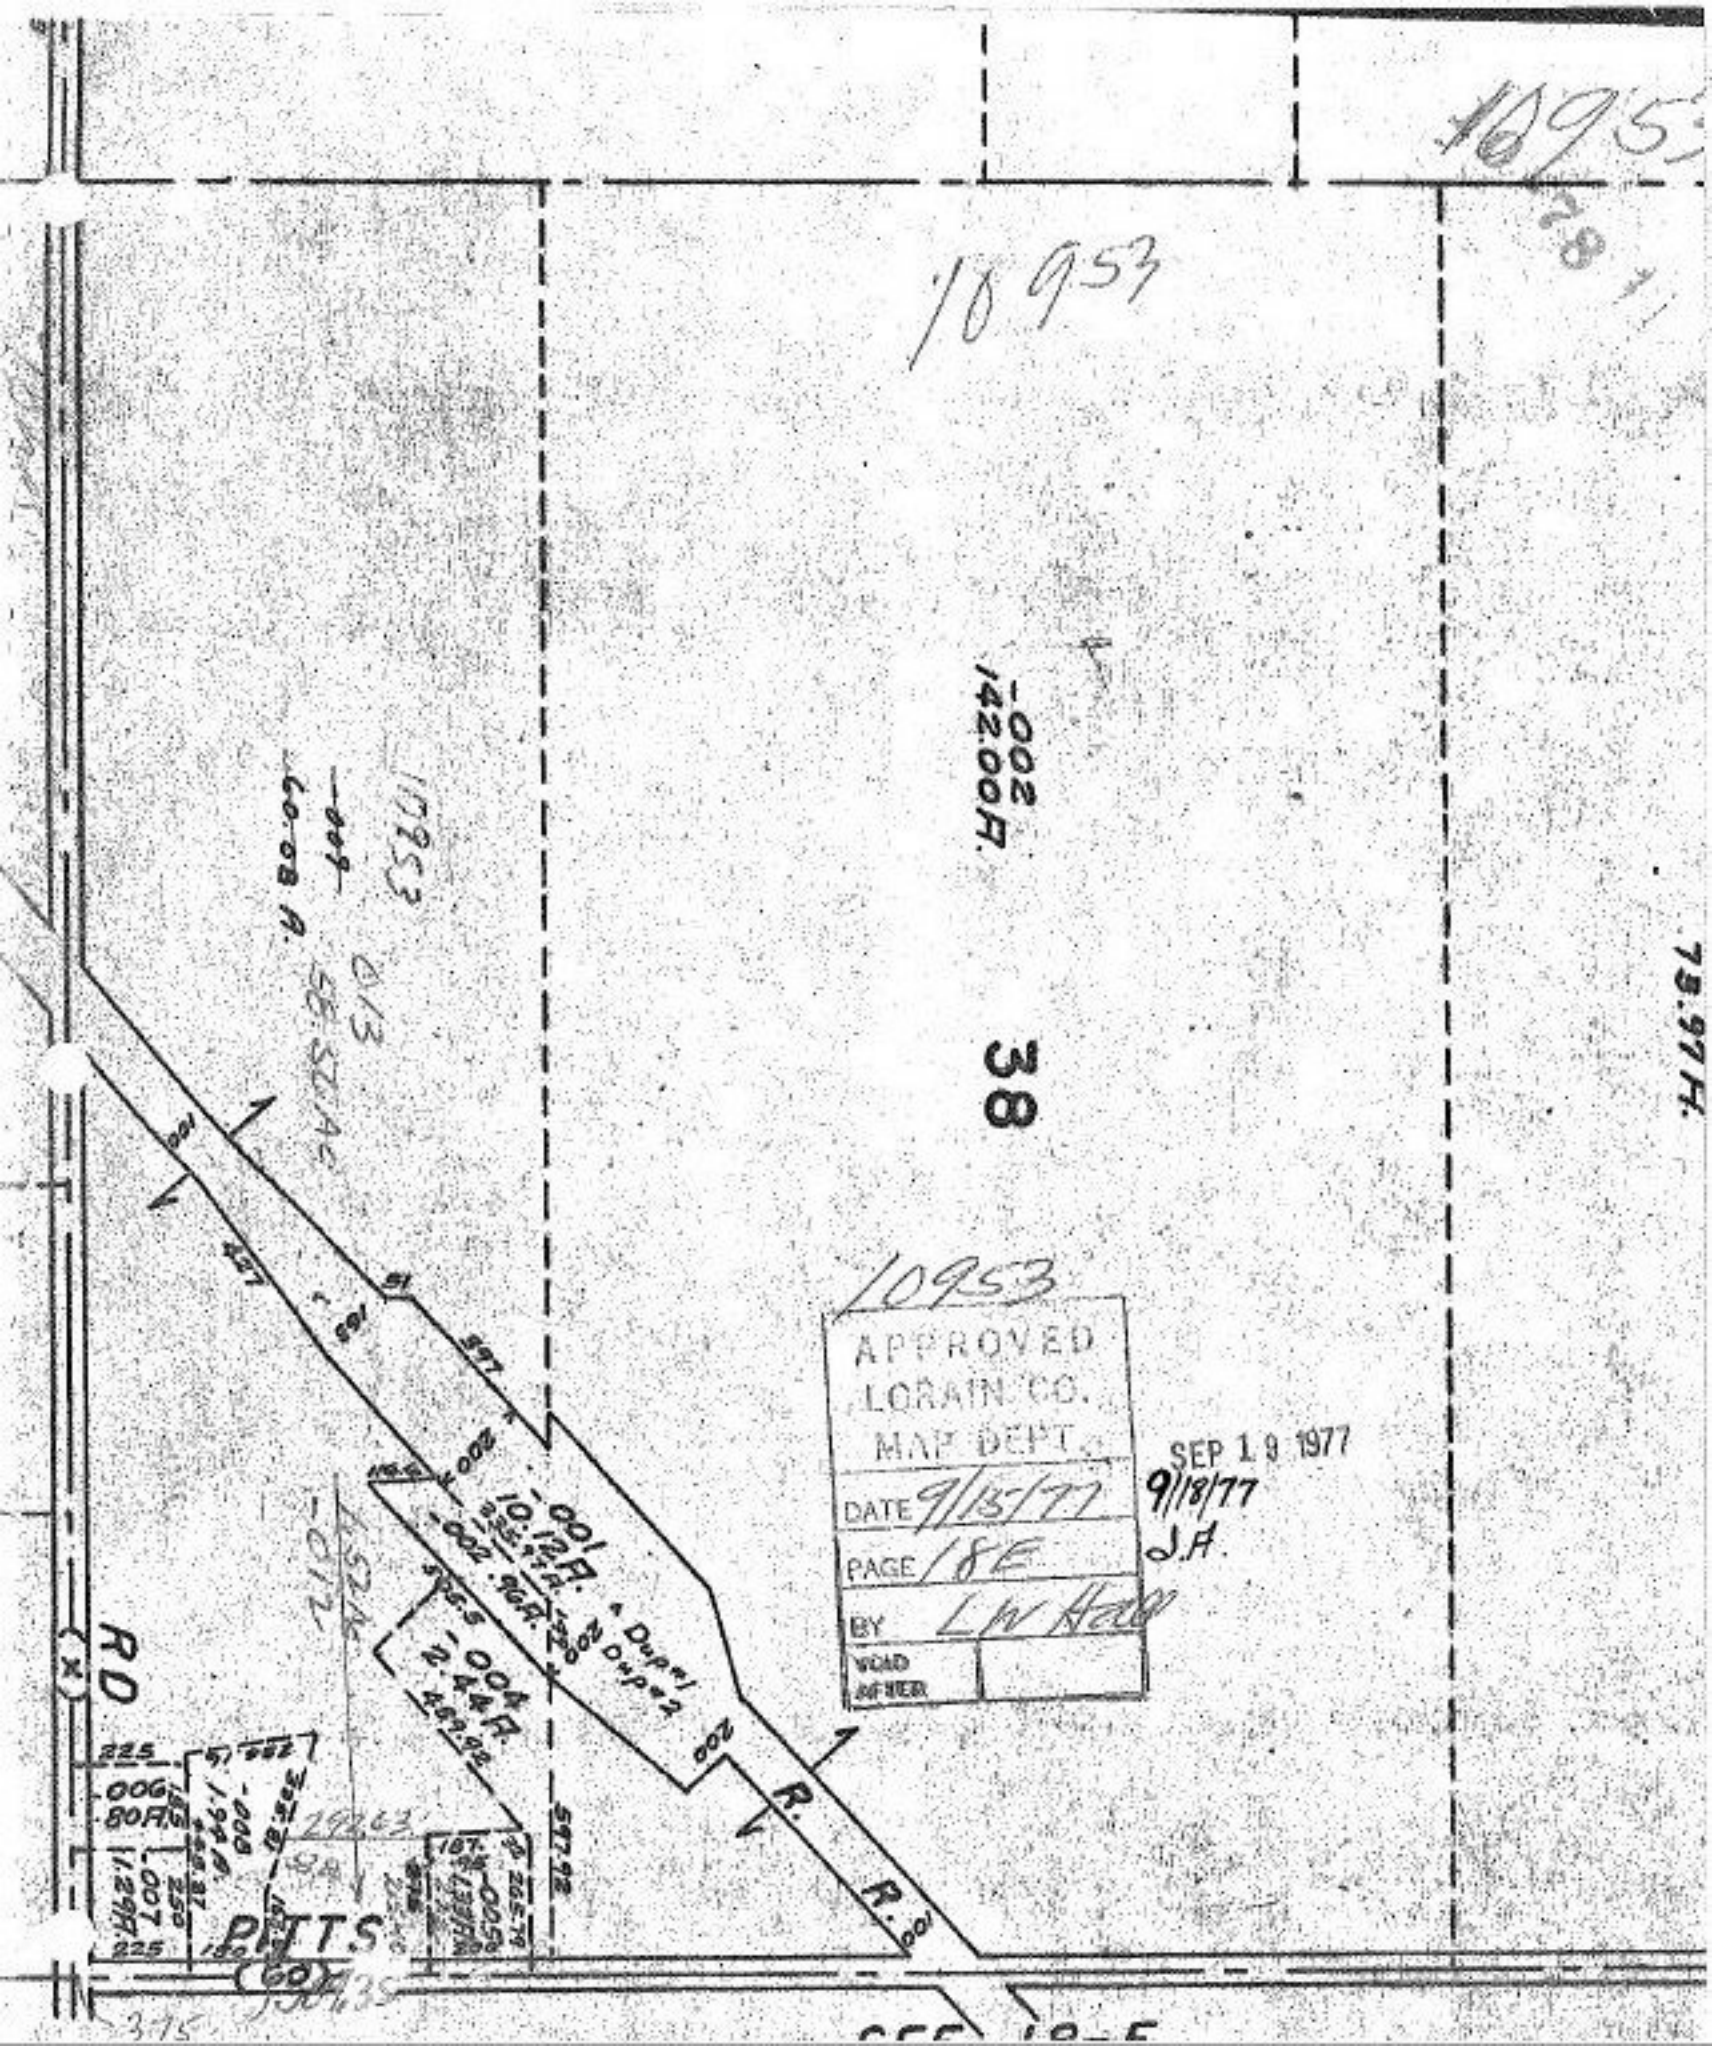
10953
10953
10953
-002
142.00A.
38
75.97A.
-001
10.12A.
-002
-003
2.44A.
469.92
Dupnl
Dupn2
RD
PITTS
APPROVED
LORAIN CO.
MAP DEPT.
DATE 9/15/77
PAGE 18E
BY LW Hall
VOID AFTER
SEP 19 1977
9/18/77
J.A.