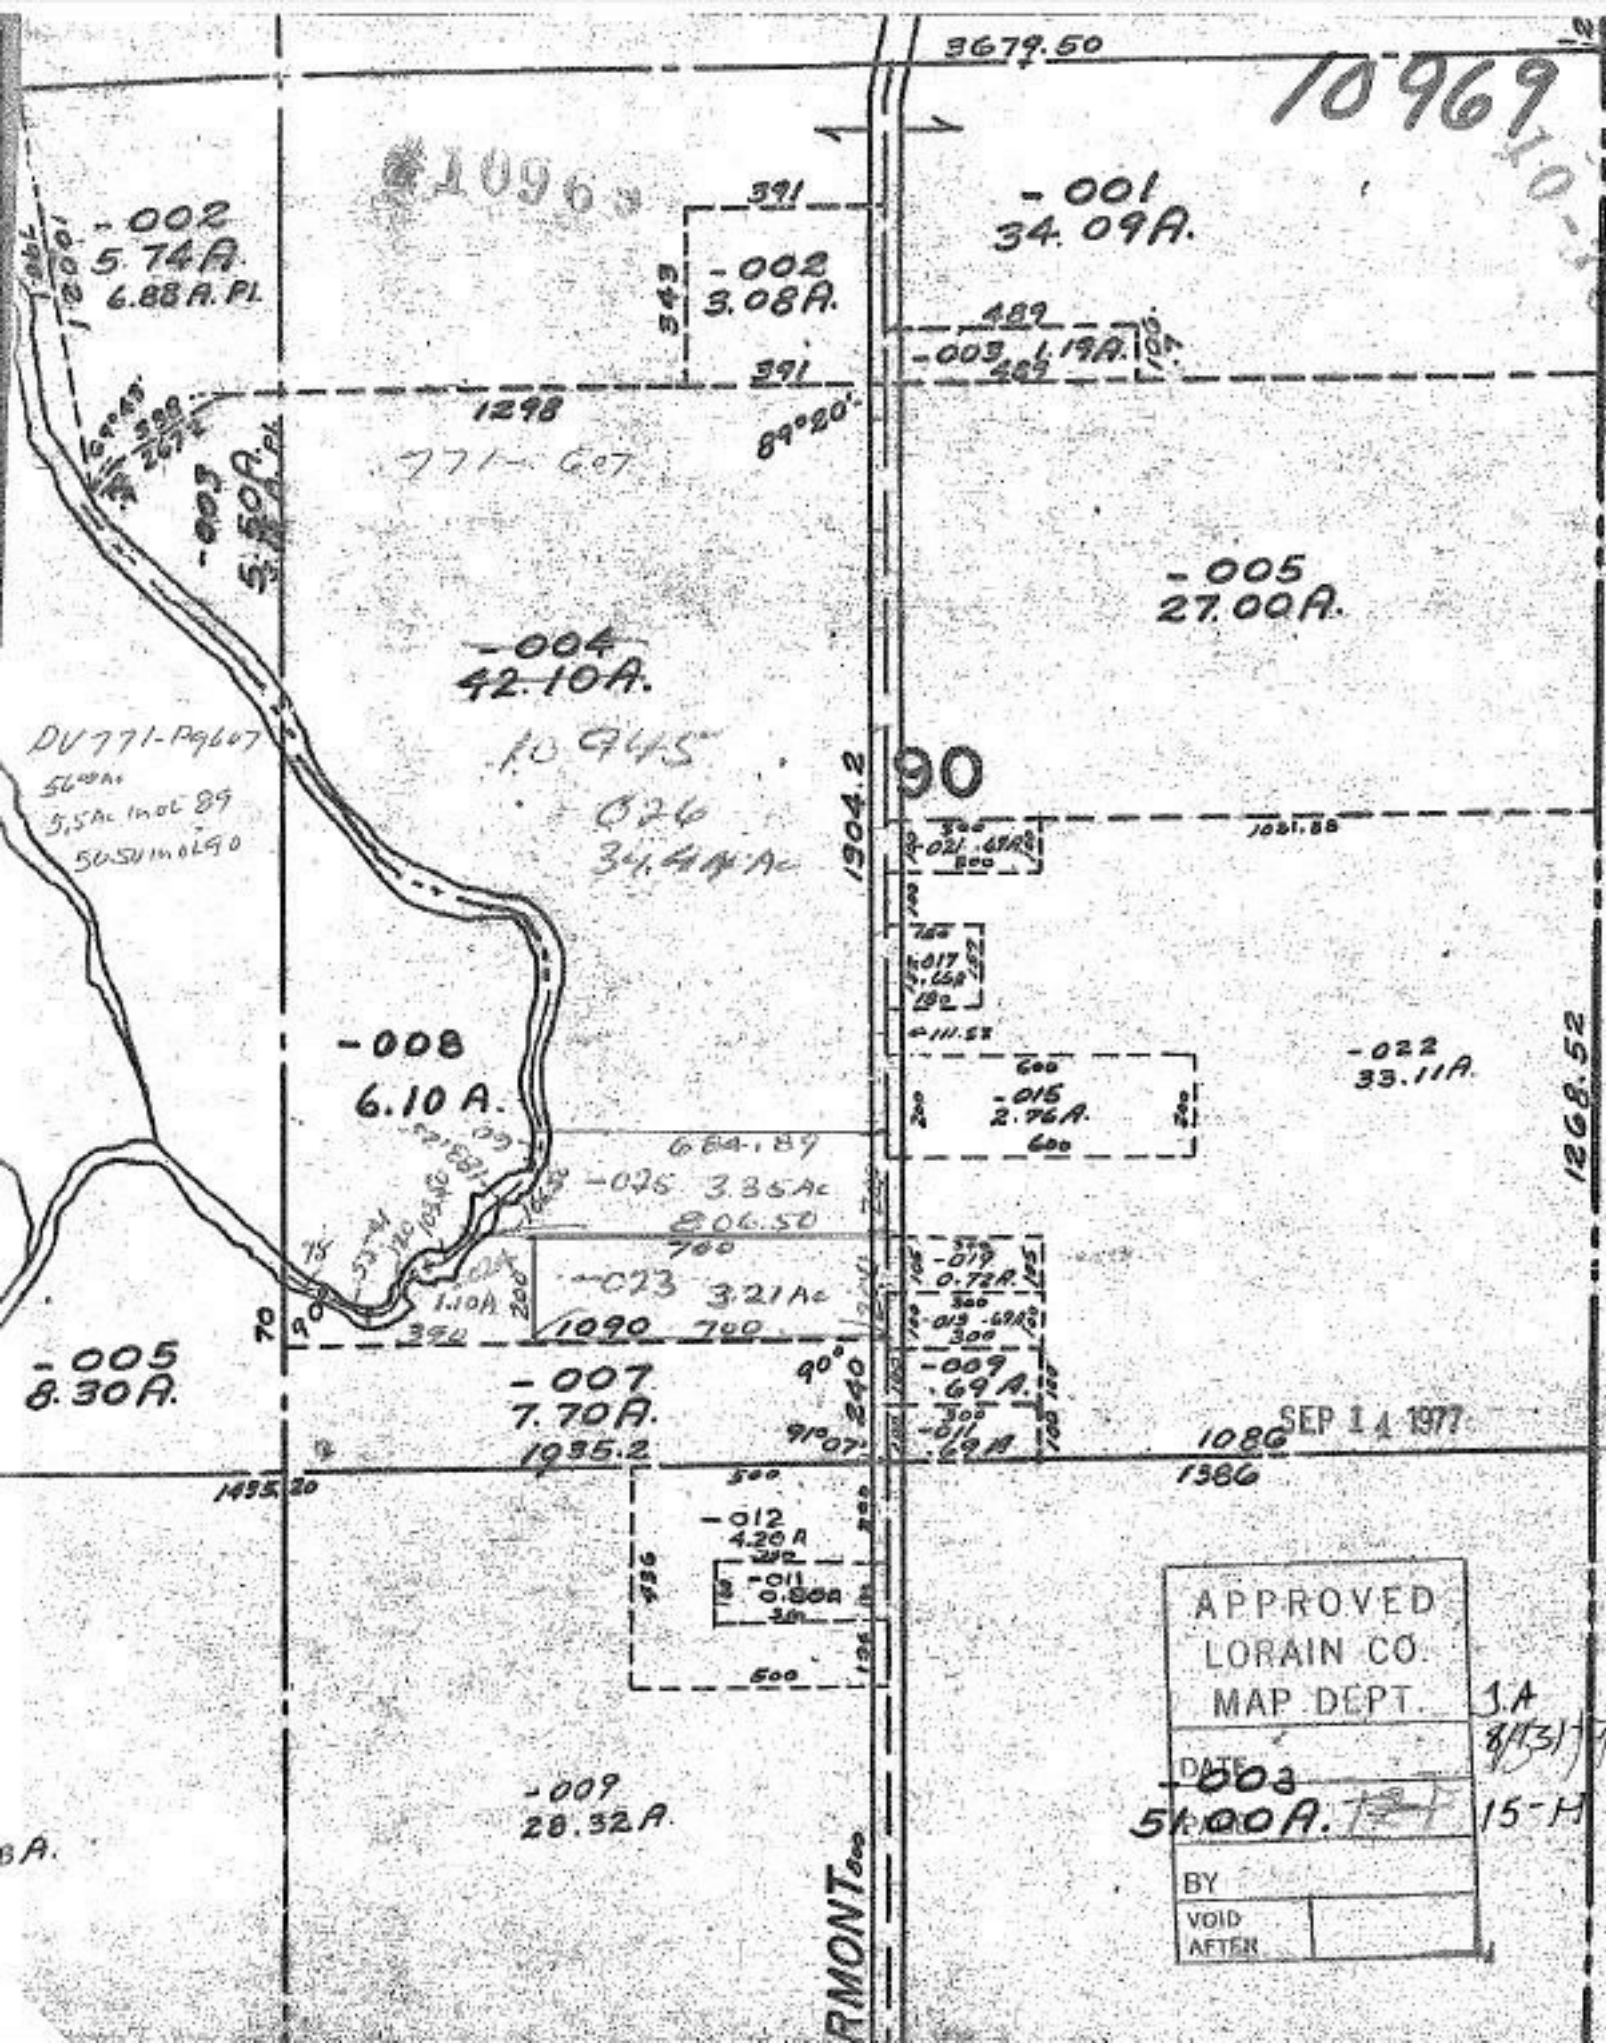
10969
3679.50
-001
34.09A.
-002
5.74A.
6.88A. PL
-002
3.08A.
-003
19A.
-003
5.50A. PL
-004
42.10A.
-005
27.00A.
-008
6.10 A.
-005
8.30A.
-007
7.70A.
-009
28.32A.
-009
.69A.
-011
.69A.
-012
4.20A
-015
2.76A.
-017
1.65A
-019
0.72A.
-022
33.11A.
-023
3.21Ac
1.10A
-076
3.35Ac
1268.52
1904.2
1904.2
1495.20
1935.2
1086
1386
SEP 14 1977
APPROVED
LORAIN CO.
MAP DEPT.
DATE
BY
VOID
AFTER
J.A
8/13/77
15-H
51.00A.