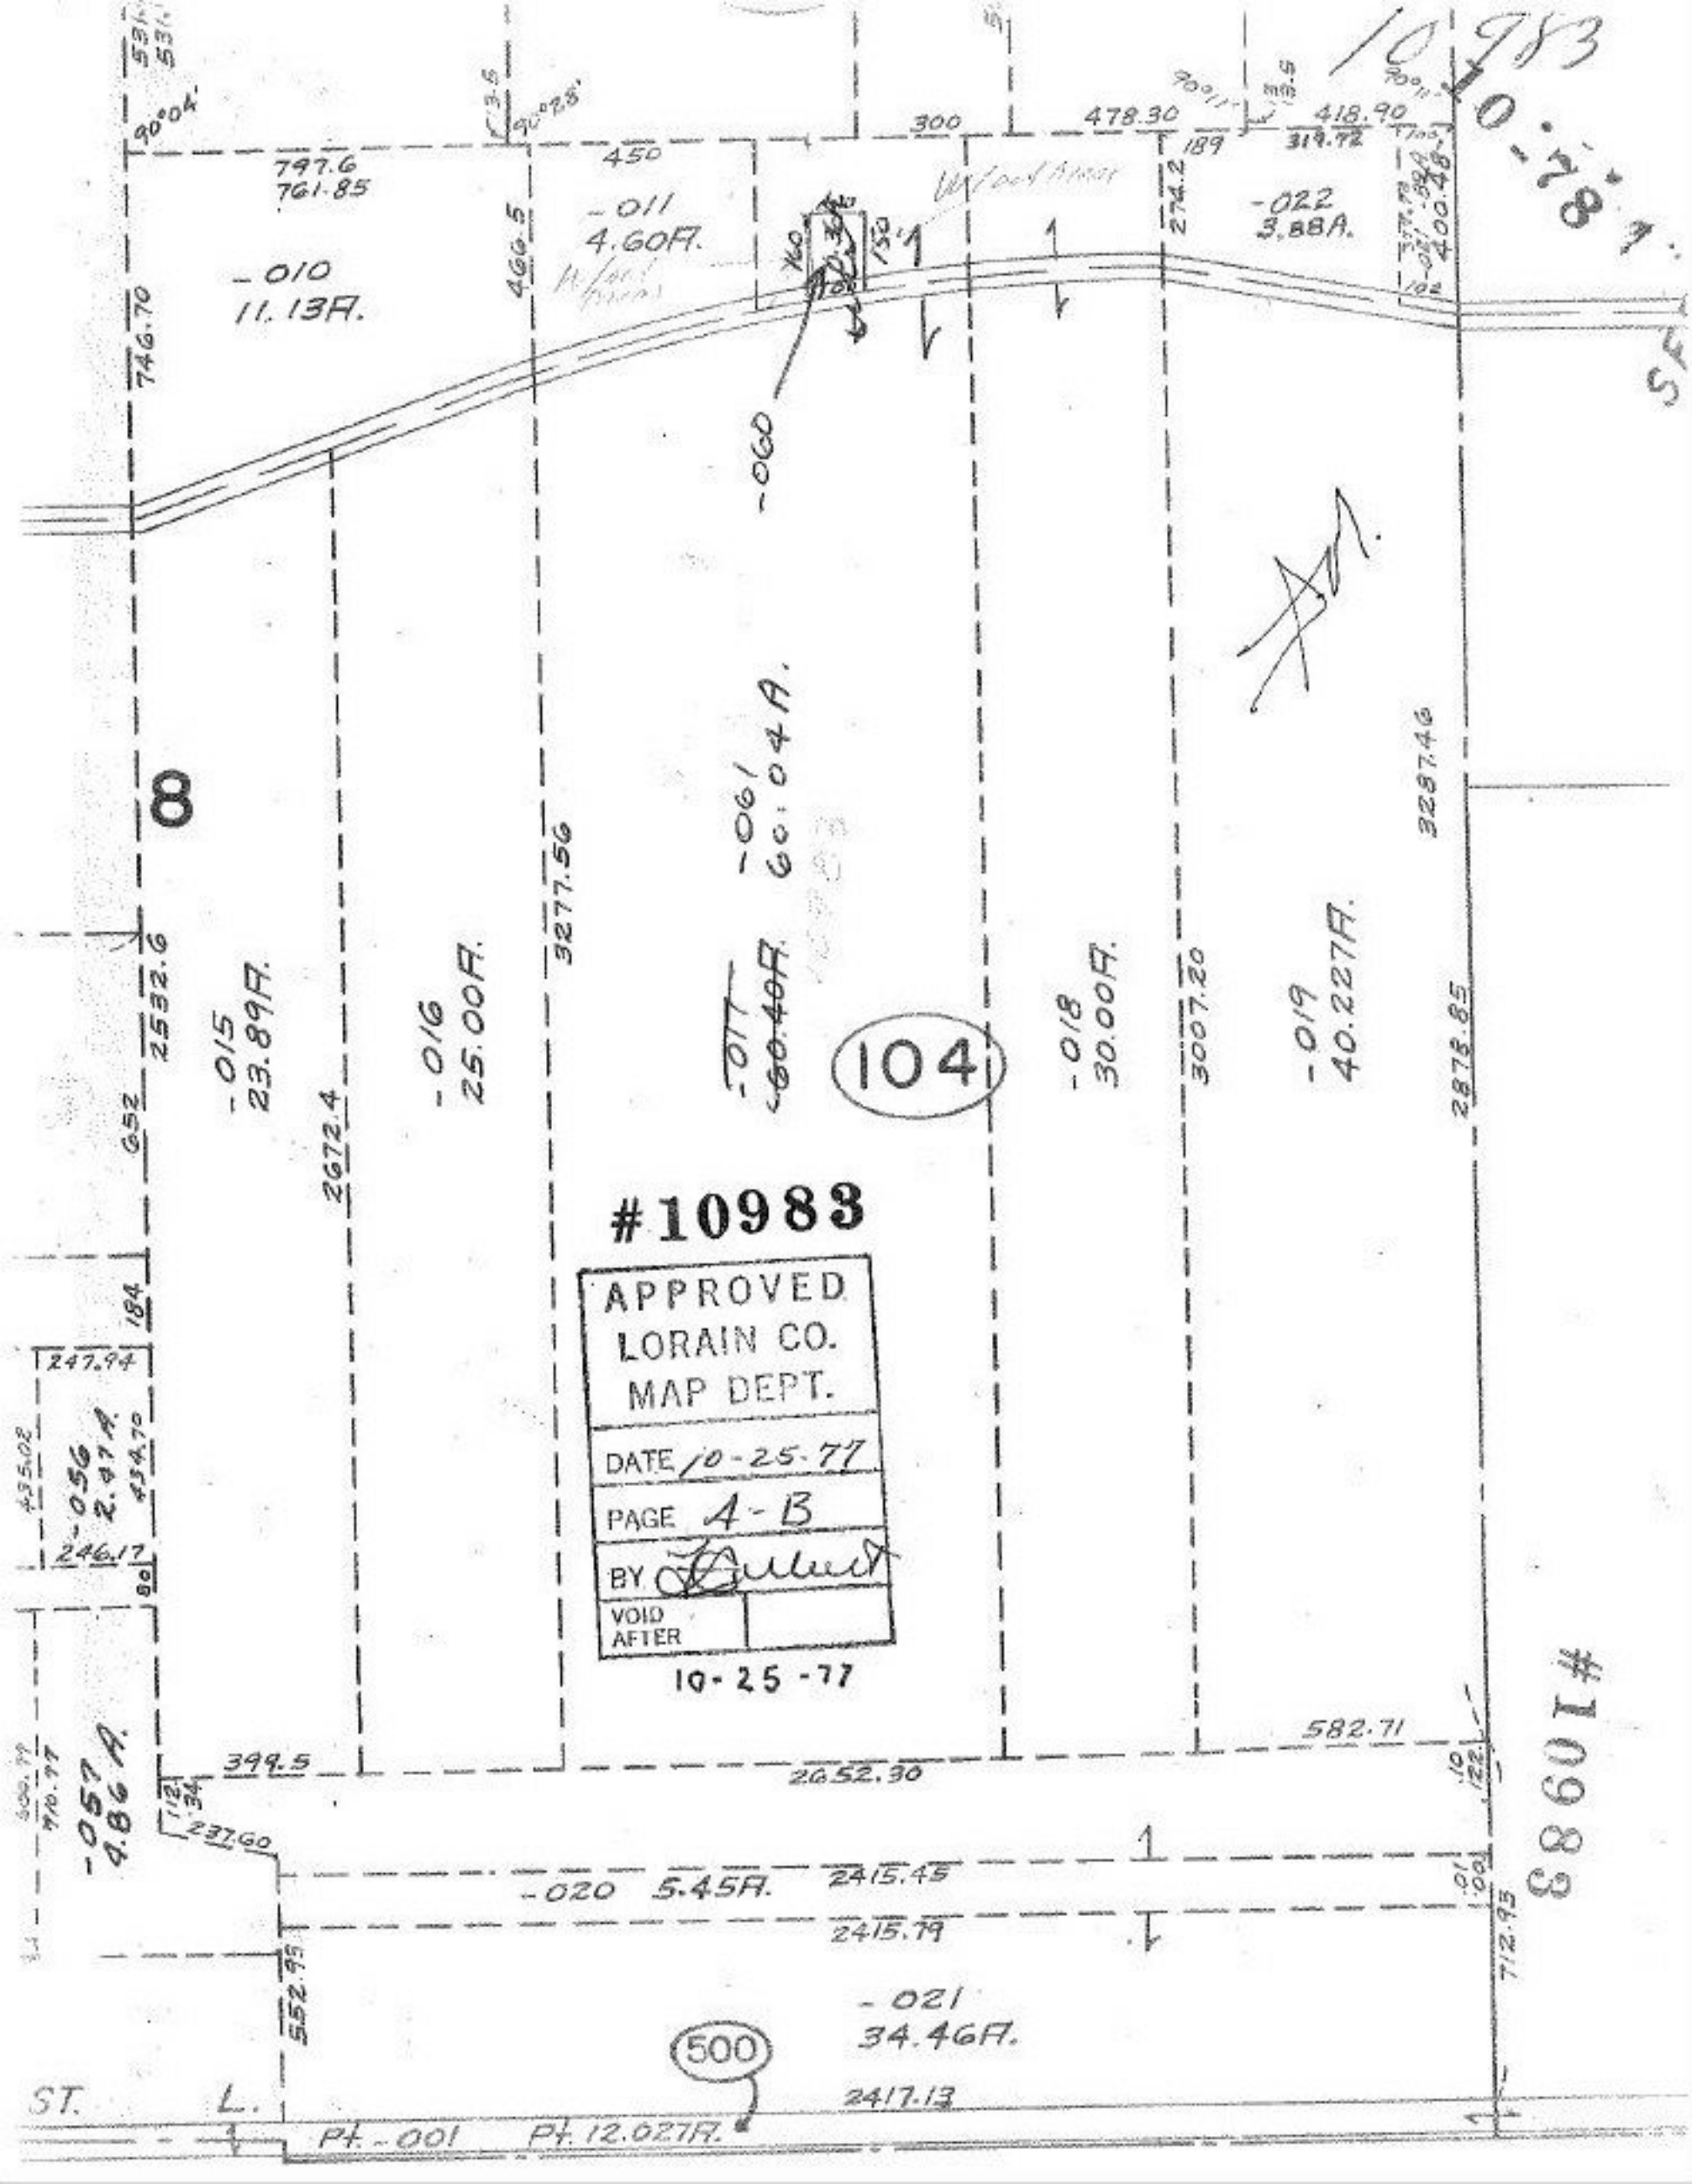

10983
10-78
-010
11.13A.
-011
4.60A.
-022
3.88A.
-060
-061
60.04A.
-015
23.89A.
-016
25.00A.
-017
60.40A.
-018
30.00A.
-019
40.227A.
104
8
#10983
APPROVED
LORAIN CO.
MAP DEPT.
DATE 10-25-77
PAGE 4-B
BY
VOID AFTER
10-25-77
-056
2.47A.
-057
4.86A.
-020 5.45A.
-021
34.46A.
500
ST. L.
Pt. -001 Pt. 12.027A.
#10983