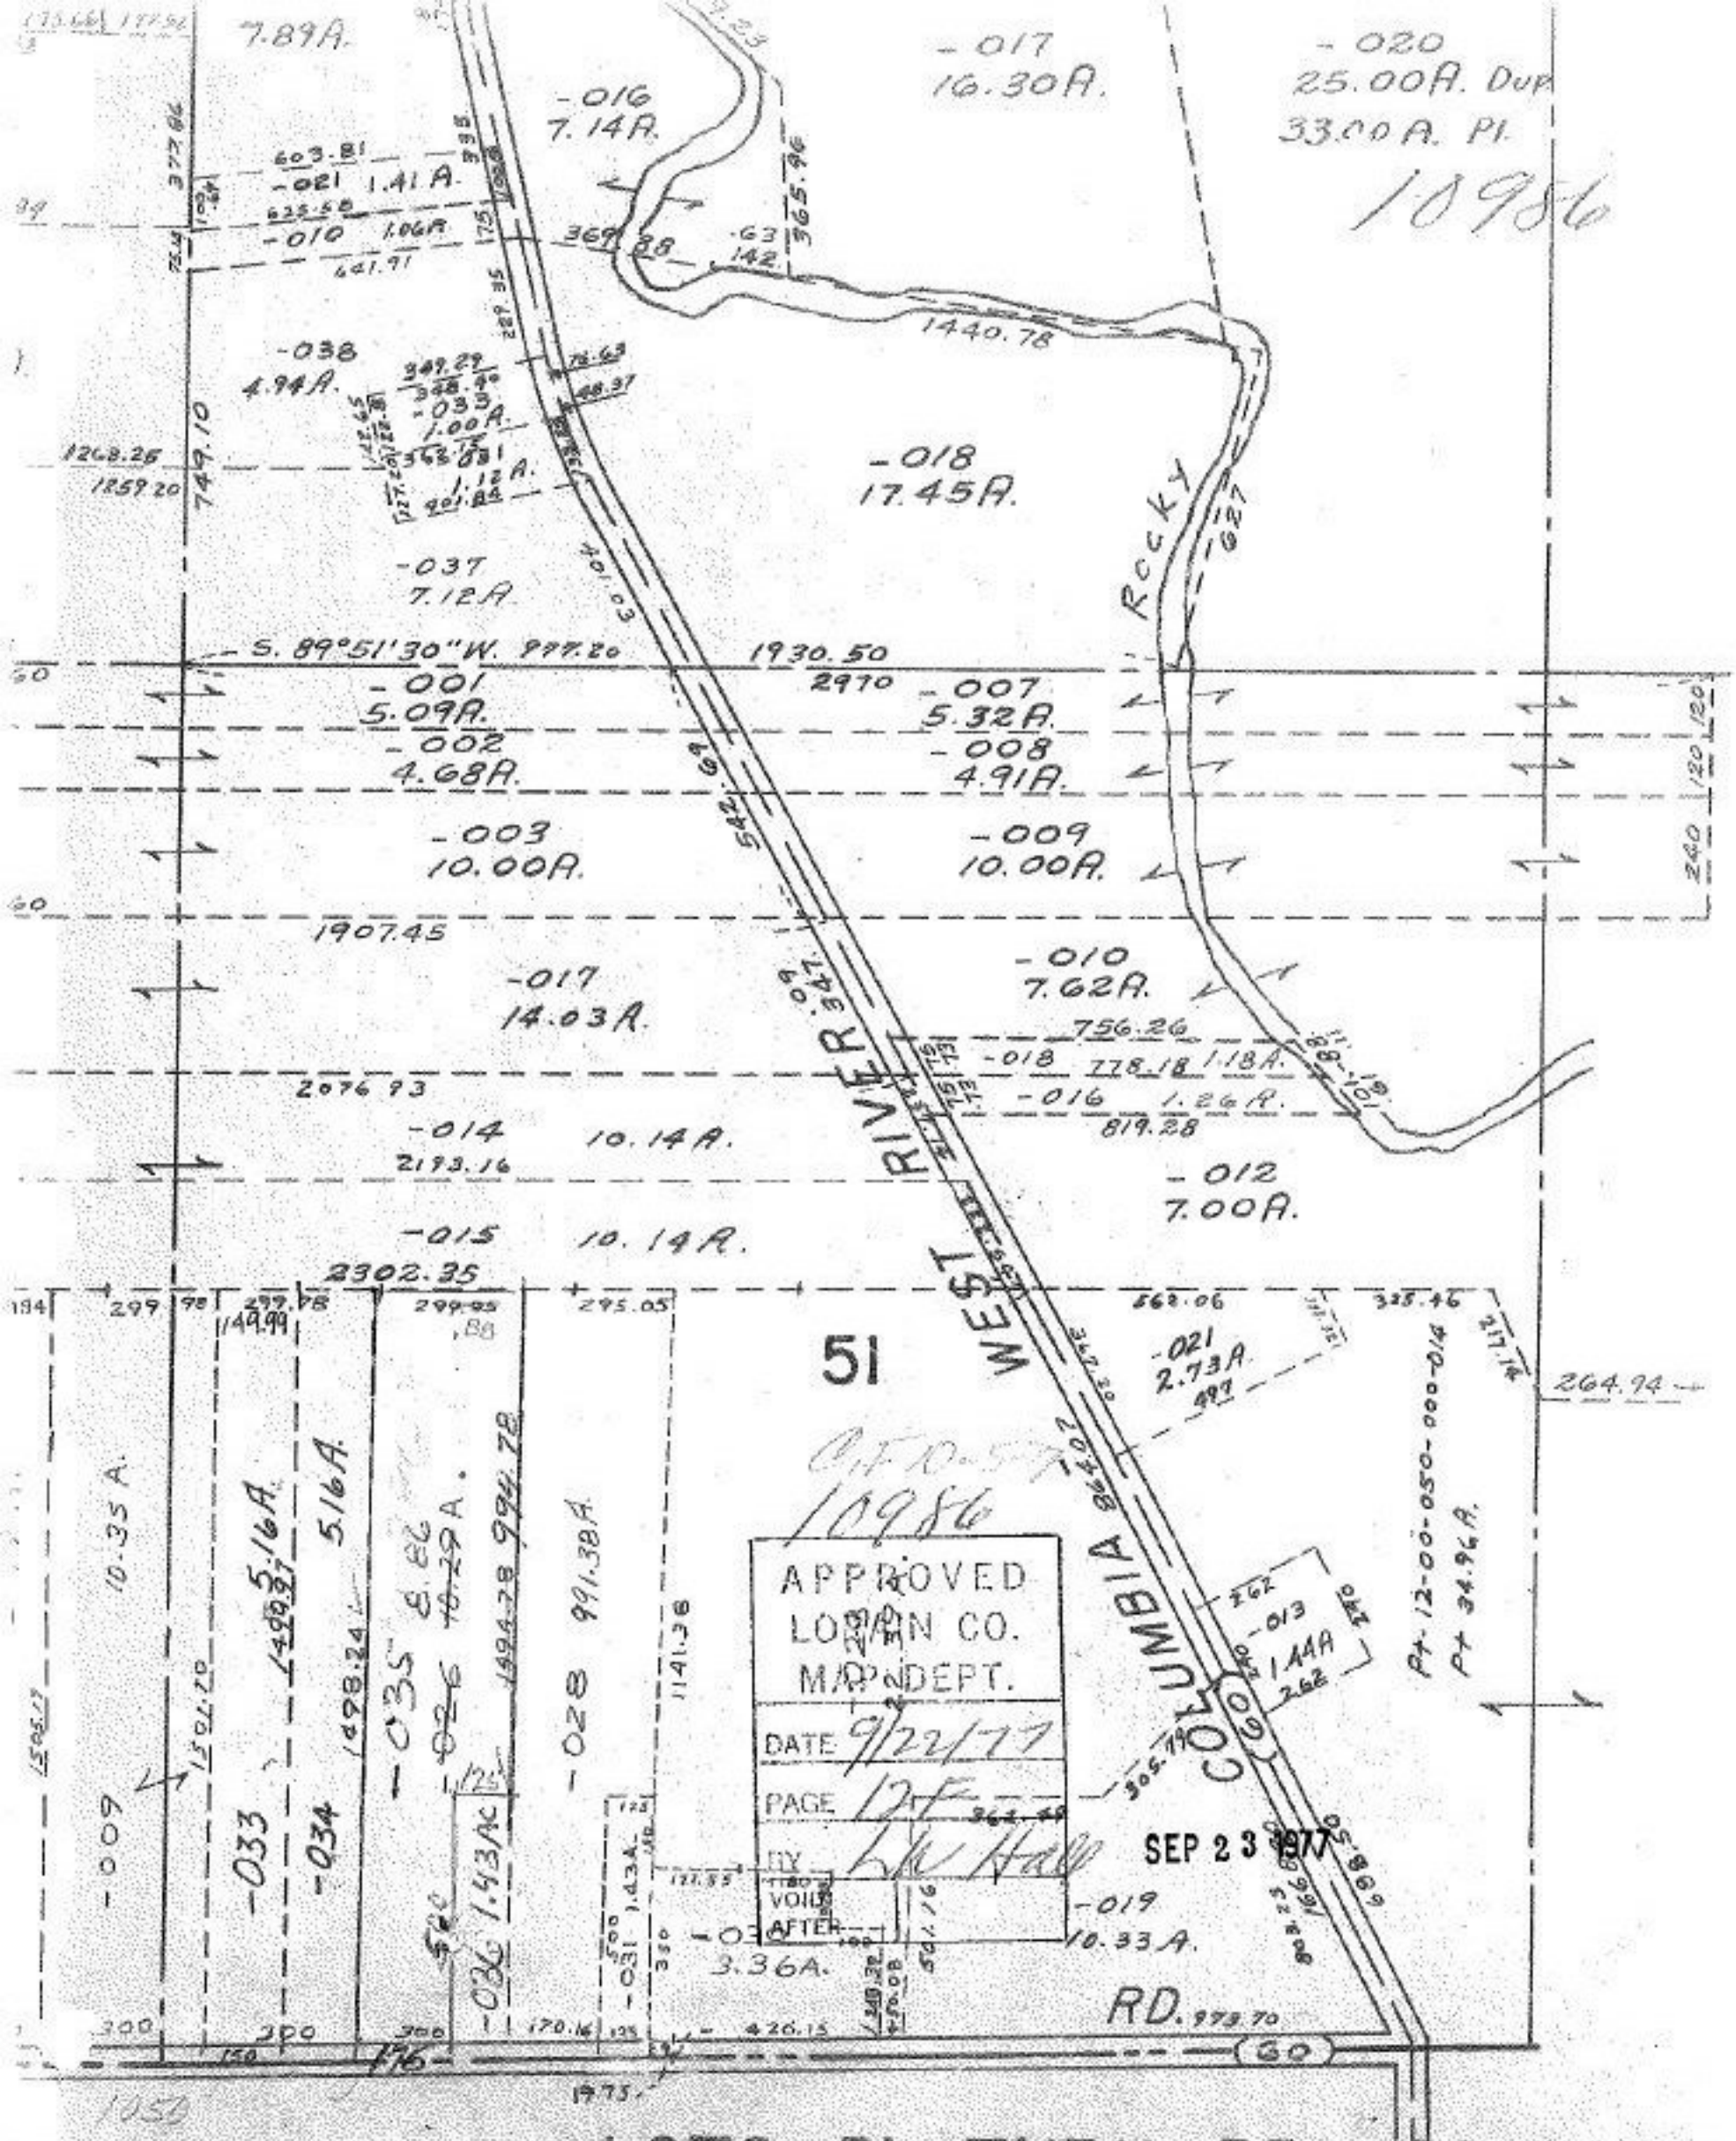
7.89A.
-016
7.14A.
-017
16.30A.
-020
25.00A. DUP
33.00A. PI.
10986
603.81
-021 1.41 A.
625.50
-010 1.06A.
641.91
369.28
1440.78
-038
4.94A.
-033
1.00A.
1.12 A.
1268.26
1259.20
749.10
-018
17.45A.
ROCKY
-037
7.12A.
S. 89°51'30"W. 997.20
1930.50
2970
-001
5.09A.
-007
5.32A.
-002
4.68A.
-008
4.91A.
-003
10.00A.
-009
10.00A.
1907.45
-017
14.03A.
-010
7.62A.
756.26
-018 778.18 1.18A.
-016 1.26A.
819.28
2076.93
-014
10.14A.
2193.16
-012
7.00A.
-015
10.14A.
2302.35
51
WEST
COLUMBIA
-021
2.73A.
-013
1.44A
264.94
10.35 A.
5.16A.
5.16A.
-035
8.86
-028
991.38A.
-009
-033
-034
-036
1.43Ac
-031
1.43A.
-032
3.36A.
-019
10.33A.
RD.
APPROVED
MAP DEPT.
DATE 9/22/77
PAGE 12F
BY
VOID
AFTER
SEP 23 1977
1"=400'
LOTS 51 THRU 55, 66 THRU