

10-78

10990


3-27-85

10990

10-78

SEE 3-00-1

SEE 3-00-103-B

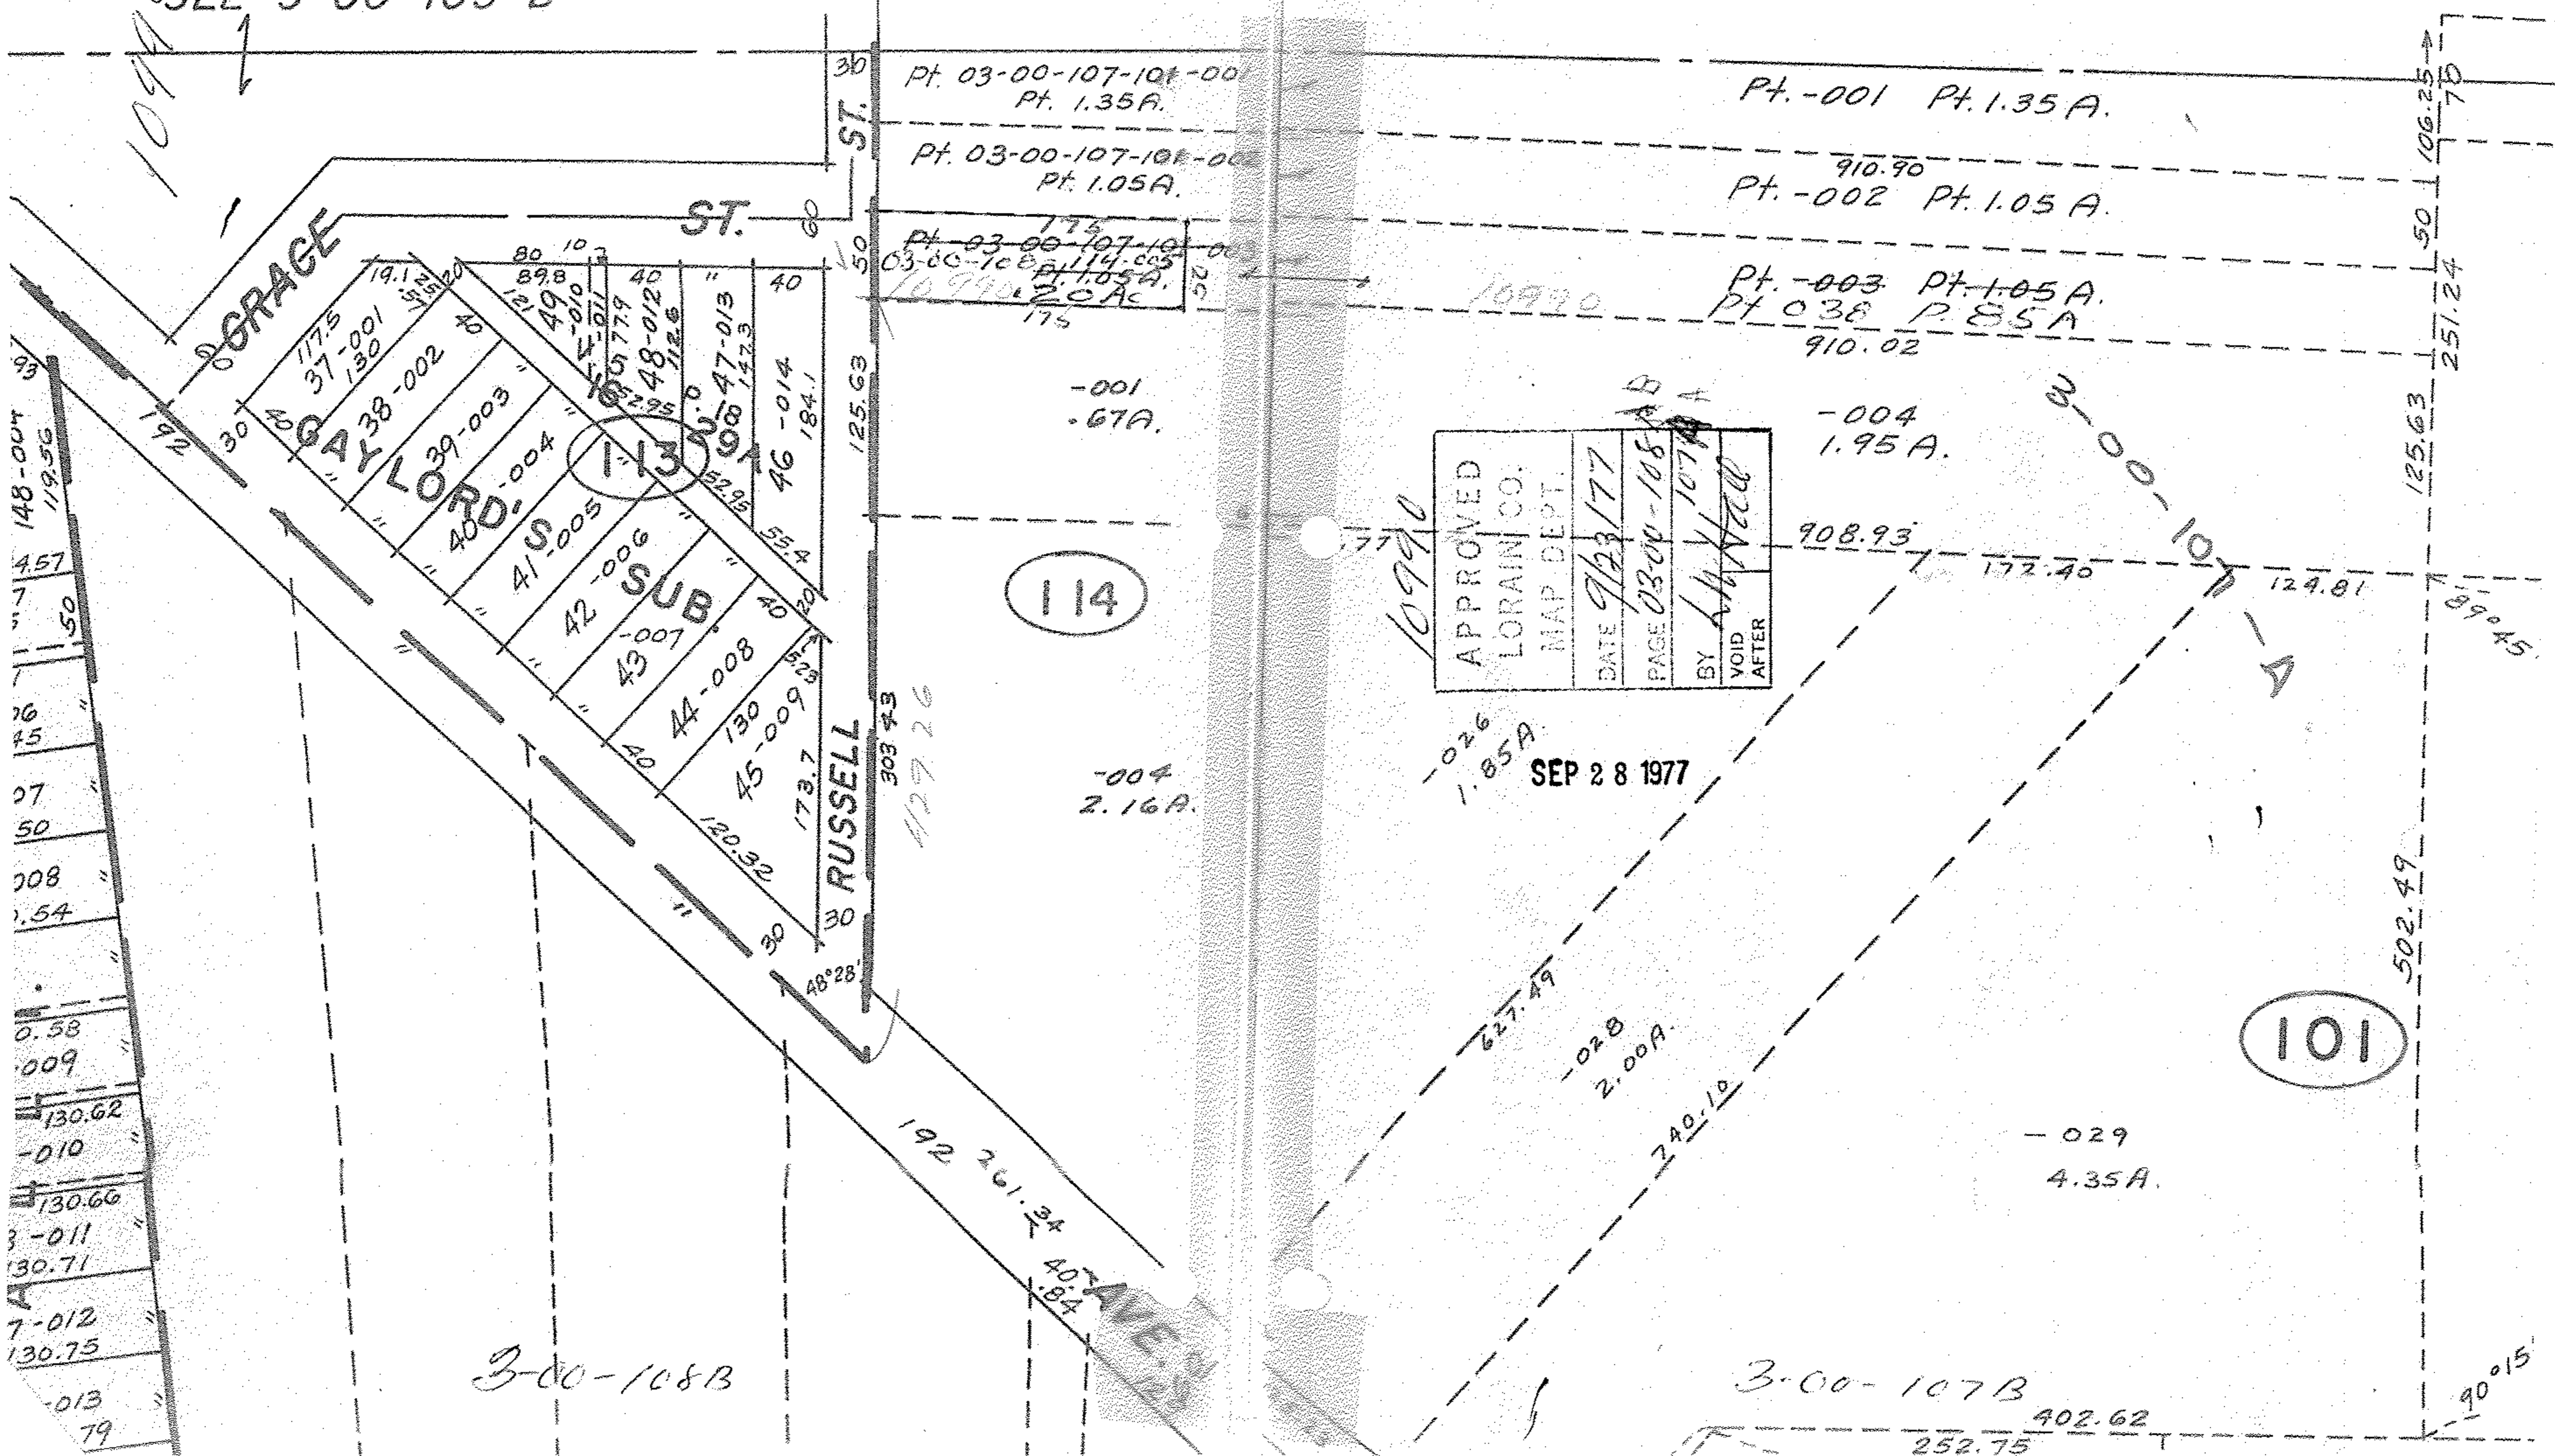

148-004	89
119.56	
4.57	
7	
1.50	
26	
45	
27	
50	
008	
1.54	
0.53	
009	
130.62	
-010	
130.66	
3-011	
130.71	
7-012	
130.75	
-013	
79	

APPROVED  
LORAIN CO.  
MAP DEPT.  
DATE 9/23/77  
PAGE 0300-108  
BY [Signature]  
VOID AFTER

SEP 28 1977

3-00-108B

3-00-107B