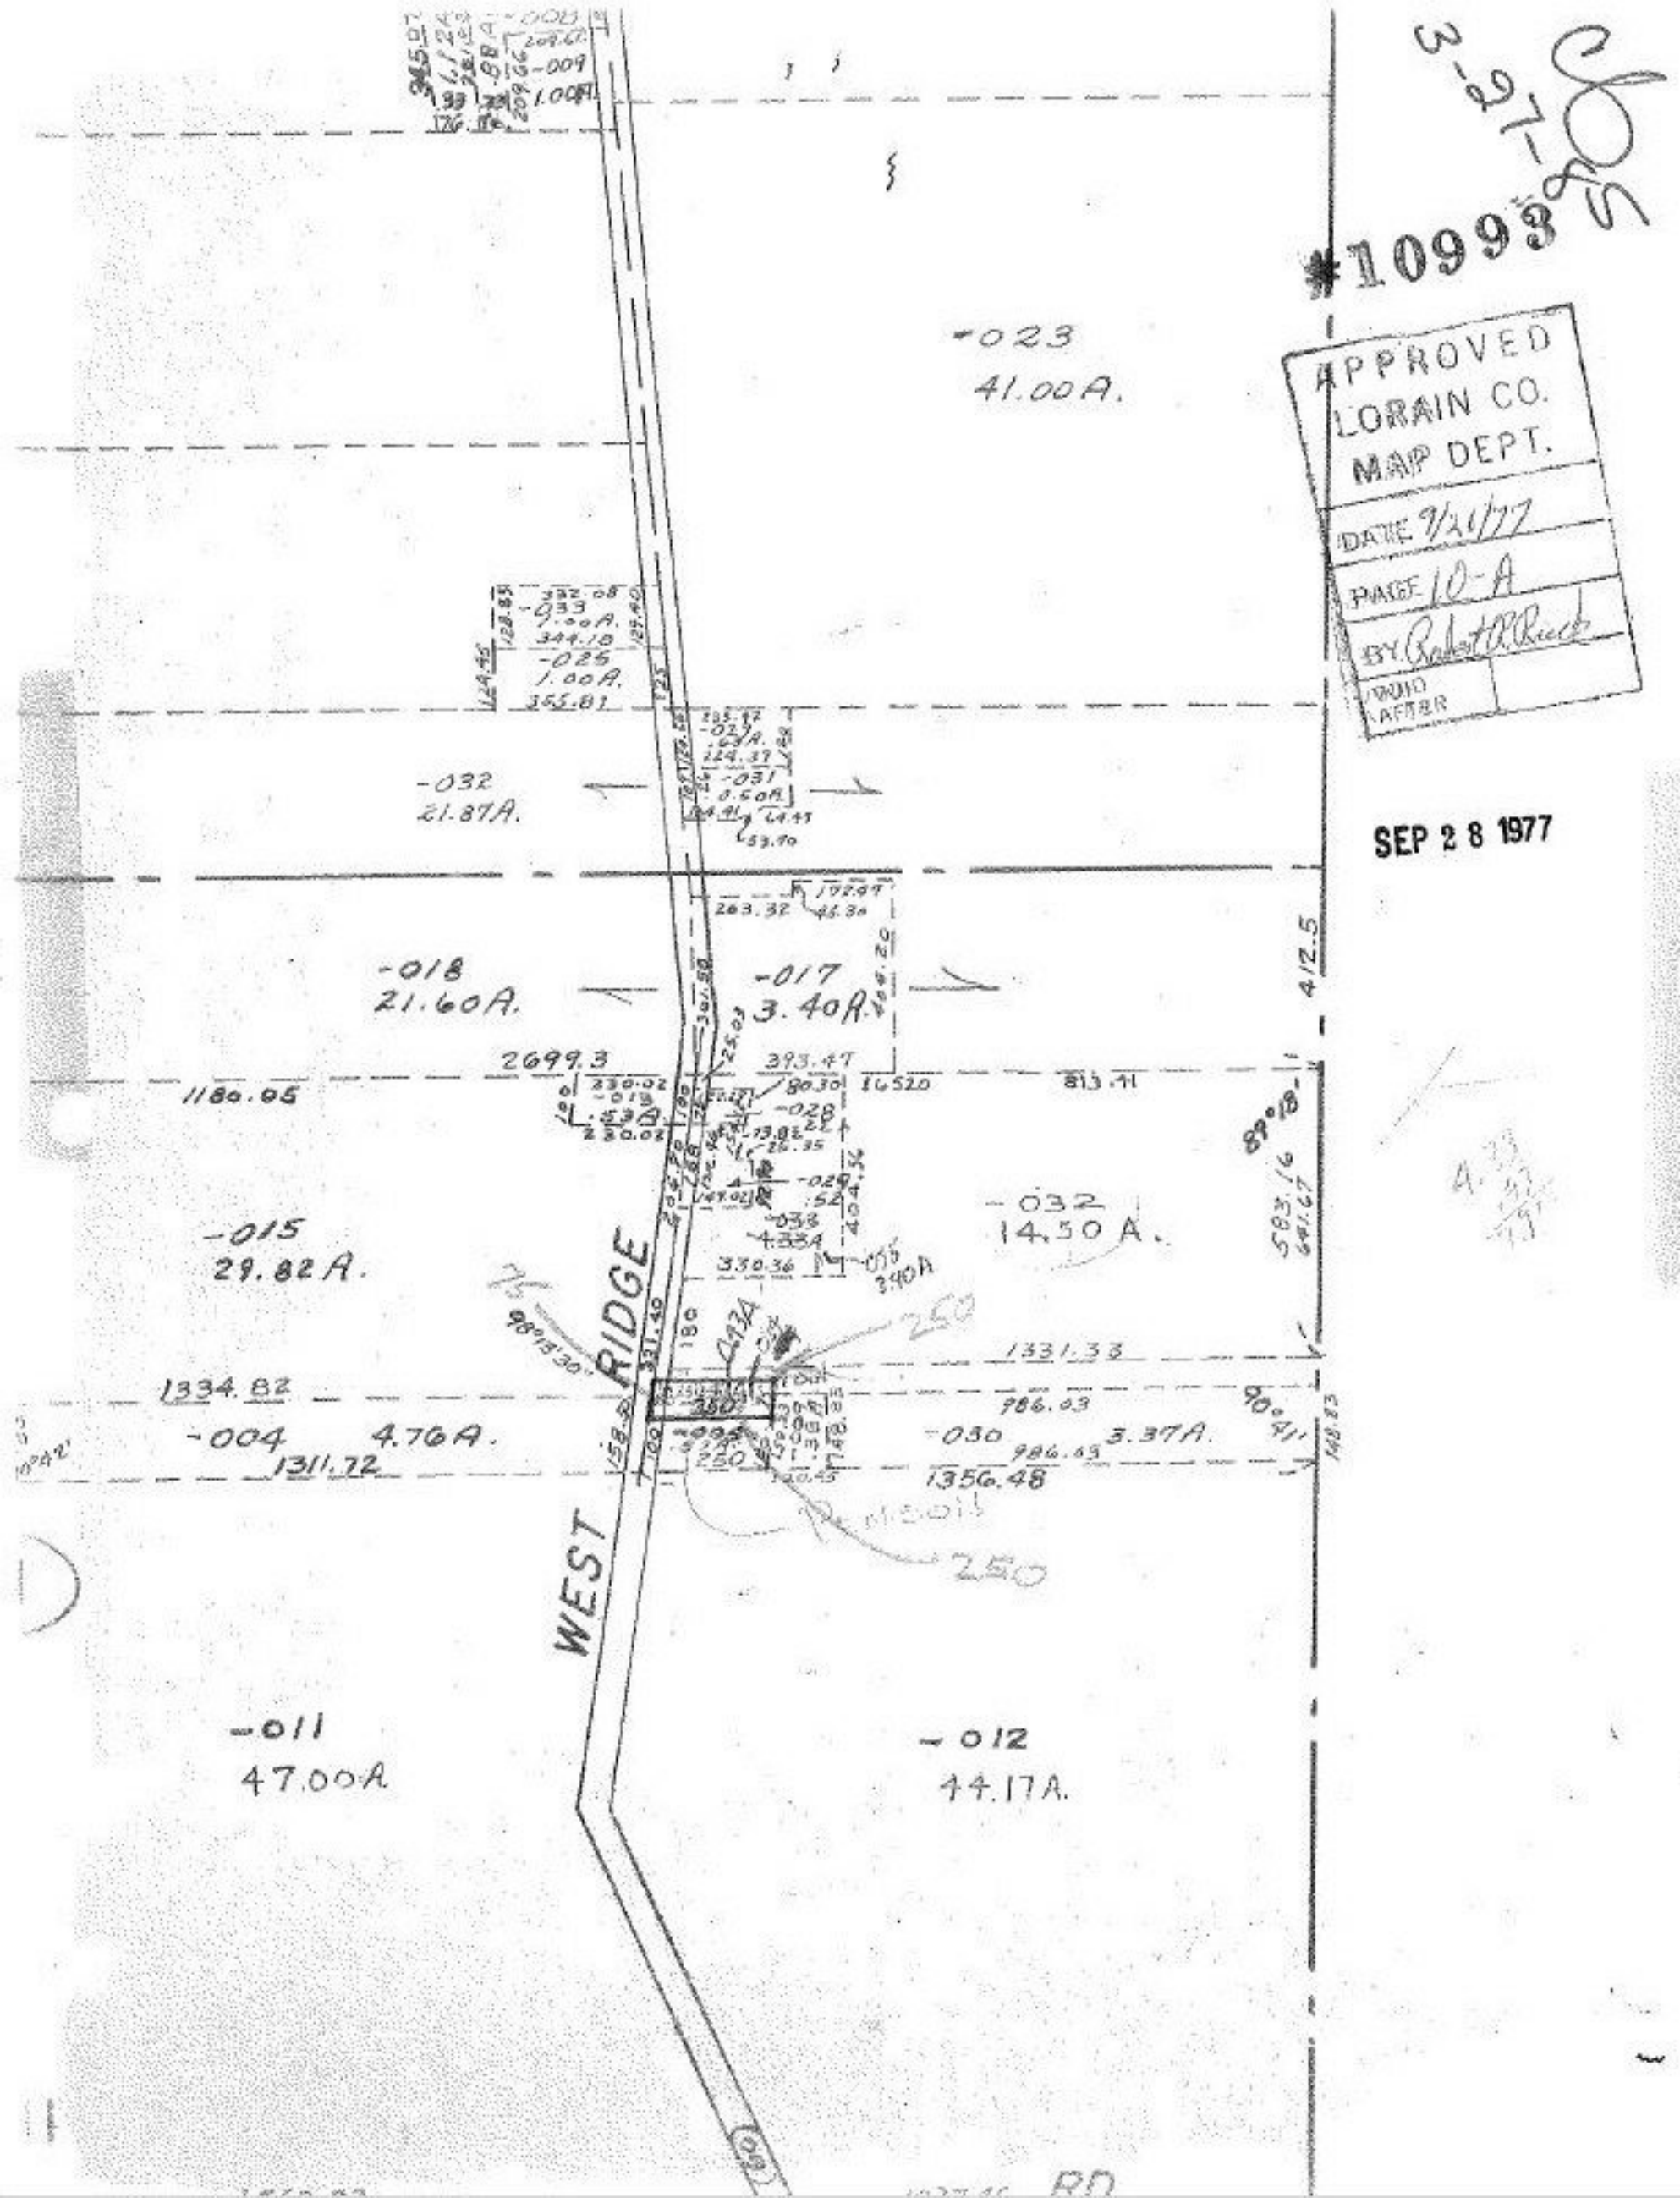

#10993
APPROVED
LORAIN CO.
MAP DEPT.
DATE 9/21/77
PAGE 10-A
BY
VOID AFTER
SEP 28 1977
-023
41.00A.
-032
21.87A.
-018
21.60A.
-017
3.40A.
2699.3
1180.05
-015
29.82A.
-032
14.50A.
WEST RIDGE
1334.82
-004
4.76A.
1311.72
-030
3.37A.
1356.48
1331.33
-011
47.00A
-012
44.17A.
412.5
RD