


#11003
 APPROVED
 LORAIN CO.
 MAP DEPT.
 DATE 10-4-77
 PAGE 07-00-018
 BY J.R.M.
 VOID AFTER 11003

OCT 14 1977

500

-091
 2.75 A.

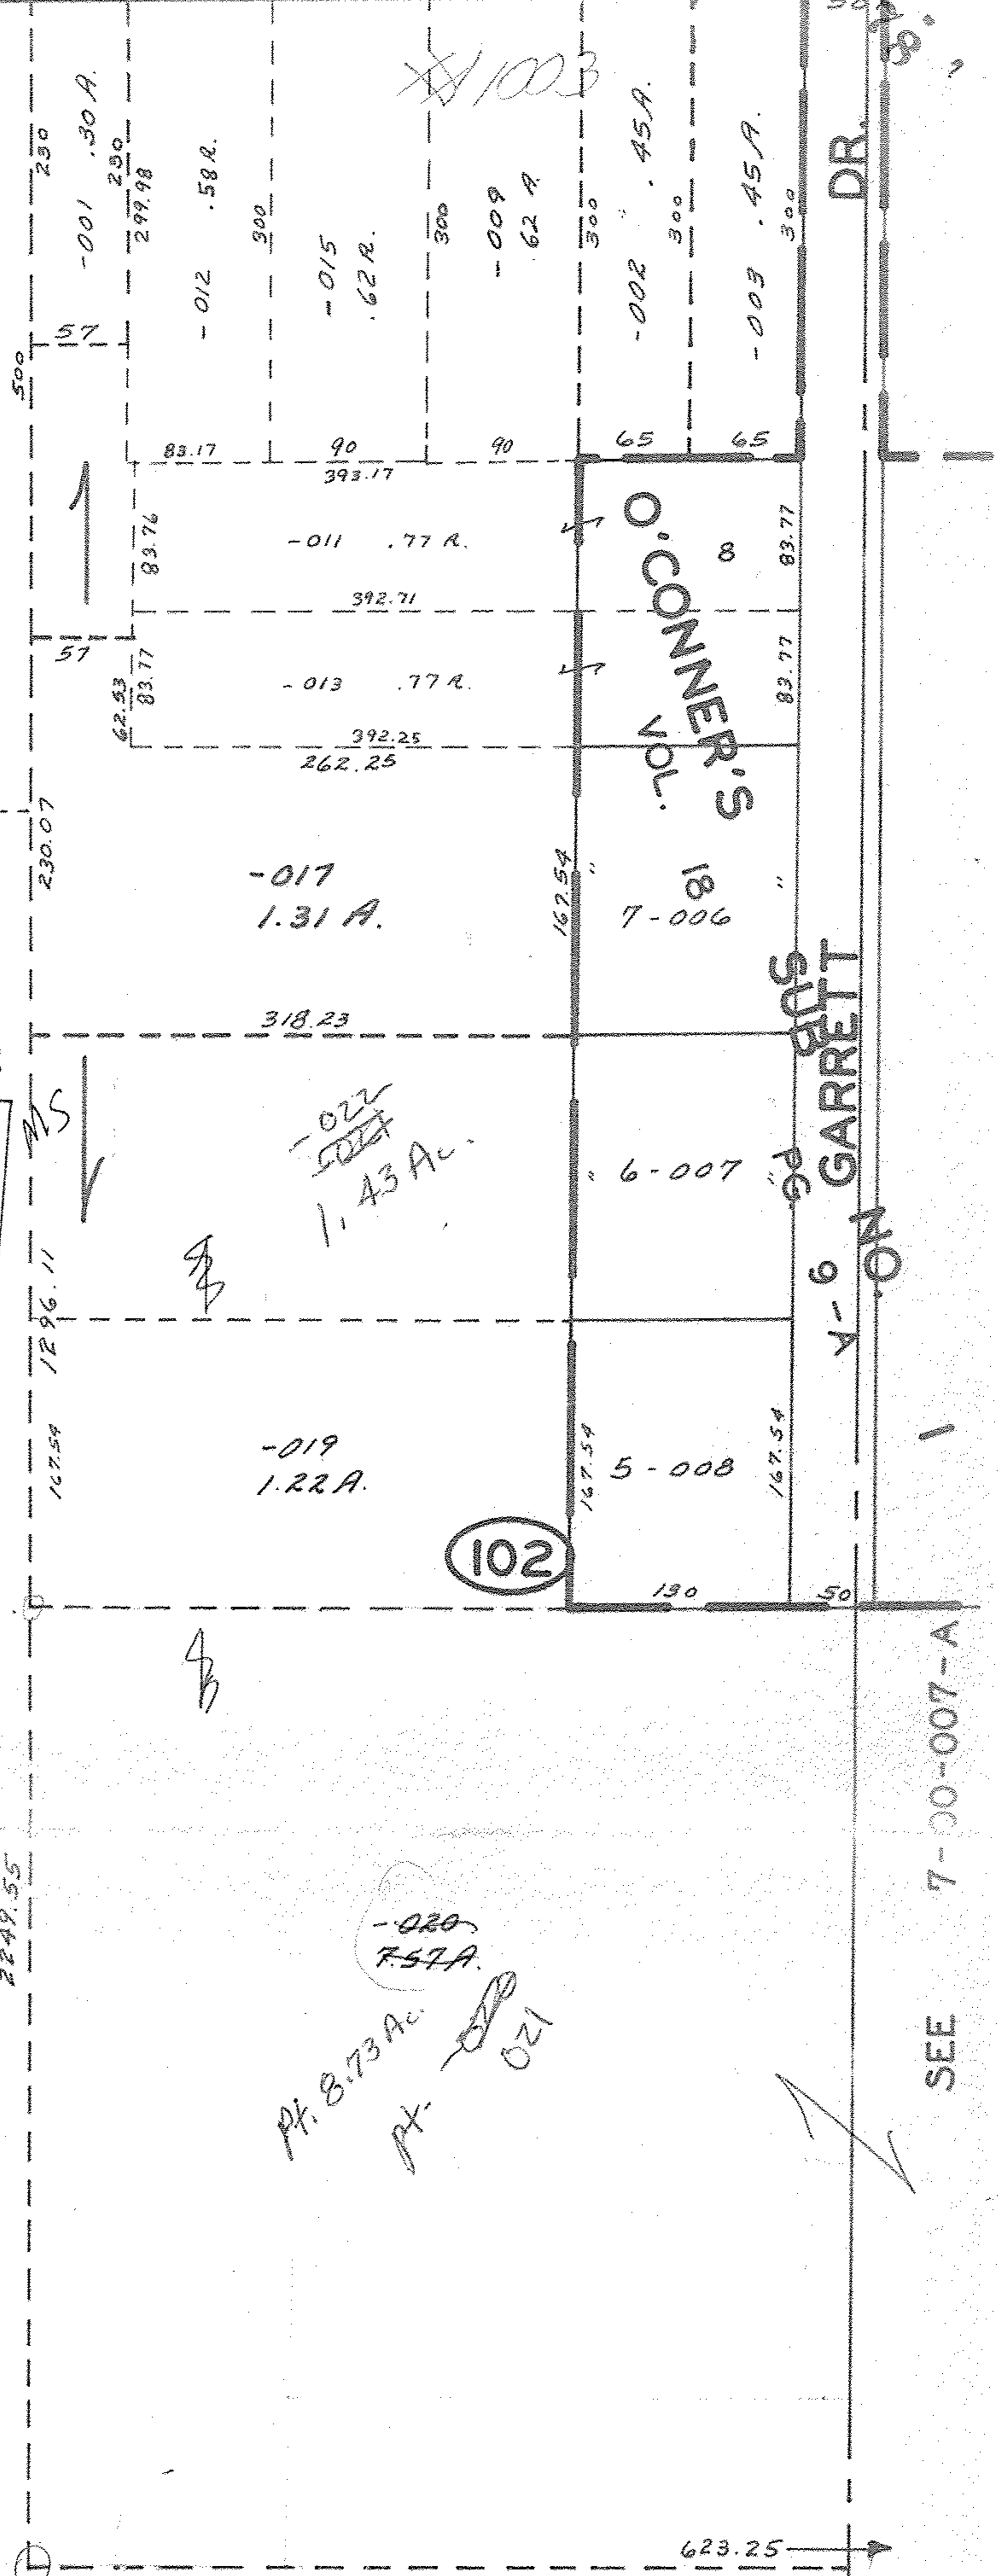

DR.

O'CONNOR'S
 VOL. 18
 7-006

Y-6 GARRETT

102

SEE 7-00-007-A

-020
 7.57 A.
 Pt. 8.73 Ac.
 Pt. 021

623.25