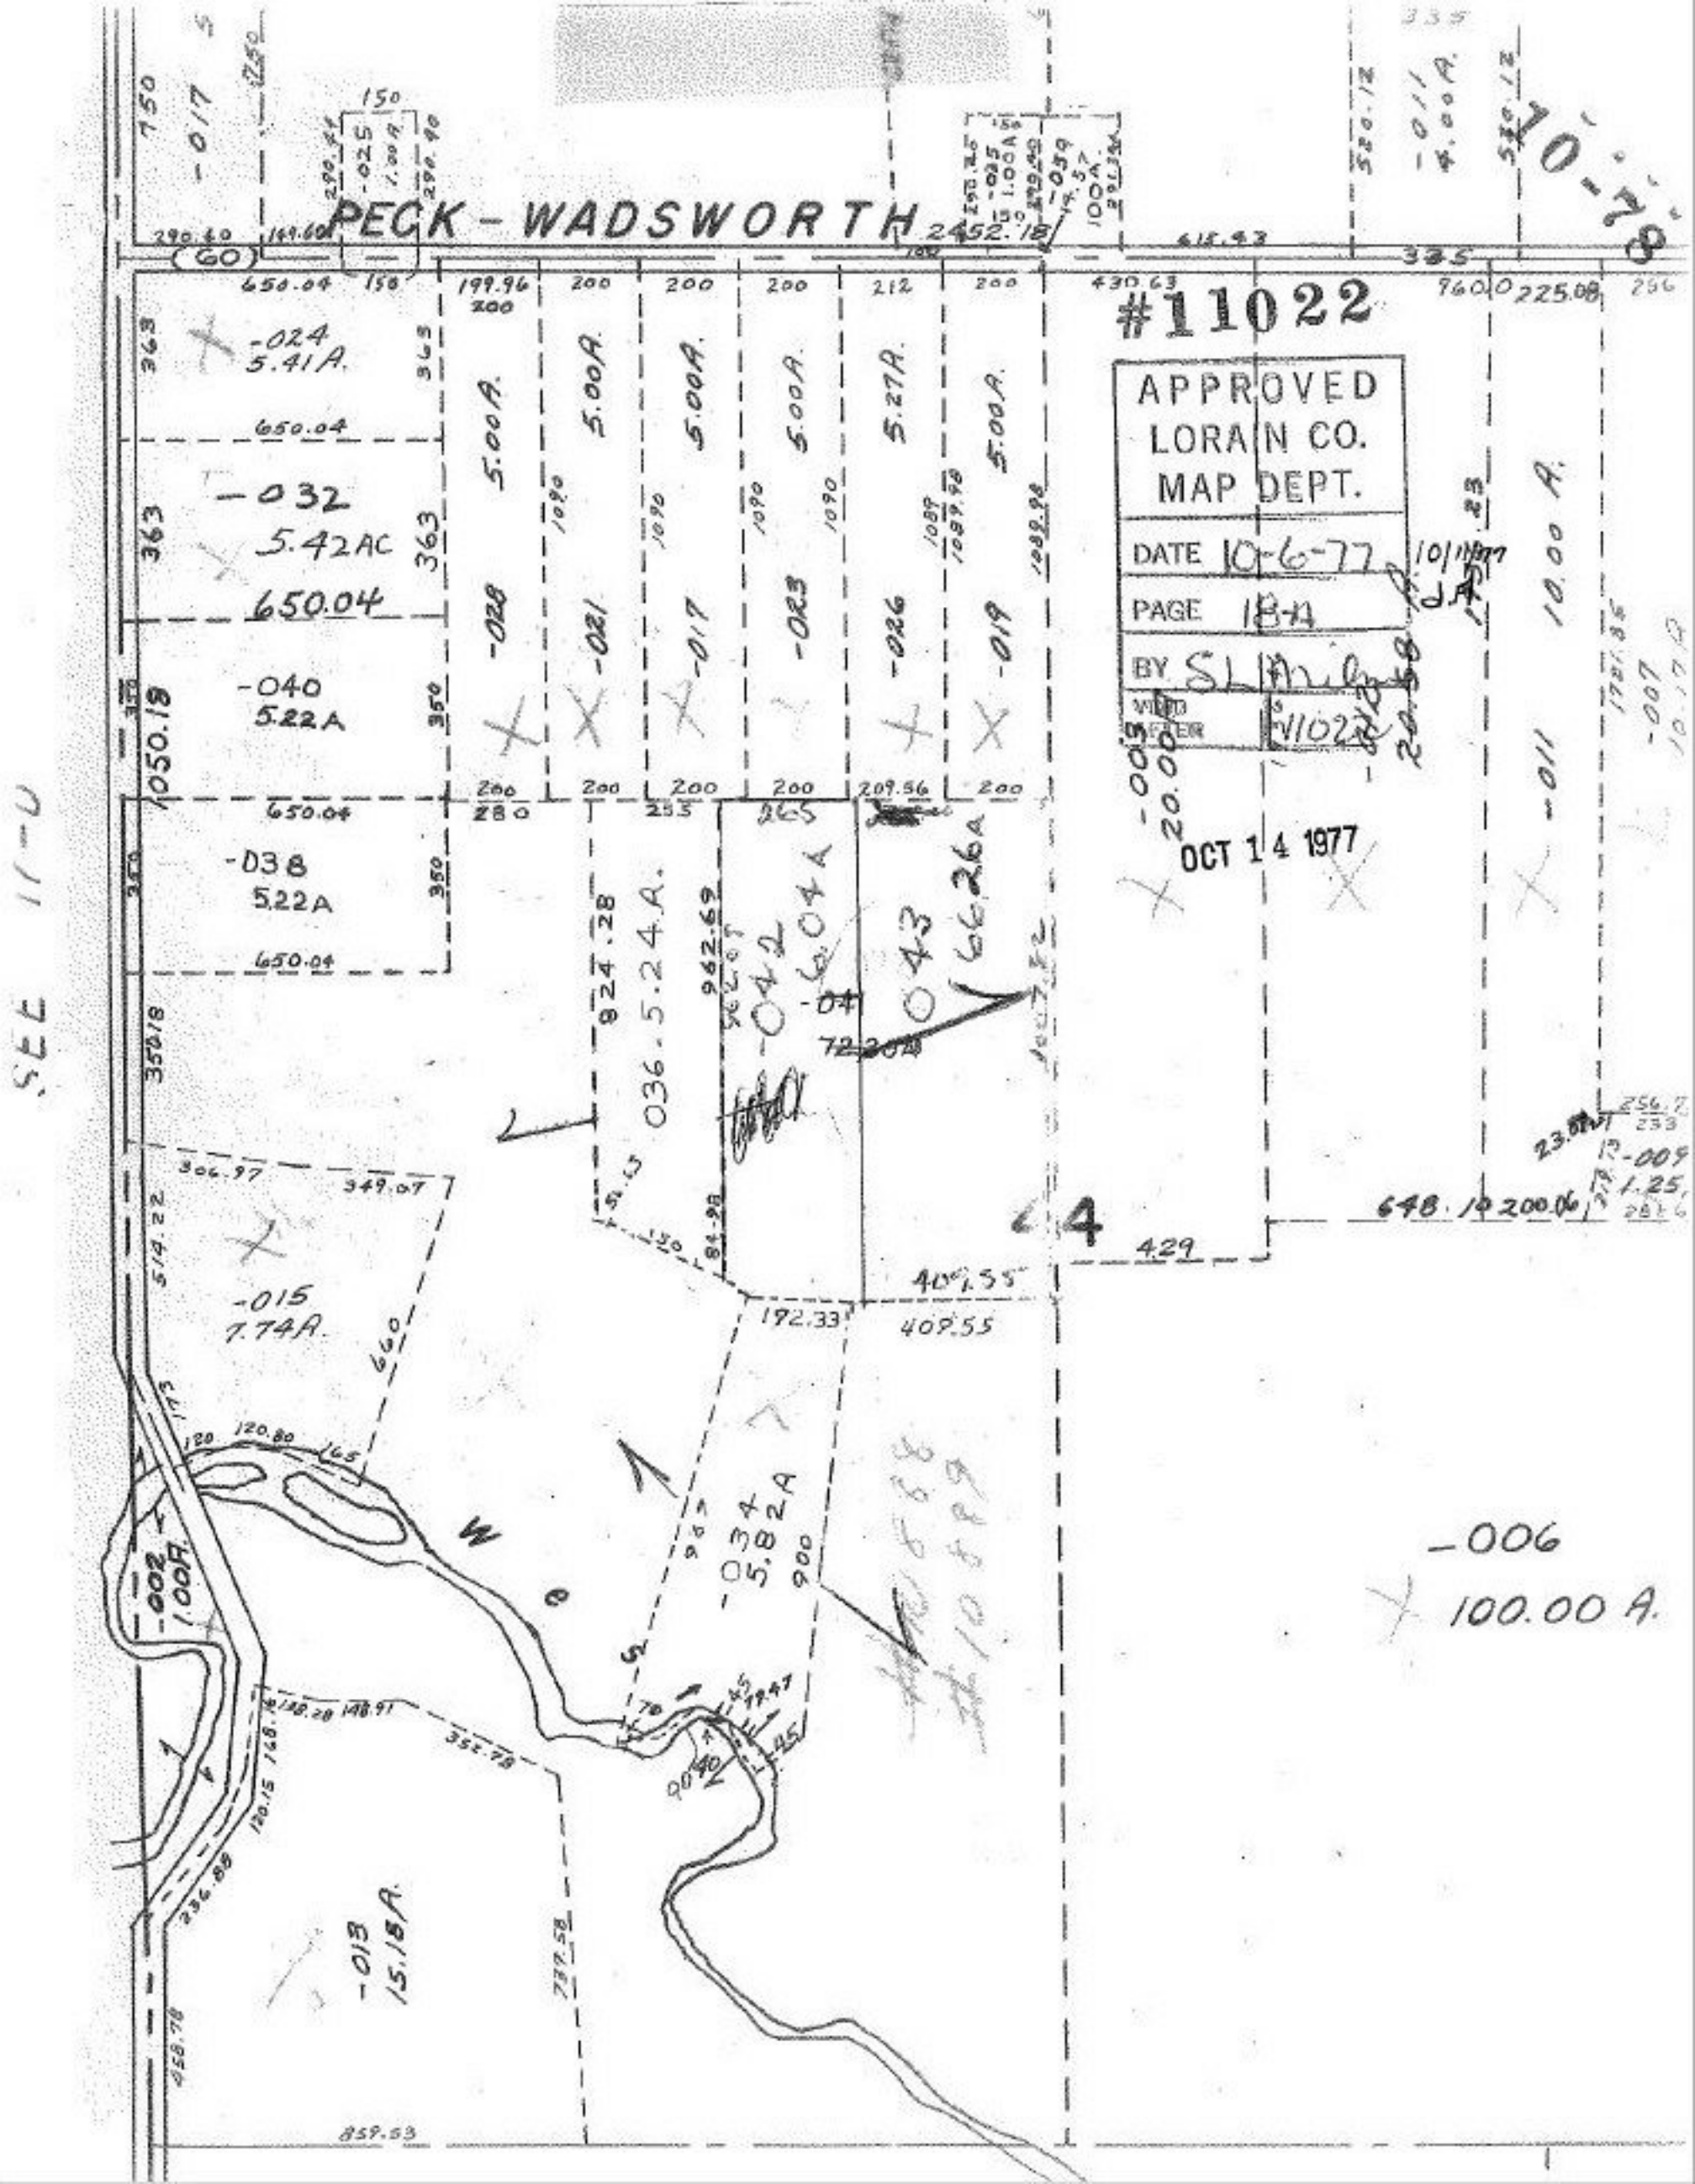

PECK - WADSWORTH
#11022
APPROVED
LORAIN CO.
MAP DEPT.
DATE 10-6-77
PAGE 18-A
BY
VIEWED
OFFER
OCT 14 1977
10-78
-024
5.41A.
-032
5.42AC
650.04
-040
5.22A
-038
5.22A
-015
7.74A.
-002
1.00A.
-013
15.18A.
-034
5.82A
-006
100.00 A.
-028
-021
-017
-023
-026
-019
5.00A.
5.27A.
10.00 A.
-011
-009
1.25
-042
6.04A
-043
66.26A
036.5.24A.
SEE 11-U