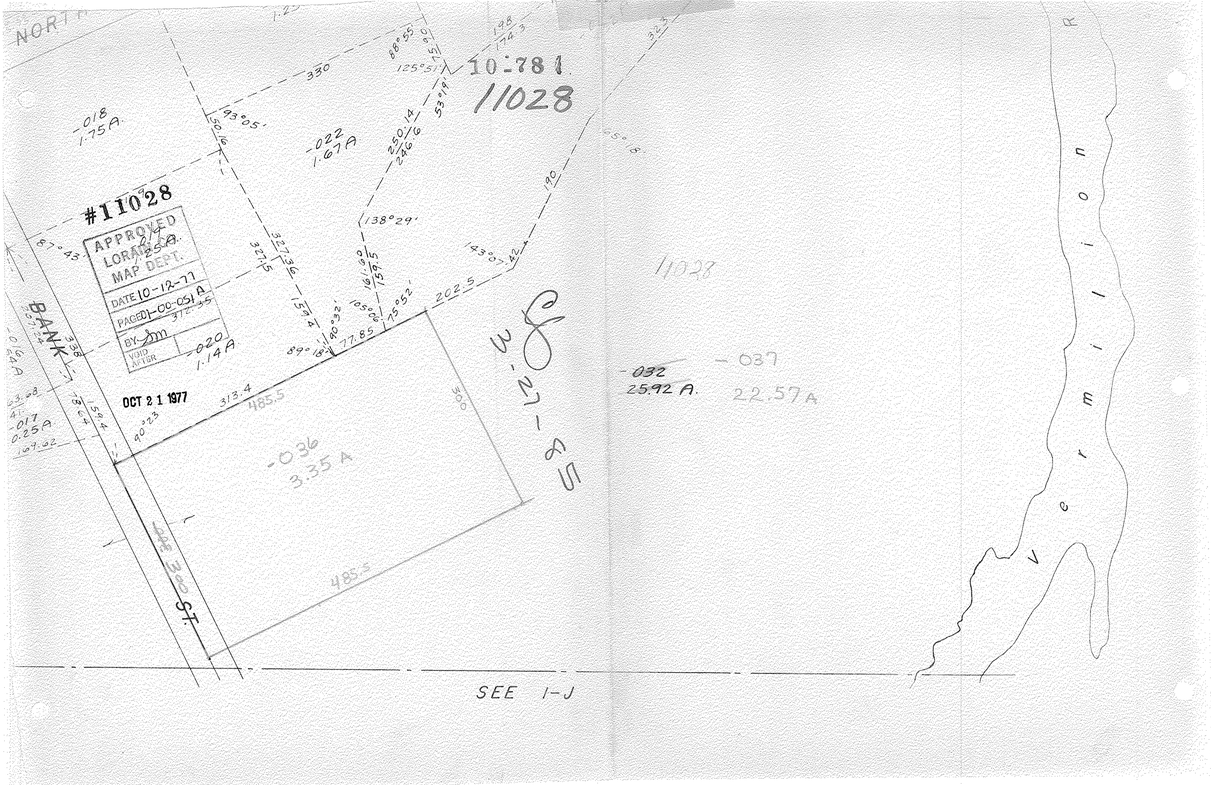
NORTH
10-78
11028
#11028
APPROVED
LORAIN CO.
MAP DEPT.
DATE 10-12-77
PAGE 1-CO-051 A
BY
VOID AFTER
OCT 21 1977
-018
1.75 A.
-022
1.67 A
-020
1.14 A
-036
3.35 A
-032
25.92 A.
-037
22.57 A
11028
BANK
Vermilion R
SEE 1-J