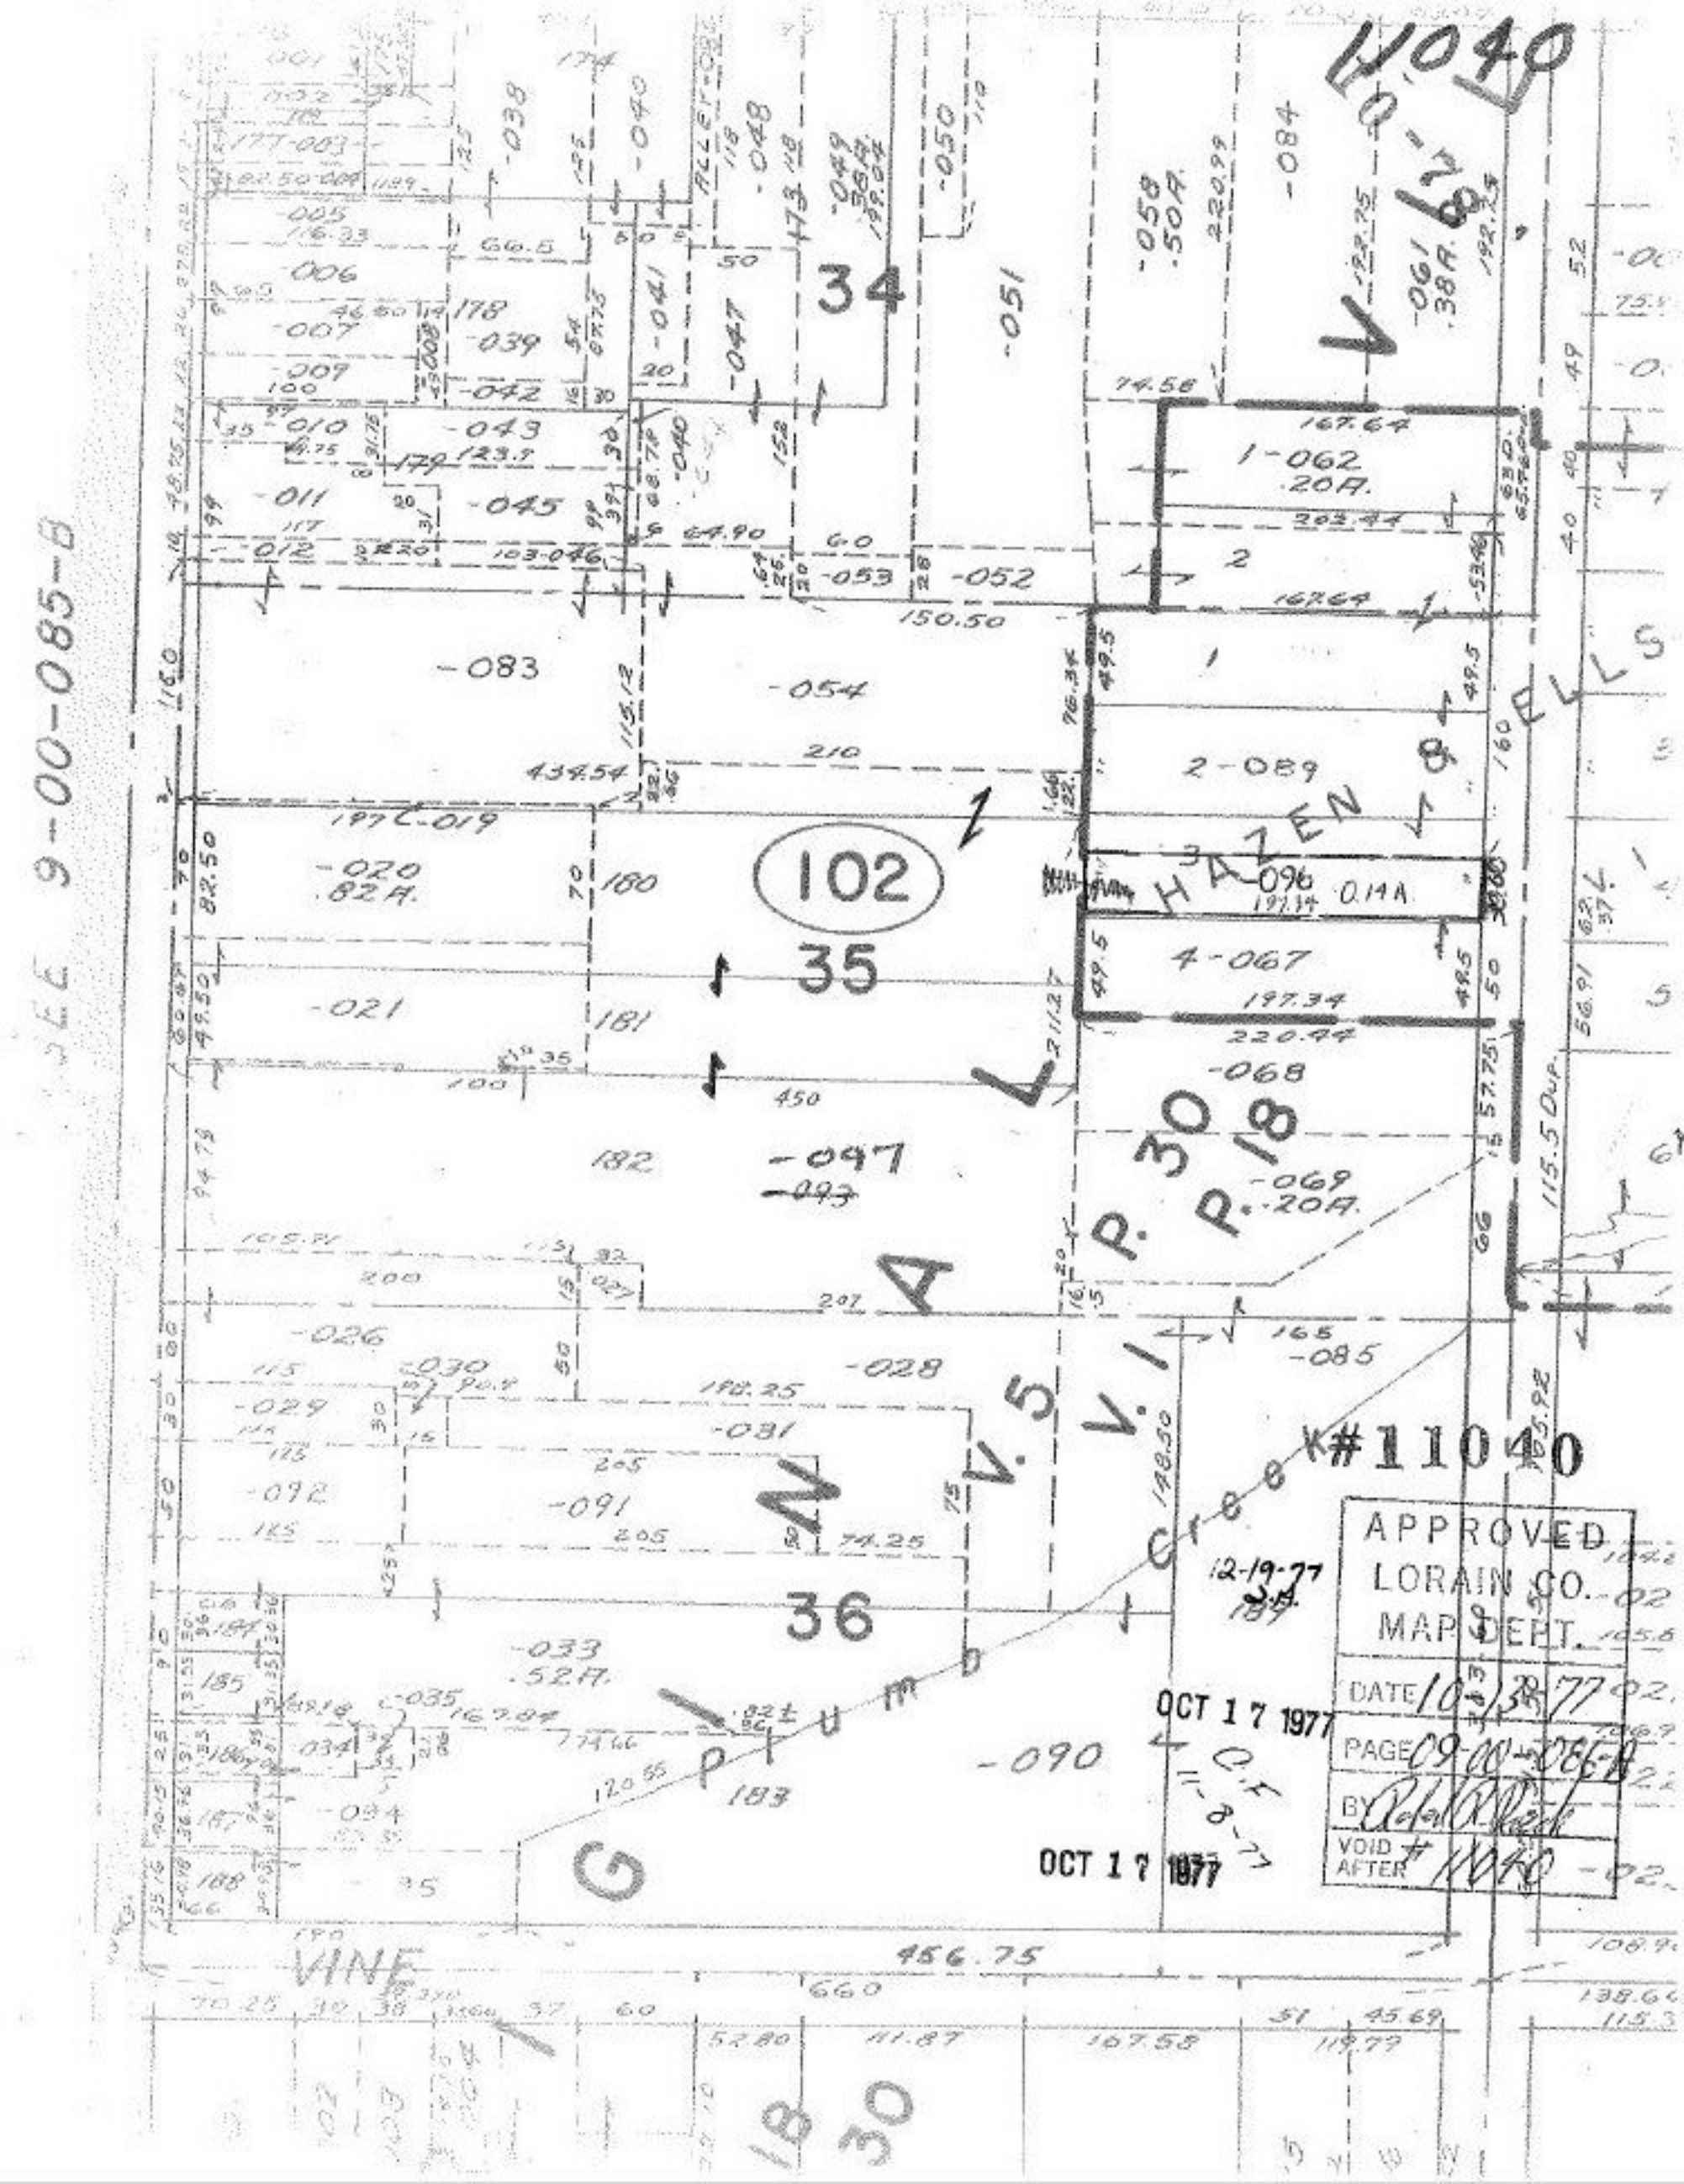

11040
SEE 9-00-085-B
34
35
36
102
HAZEN & ELLS
P. 30
P. 18
V. 5
V. 1
Plumb Creek
GIANA
VINE
#11040
APPROVED
LORAIN CO.
MAP DEPT.
DATE 10-13-77
PAGE 09-00-086-A
BY
VOID AFTER #11040
OCT 17 1977
OCT 17 1977
12-19-77