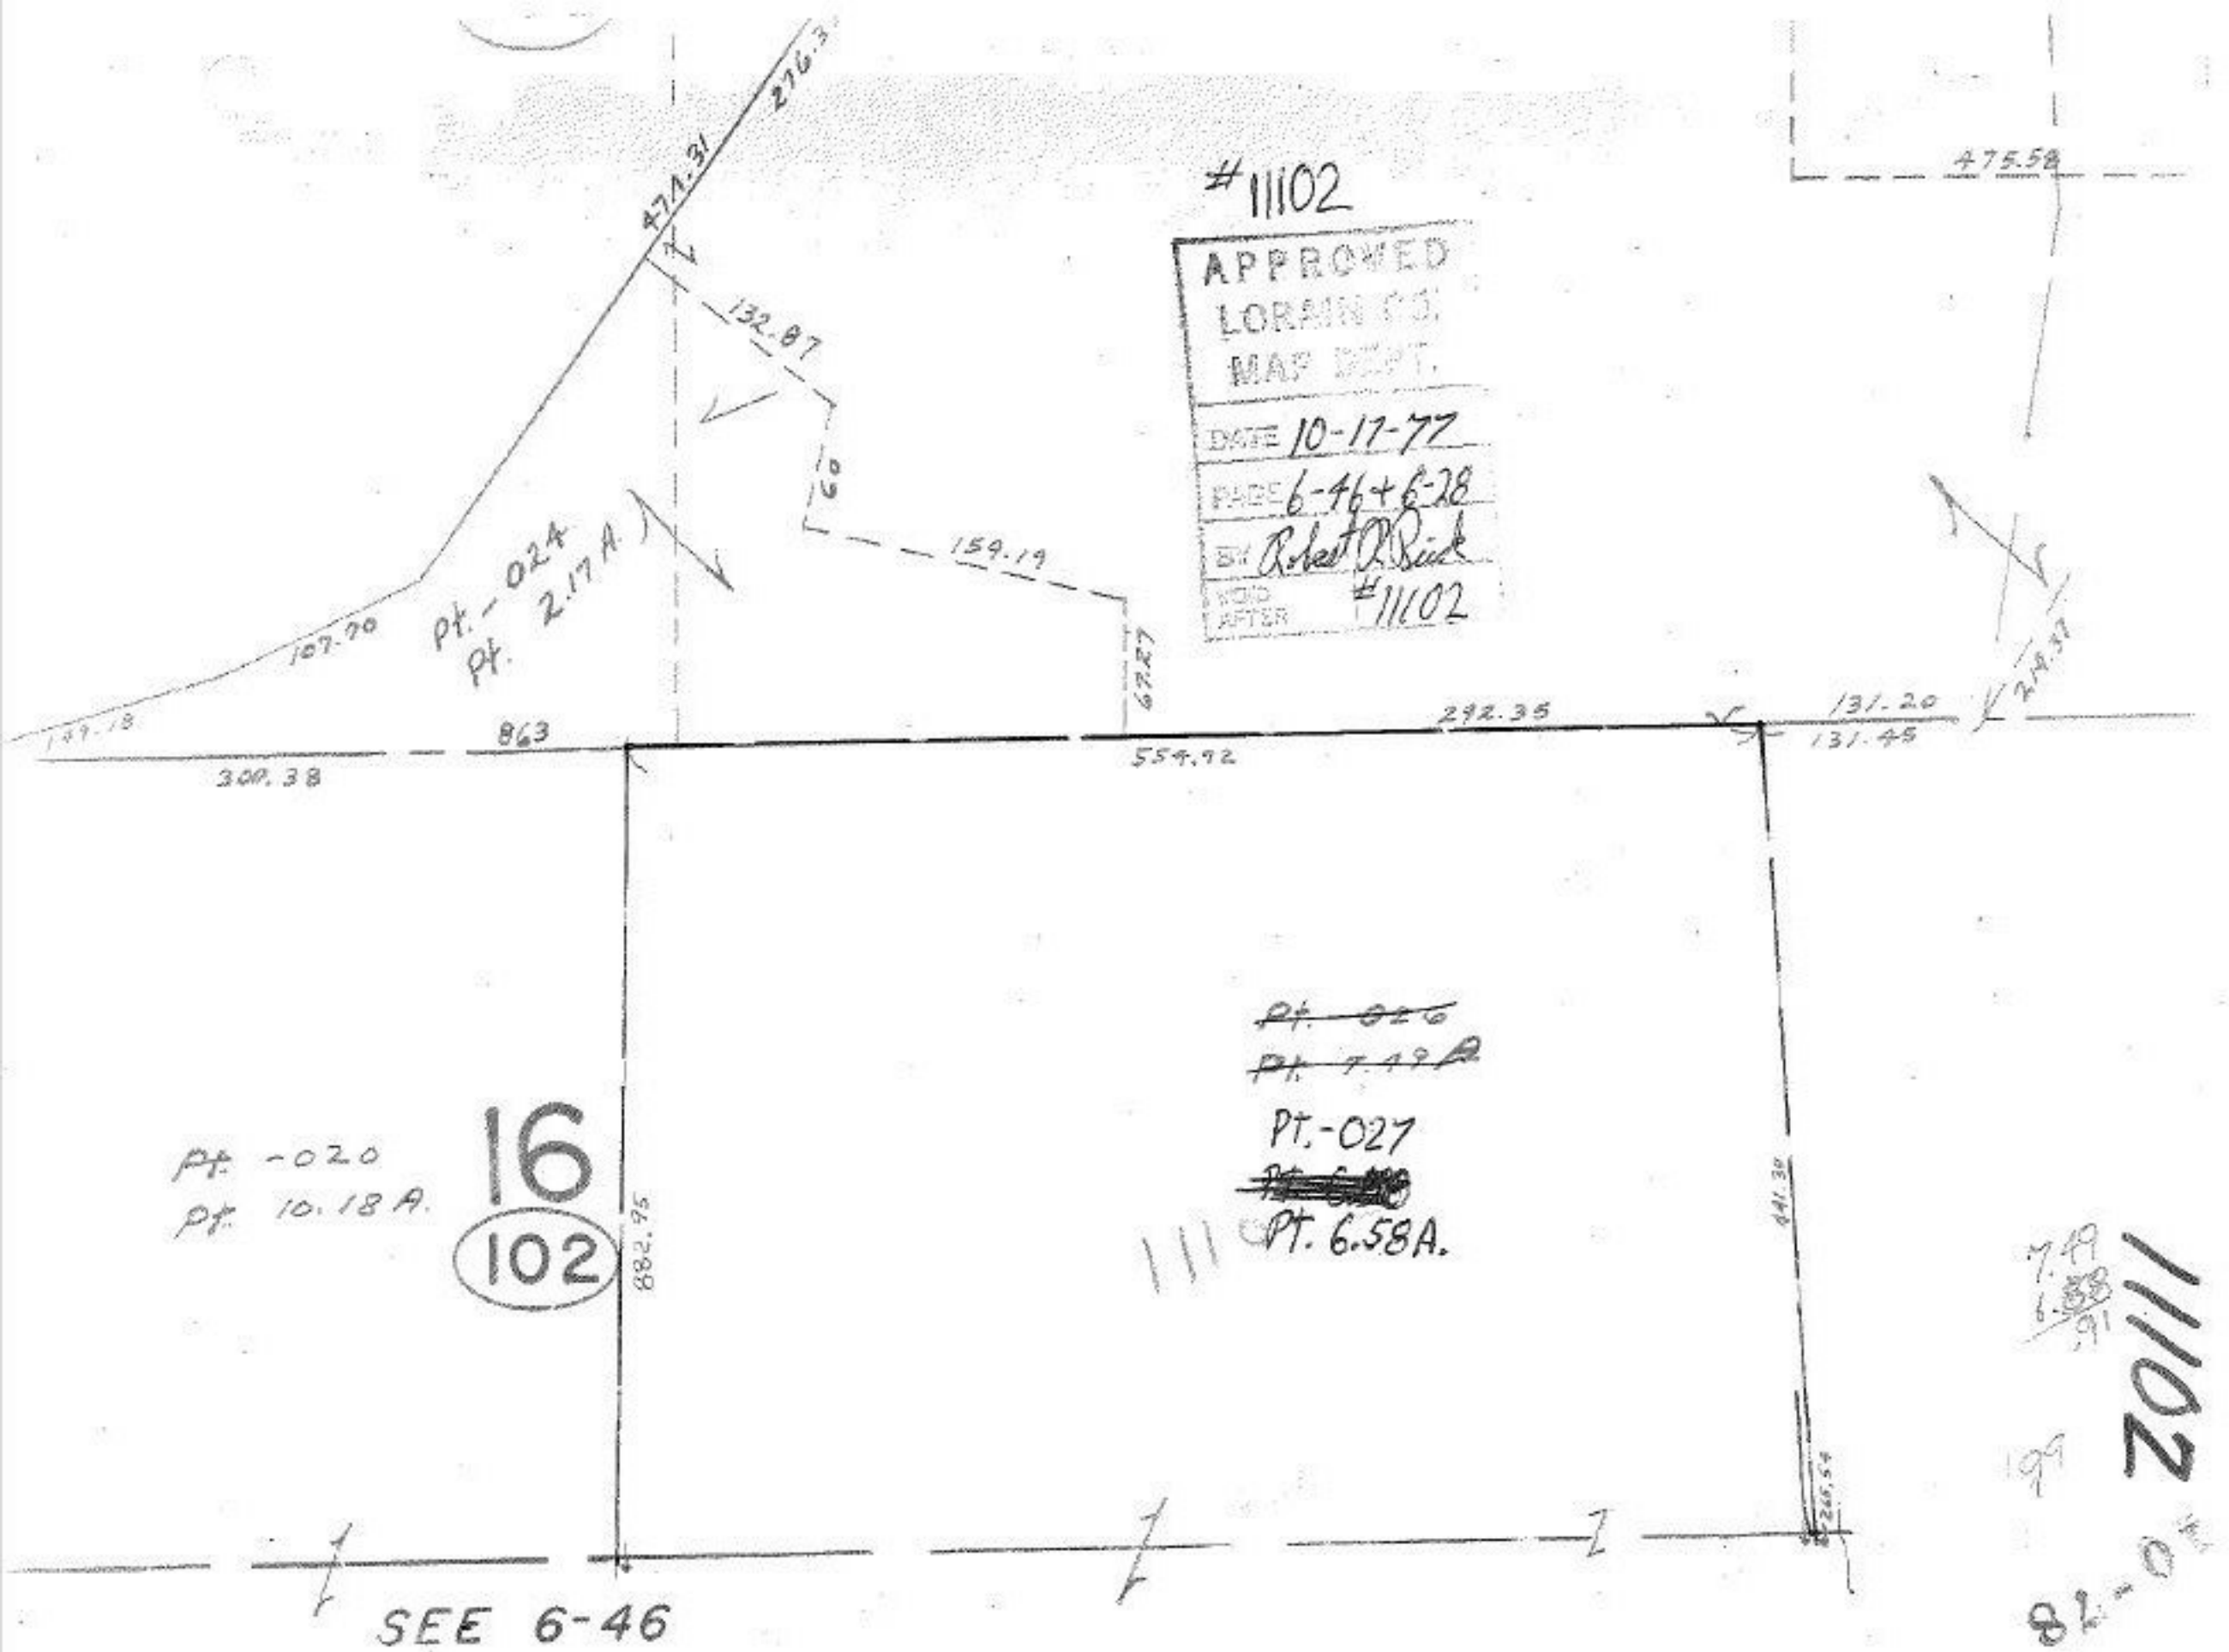

#11102
APPROVED
LORAIN CO.
MAP DEPT.
DATE 10-17-77
PAGE 6-46 + 6-28
BY Robert R. Rick
VOID AFTER #11102
276.3
474.31
132.87
60
159.19
67.27
107.70
149.18
863
300.38
554.92
292.35
131.20
131.45
475.58
214.37
Pt. -024
Pt. 2.17 A.
Pt. -020
Pt. 10.18 A.
16
102
882.95
Pt. -027
Pt. 6.58A.
441.30
266.54
7.49
6.88
.91
11102
SEE 6-46