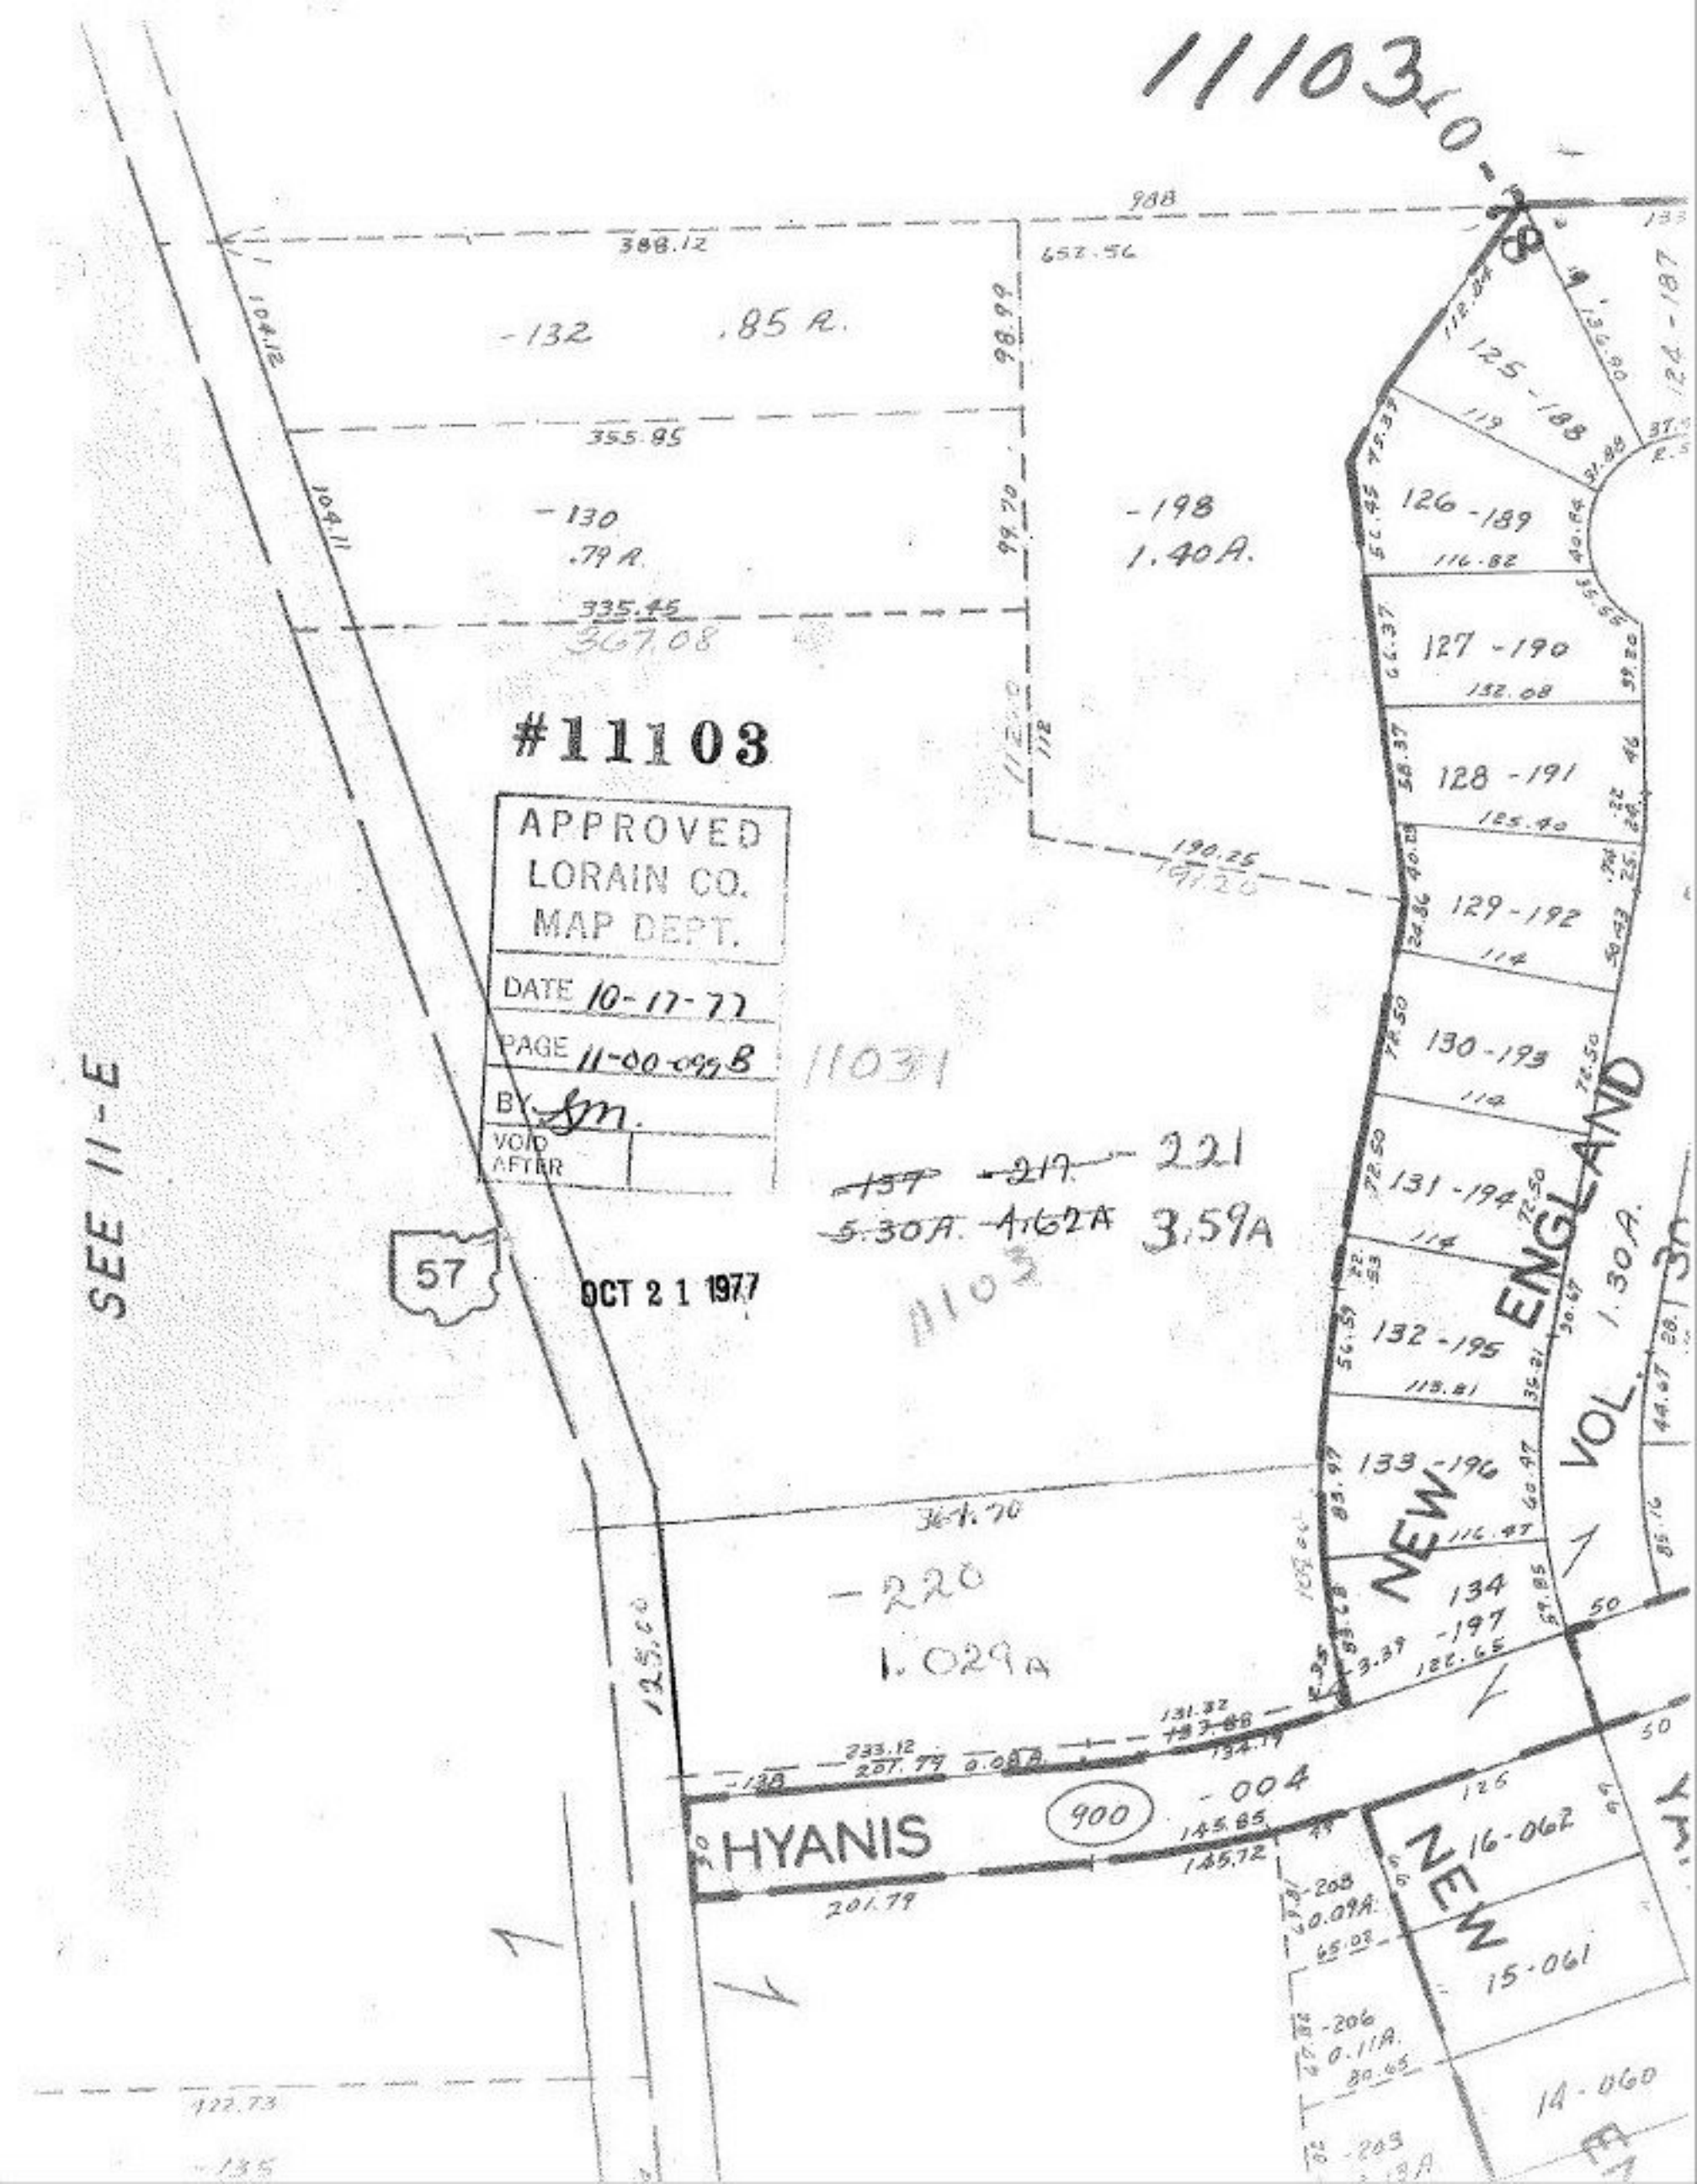
11103
#11103
APPROVED
LORAIN CO.
MAP DEPT.
DATE 10-17-77
PAGE 11-00-099B
BY Sm.
VOID AFTER
OCT 21 1977
11031
-137 -217 -221
5.30A. 4.62A 3.59A
11103
-132 .85 A.
-130 .79 A.
-198 1.40A.
-220 1.029A
-004
-208 0.09A.
-206 0.11A.
-203
125-188
126-189
127-190
128-191
129-192
130-193
131-194
132-195
133-196
134-197
16-062
15-061
14-060
NEW ENGLAND
VOL. 1.30A.
HYANIS
900
57
SEE 11-E
988
388.12
652.56
355.85
335.45
367.08
190.25
364.70
125.00
422.73
104.12
104.11
98.99
99.70
112.04
136.90
124-187
116.82
132.08
125.40
114
113.81
116.47
122.65
131.32
233.12
201.79
145.85
145.72