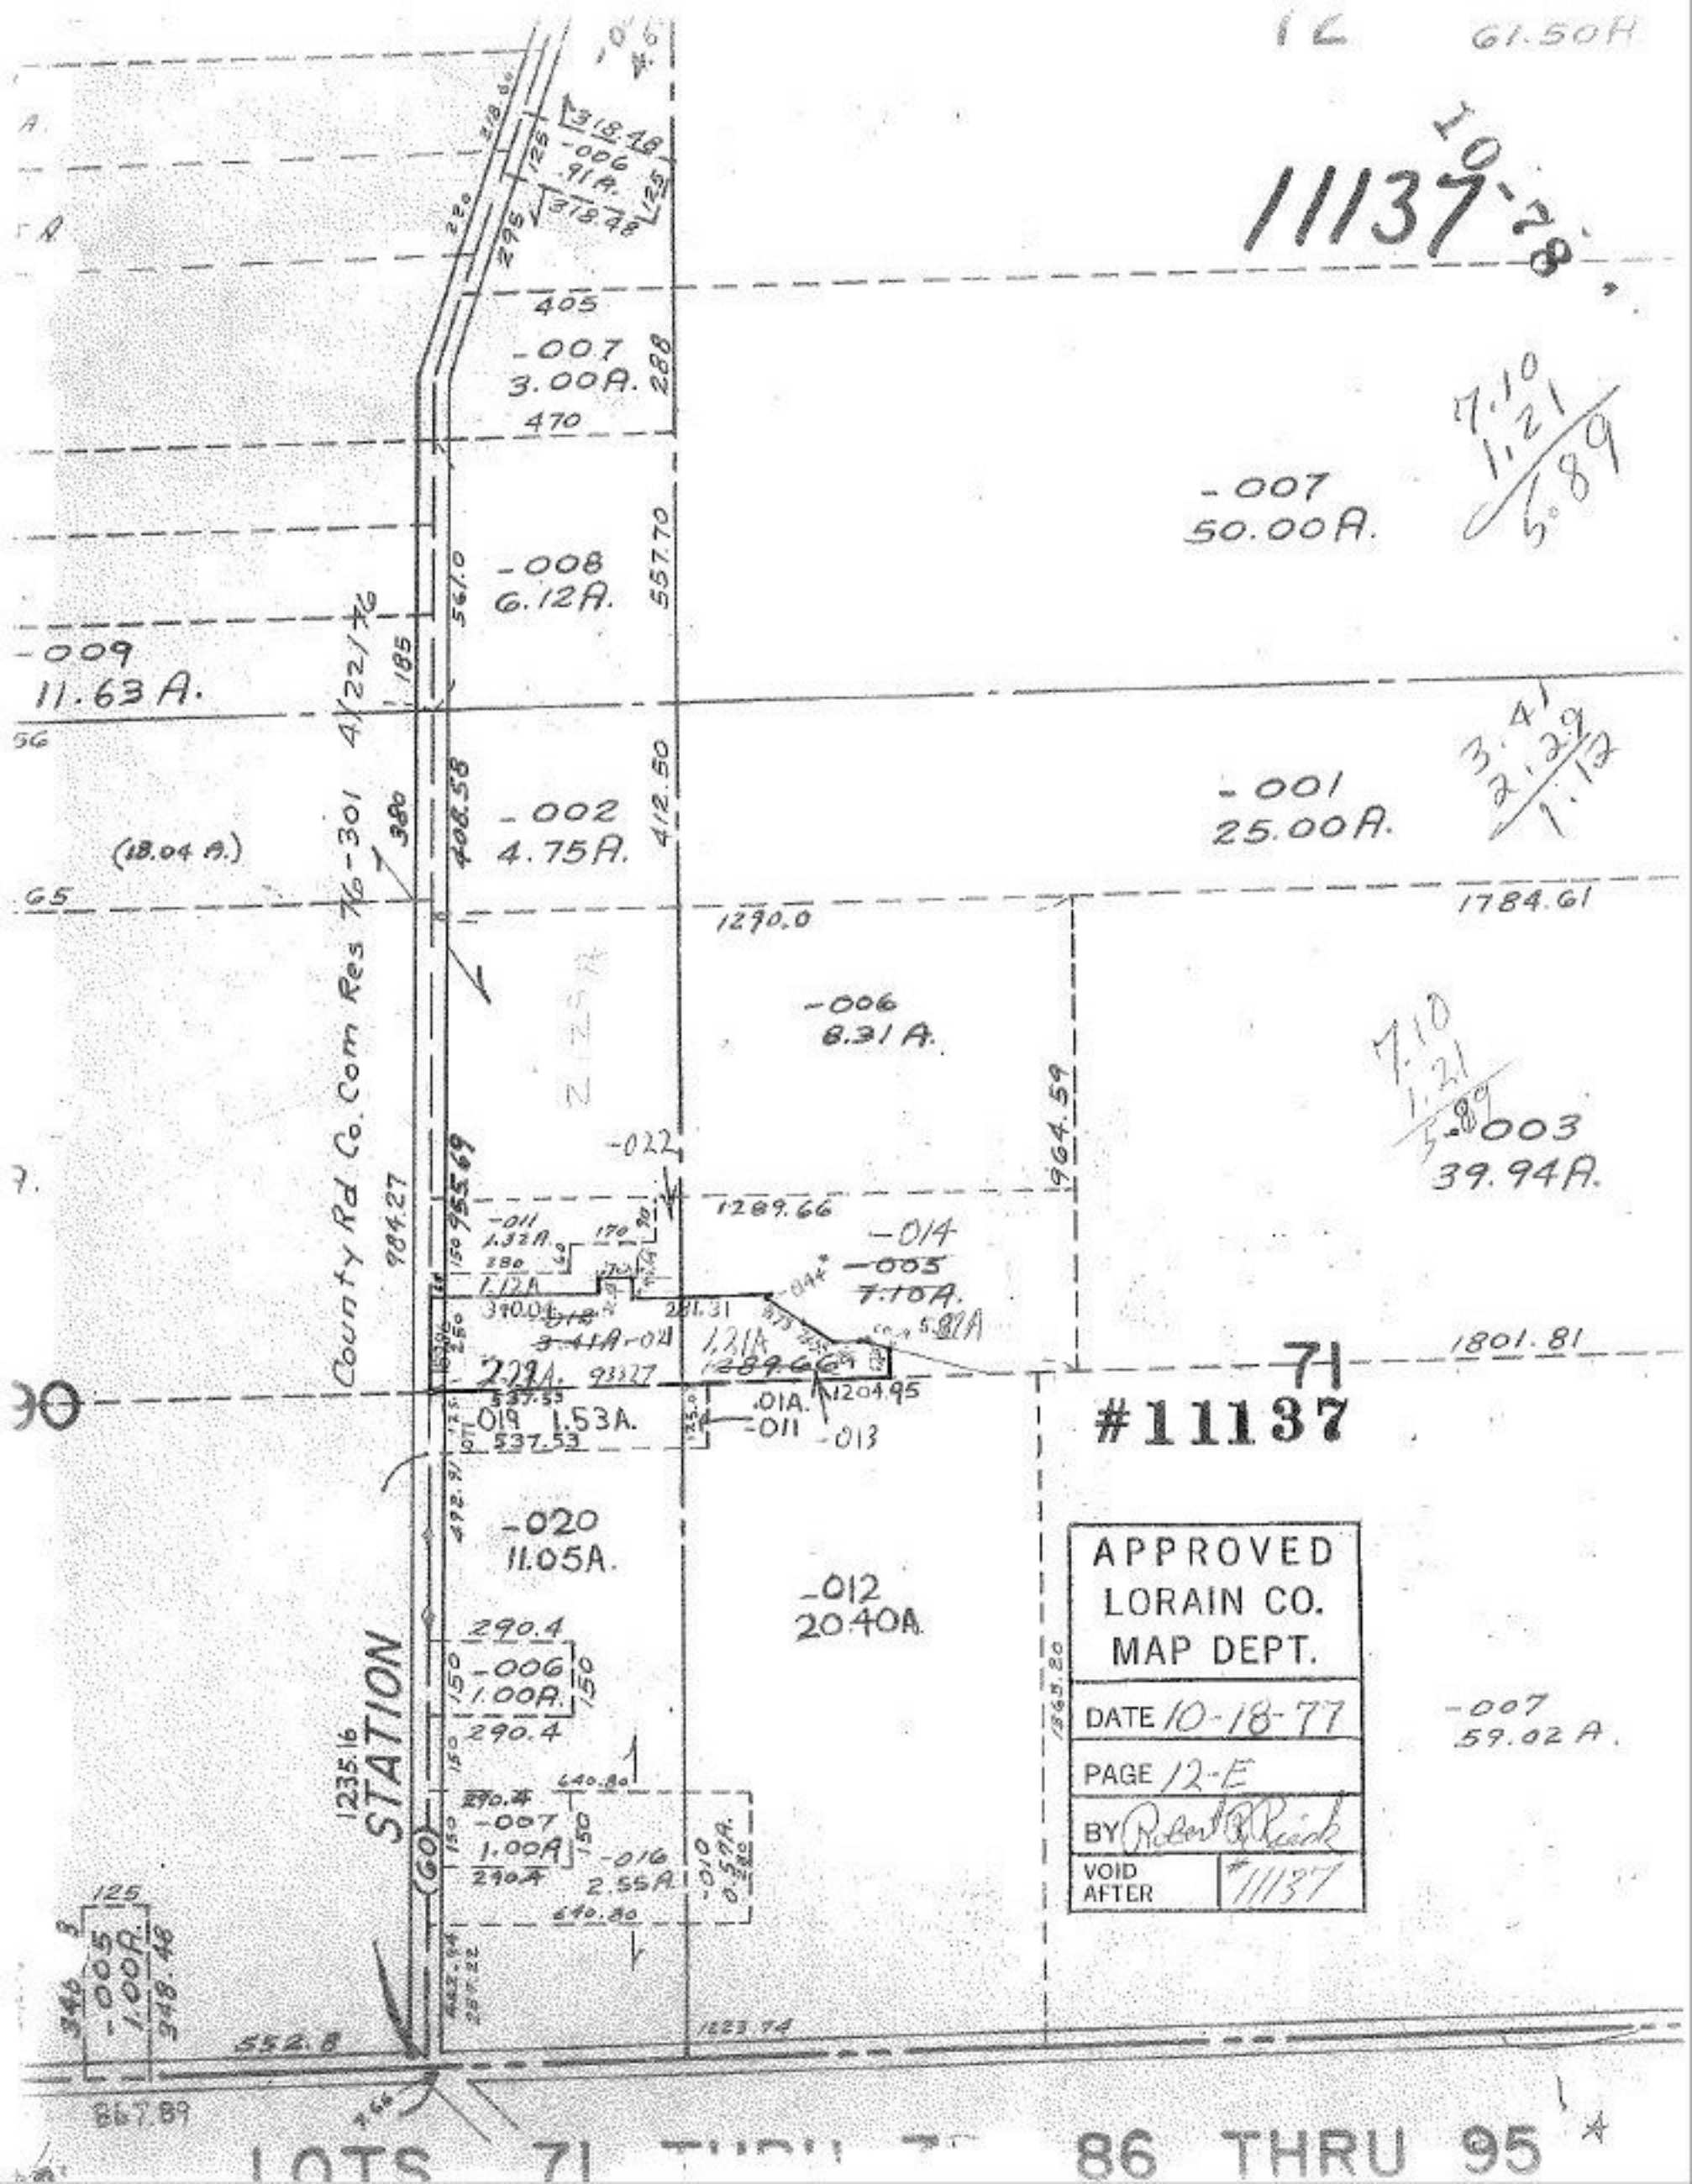

12
61.50A
11137
10-78
-007
3.00A.
-008
6.12A.
-009
11.63A.
-002
4.75A.
(18.04 A.)
-007
50.00A.
-001
25.00A.
-006
8.31A.
-003
39.94A.
-014
-005
7.10A.
-020
11.05A.
-012
20.40A.
-006
1.00A.
-007
1.00A
-016
2.55A.
-007
59.02A.
County Rd Co. Com Res 76-301
STATION
1235.16
1784.61
1290.0
1289.66
1801.81
964.59
1204.95
1223.74
552.8
867.89
#11137
APPROVED
LORAIN CO.
MAP DEPT.
DATE 10-18-77
PAGE 12-E
BY Robert R. Rieck
VOID AFTER #11137
LOTS 71 THRU 86 THRU 95