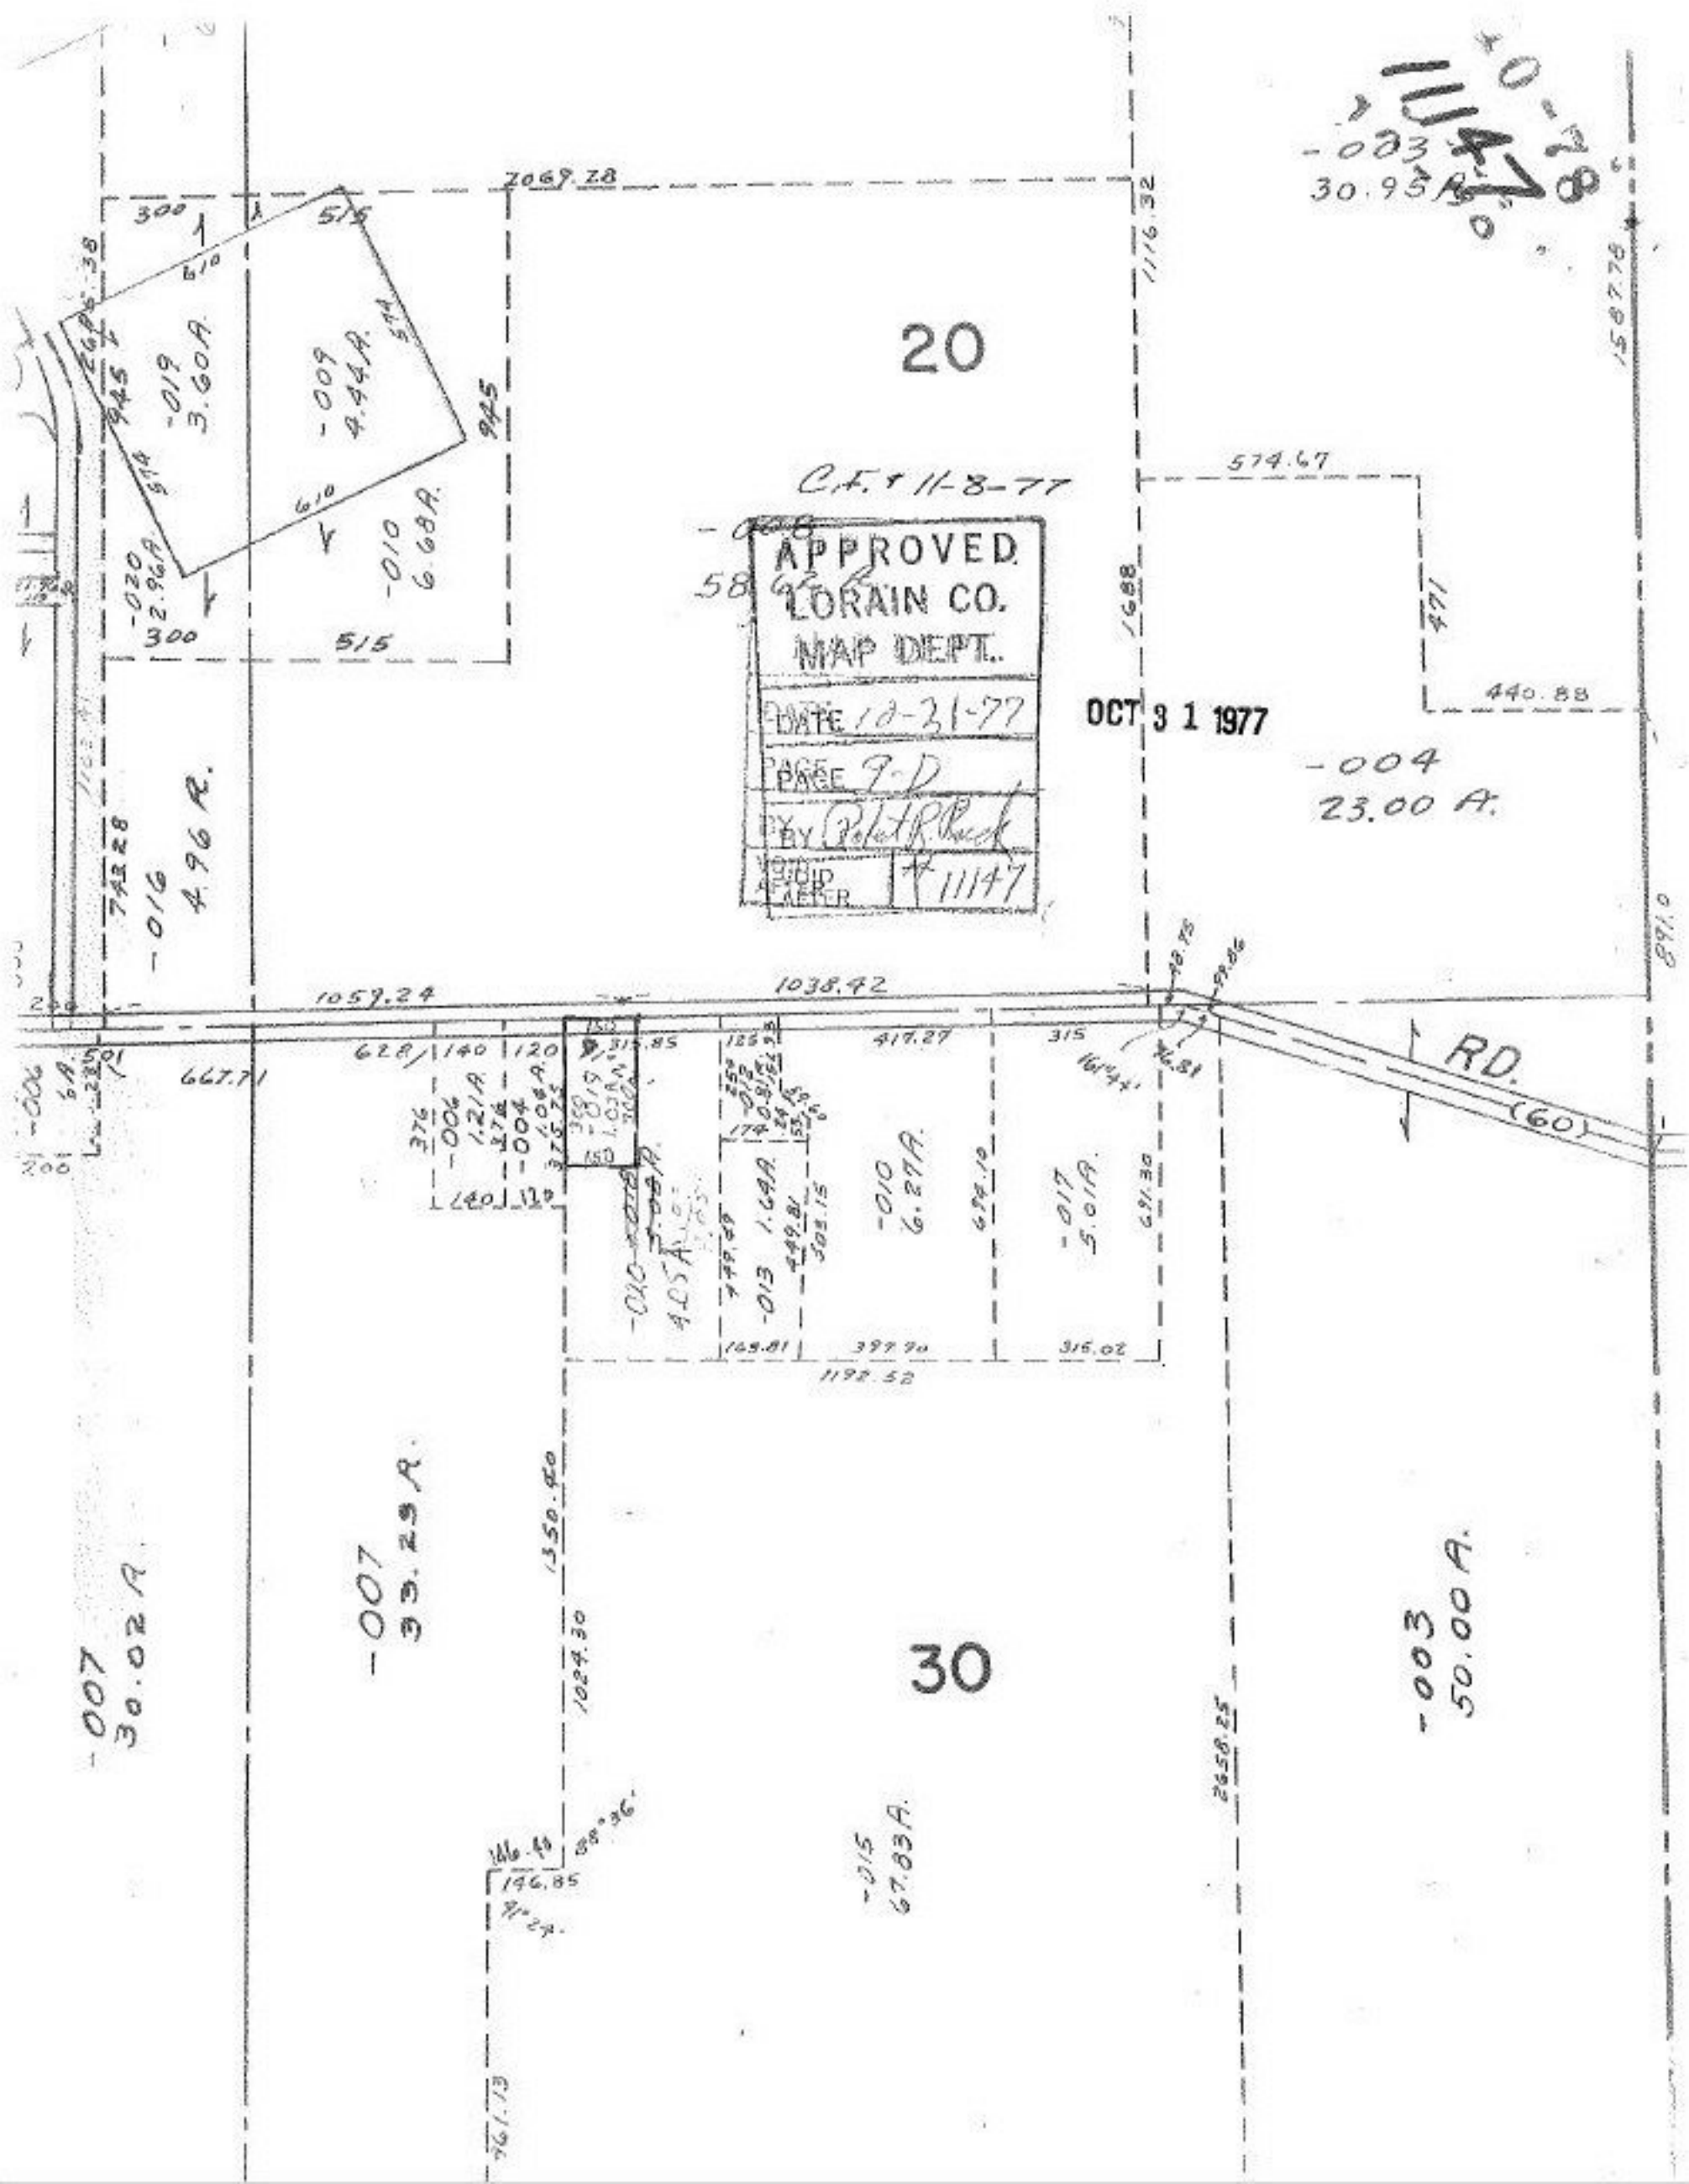

20
30
C.F. + 11-8-77
APPROVED
LORAIN CO.
MAP DEPT.
DATE 10-31-77
PAGE 9-D
BY
VOID AFTER
11147
OCT 31 1977
-003
30.95 A.
-004
23.00 A.
-019
3.60 A.
-009
4.44 A.
-010
6.68 A.
-020
2.96 A.
-016
4.96 A.
-006
1.21 A.
-004
1.04 A.
-013
1.64 A.
-010
6.27 A.
-017
5.01 A.
-007
33.29 A.
-007
30.02 A.
-003
50.00 A.
-015
67.83 A.
RD.
(60)
2069.28
1116.32
1587.78
574.67
440.88
1688
471
1059.24
1038.42
417.27
315
1192.52
1350.40
1024.30
2658.25
891.0