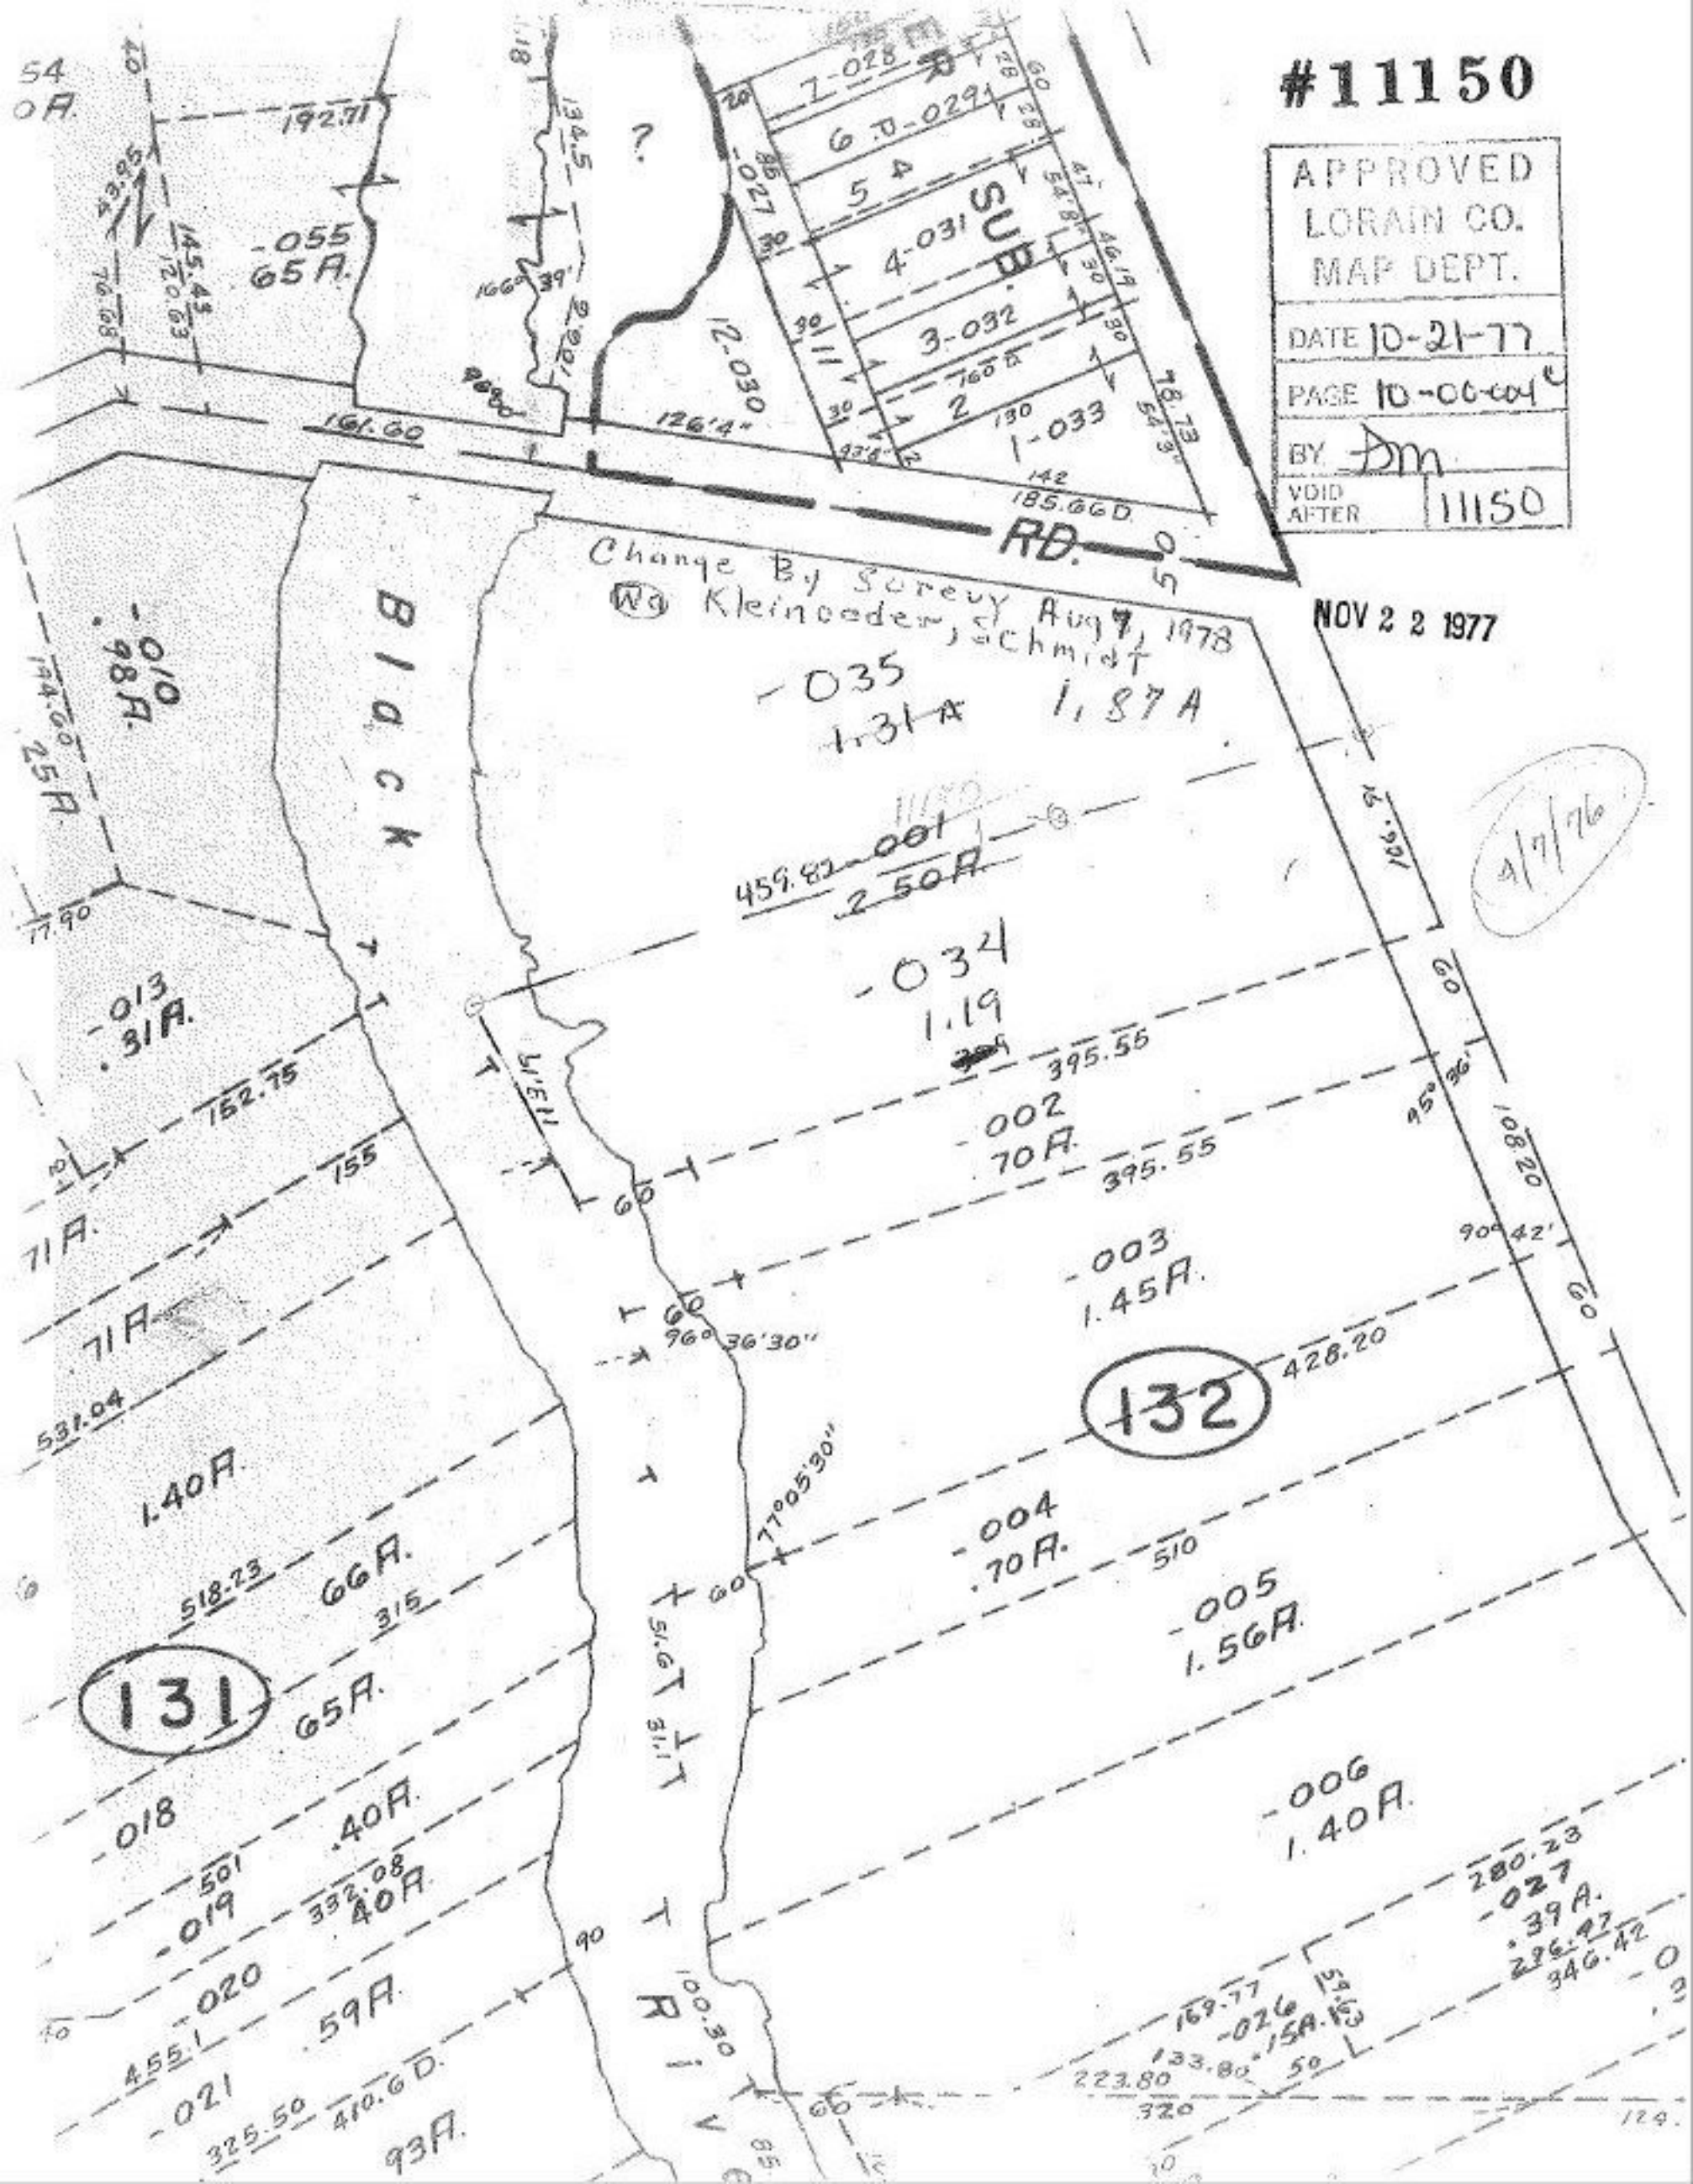
#11150
APPROVED
LORAIN CO.
MAP DEPT.
DATE 10-21-77
PAGE 10-00-004
BY Dm
VOID AFTER 11150
NOV 2 2 1977
4/7/76
Change By Survey Aug 7, 1978
Kleinoeder, Schmidt
SUB.
RD.
Black
River
131
132
-055
65 A.
-010
.98 A.
-013
.31 A.
-035
1.31 A
1.87 A
-001
2.50 A.
-034
1.19
-002
.70 A.
-003
1.45 A.
-004
.70 A.
-005
1.56 A.
-006
1.40 A.
-027
.39 A.
-026
.15 A.
-018
.40 A.
-019
.40 A.
-020
.59 A.
-021
93 A.
1.40 A.
66 A.
65 A.
71 A.
71 A.
-027
12-030
4-031
3-032
1-033
7-028
6-029
5
4
3
2
1
161.60
126'4"
185.66 D.
192.71
134.5
166° 39'
106.6
96° 36'30"
77°05'30"
95° 36'
90° 42'
108.20
428.20
510
280.23
346.42
169.77
133.80
223.80
320
100.30
51.6
31.1
51.6
31.1
395.55
395.55
459.82
152.75
155
531.04
518.23
315
501
332.08
455.1
325.50
410.6 D.
17.90
194.60
25 A.
43.95
145.43
120.63
76.68
78.73
54'3"
46.19
54'8"
47
60
90
124.