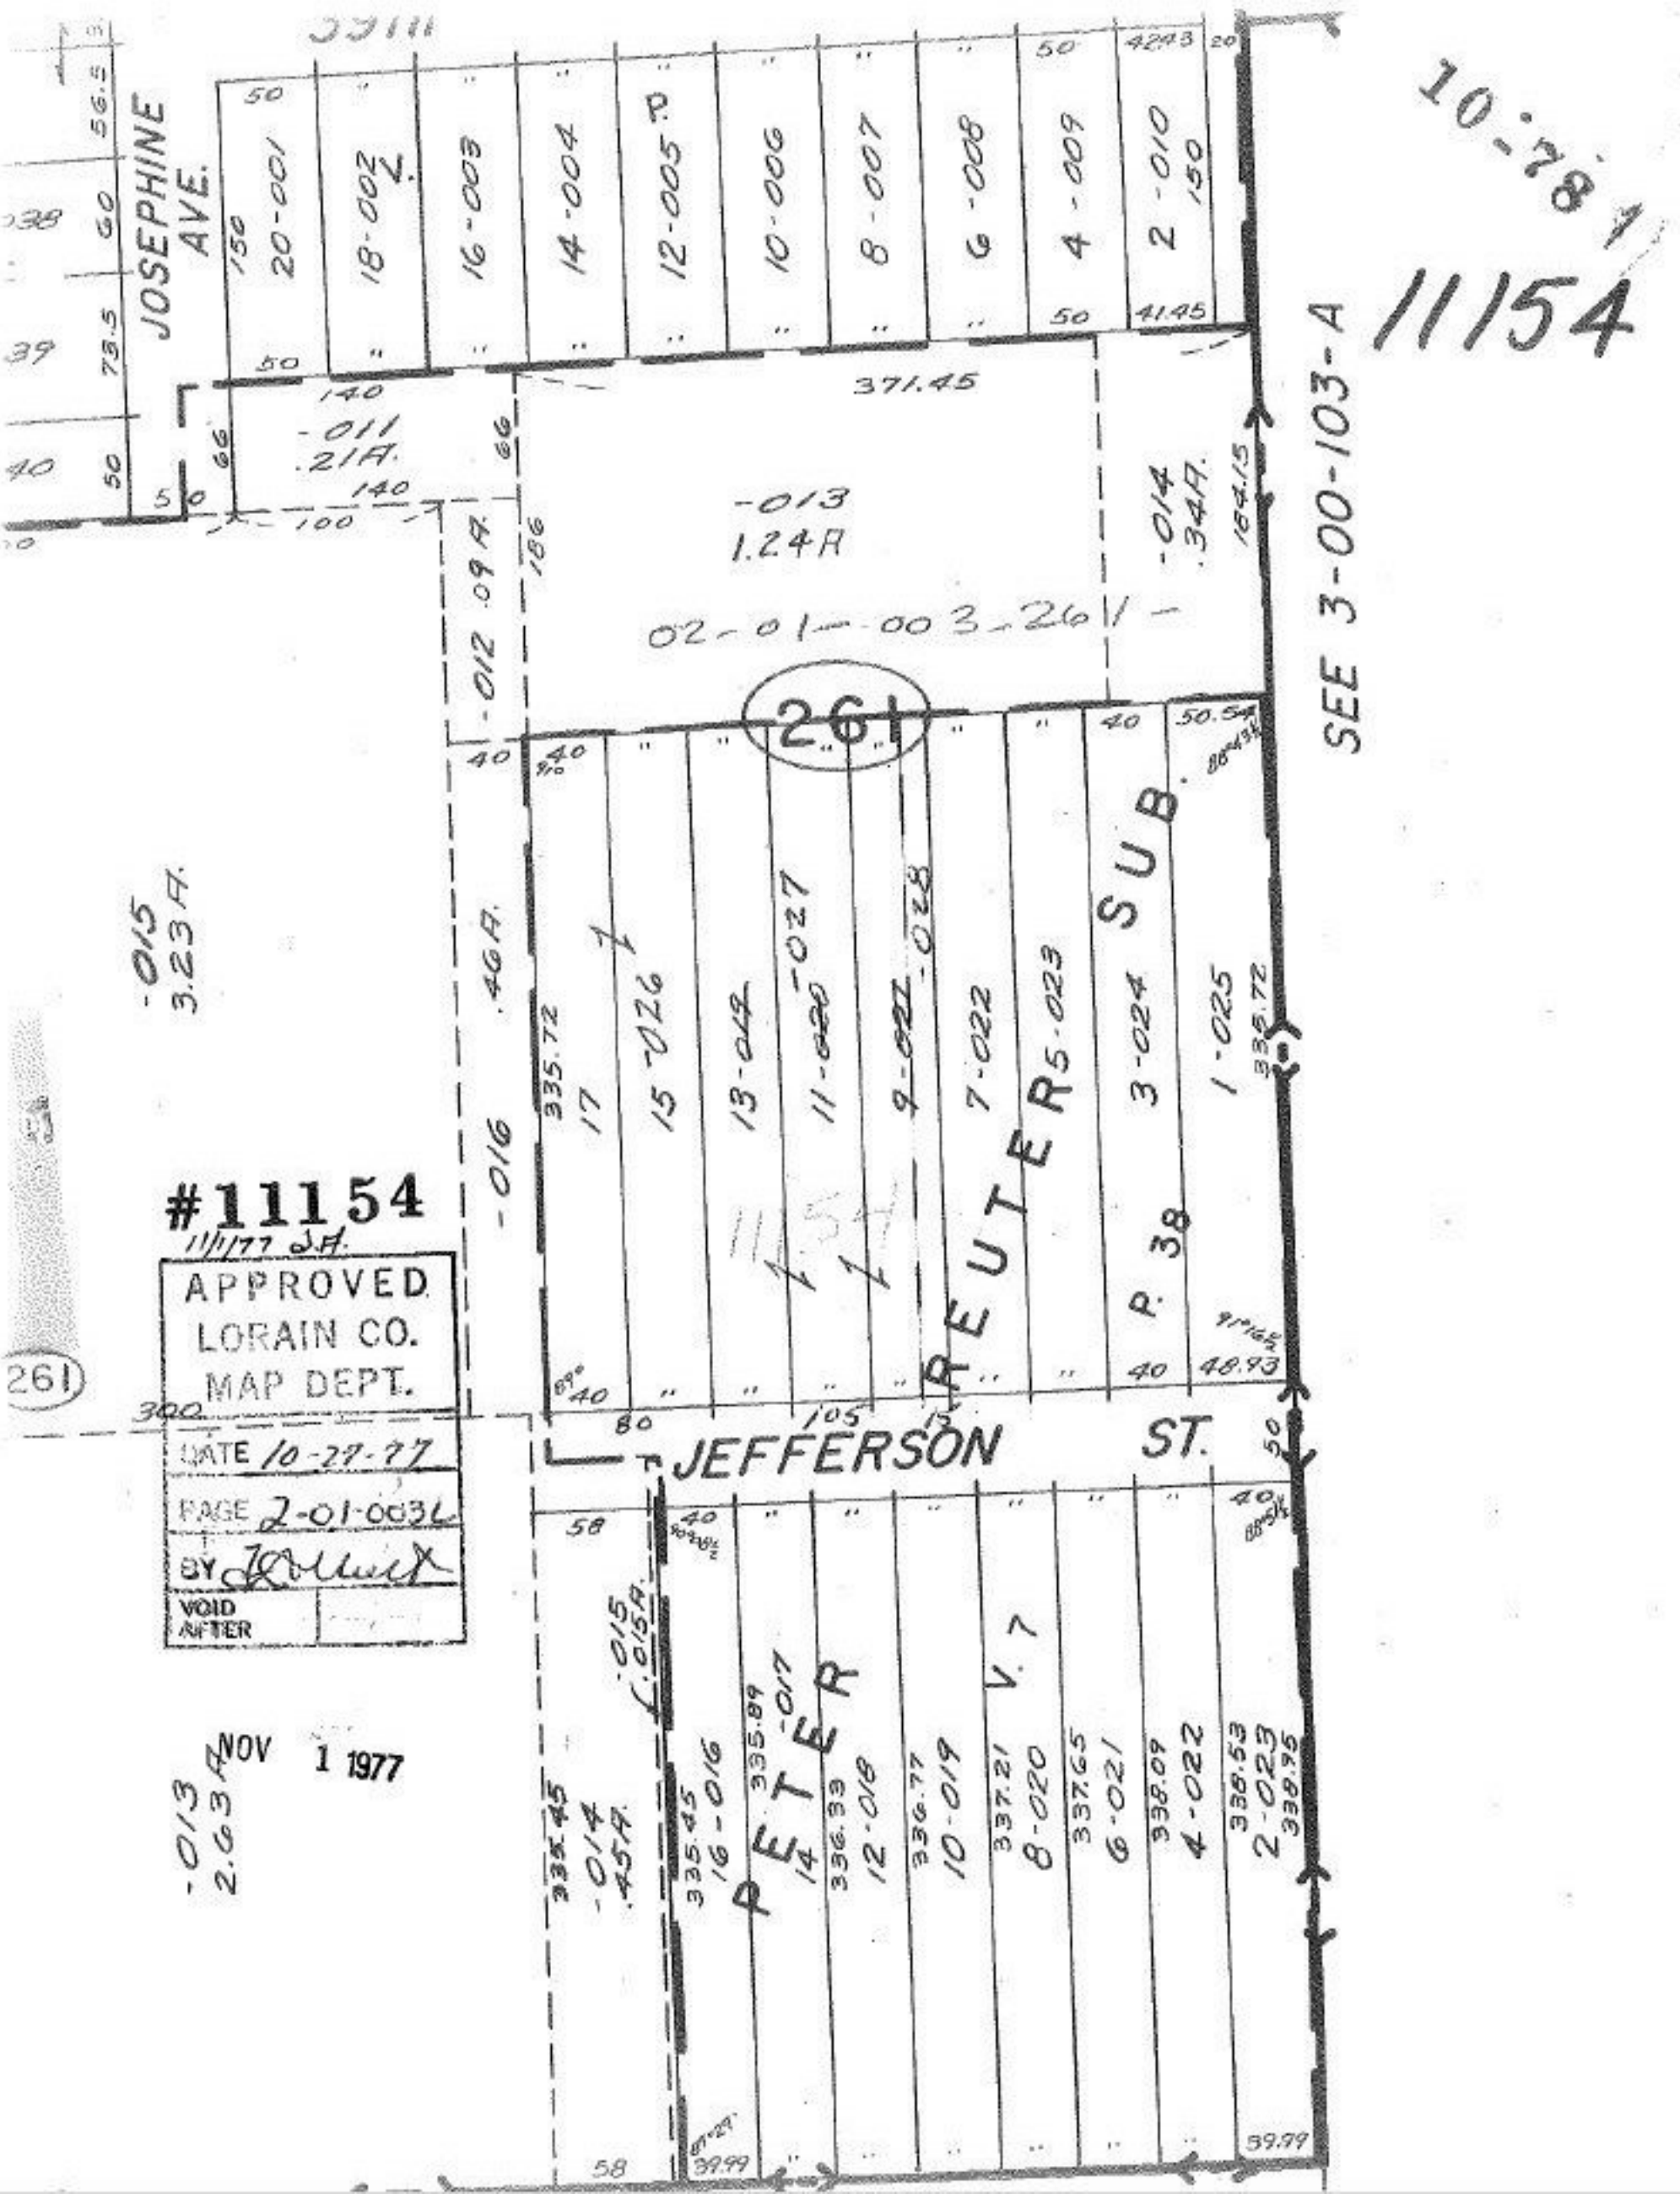

#11154
11/1/77 J.A.

APPROVED
LORAIN CO.
MAP DEPT.

DATE 10-27-77
PAGE 2-01-003L
BY [signature]
VOID AFTER