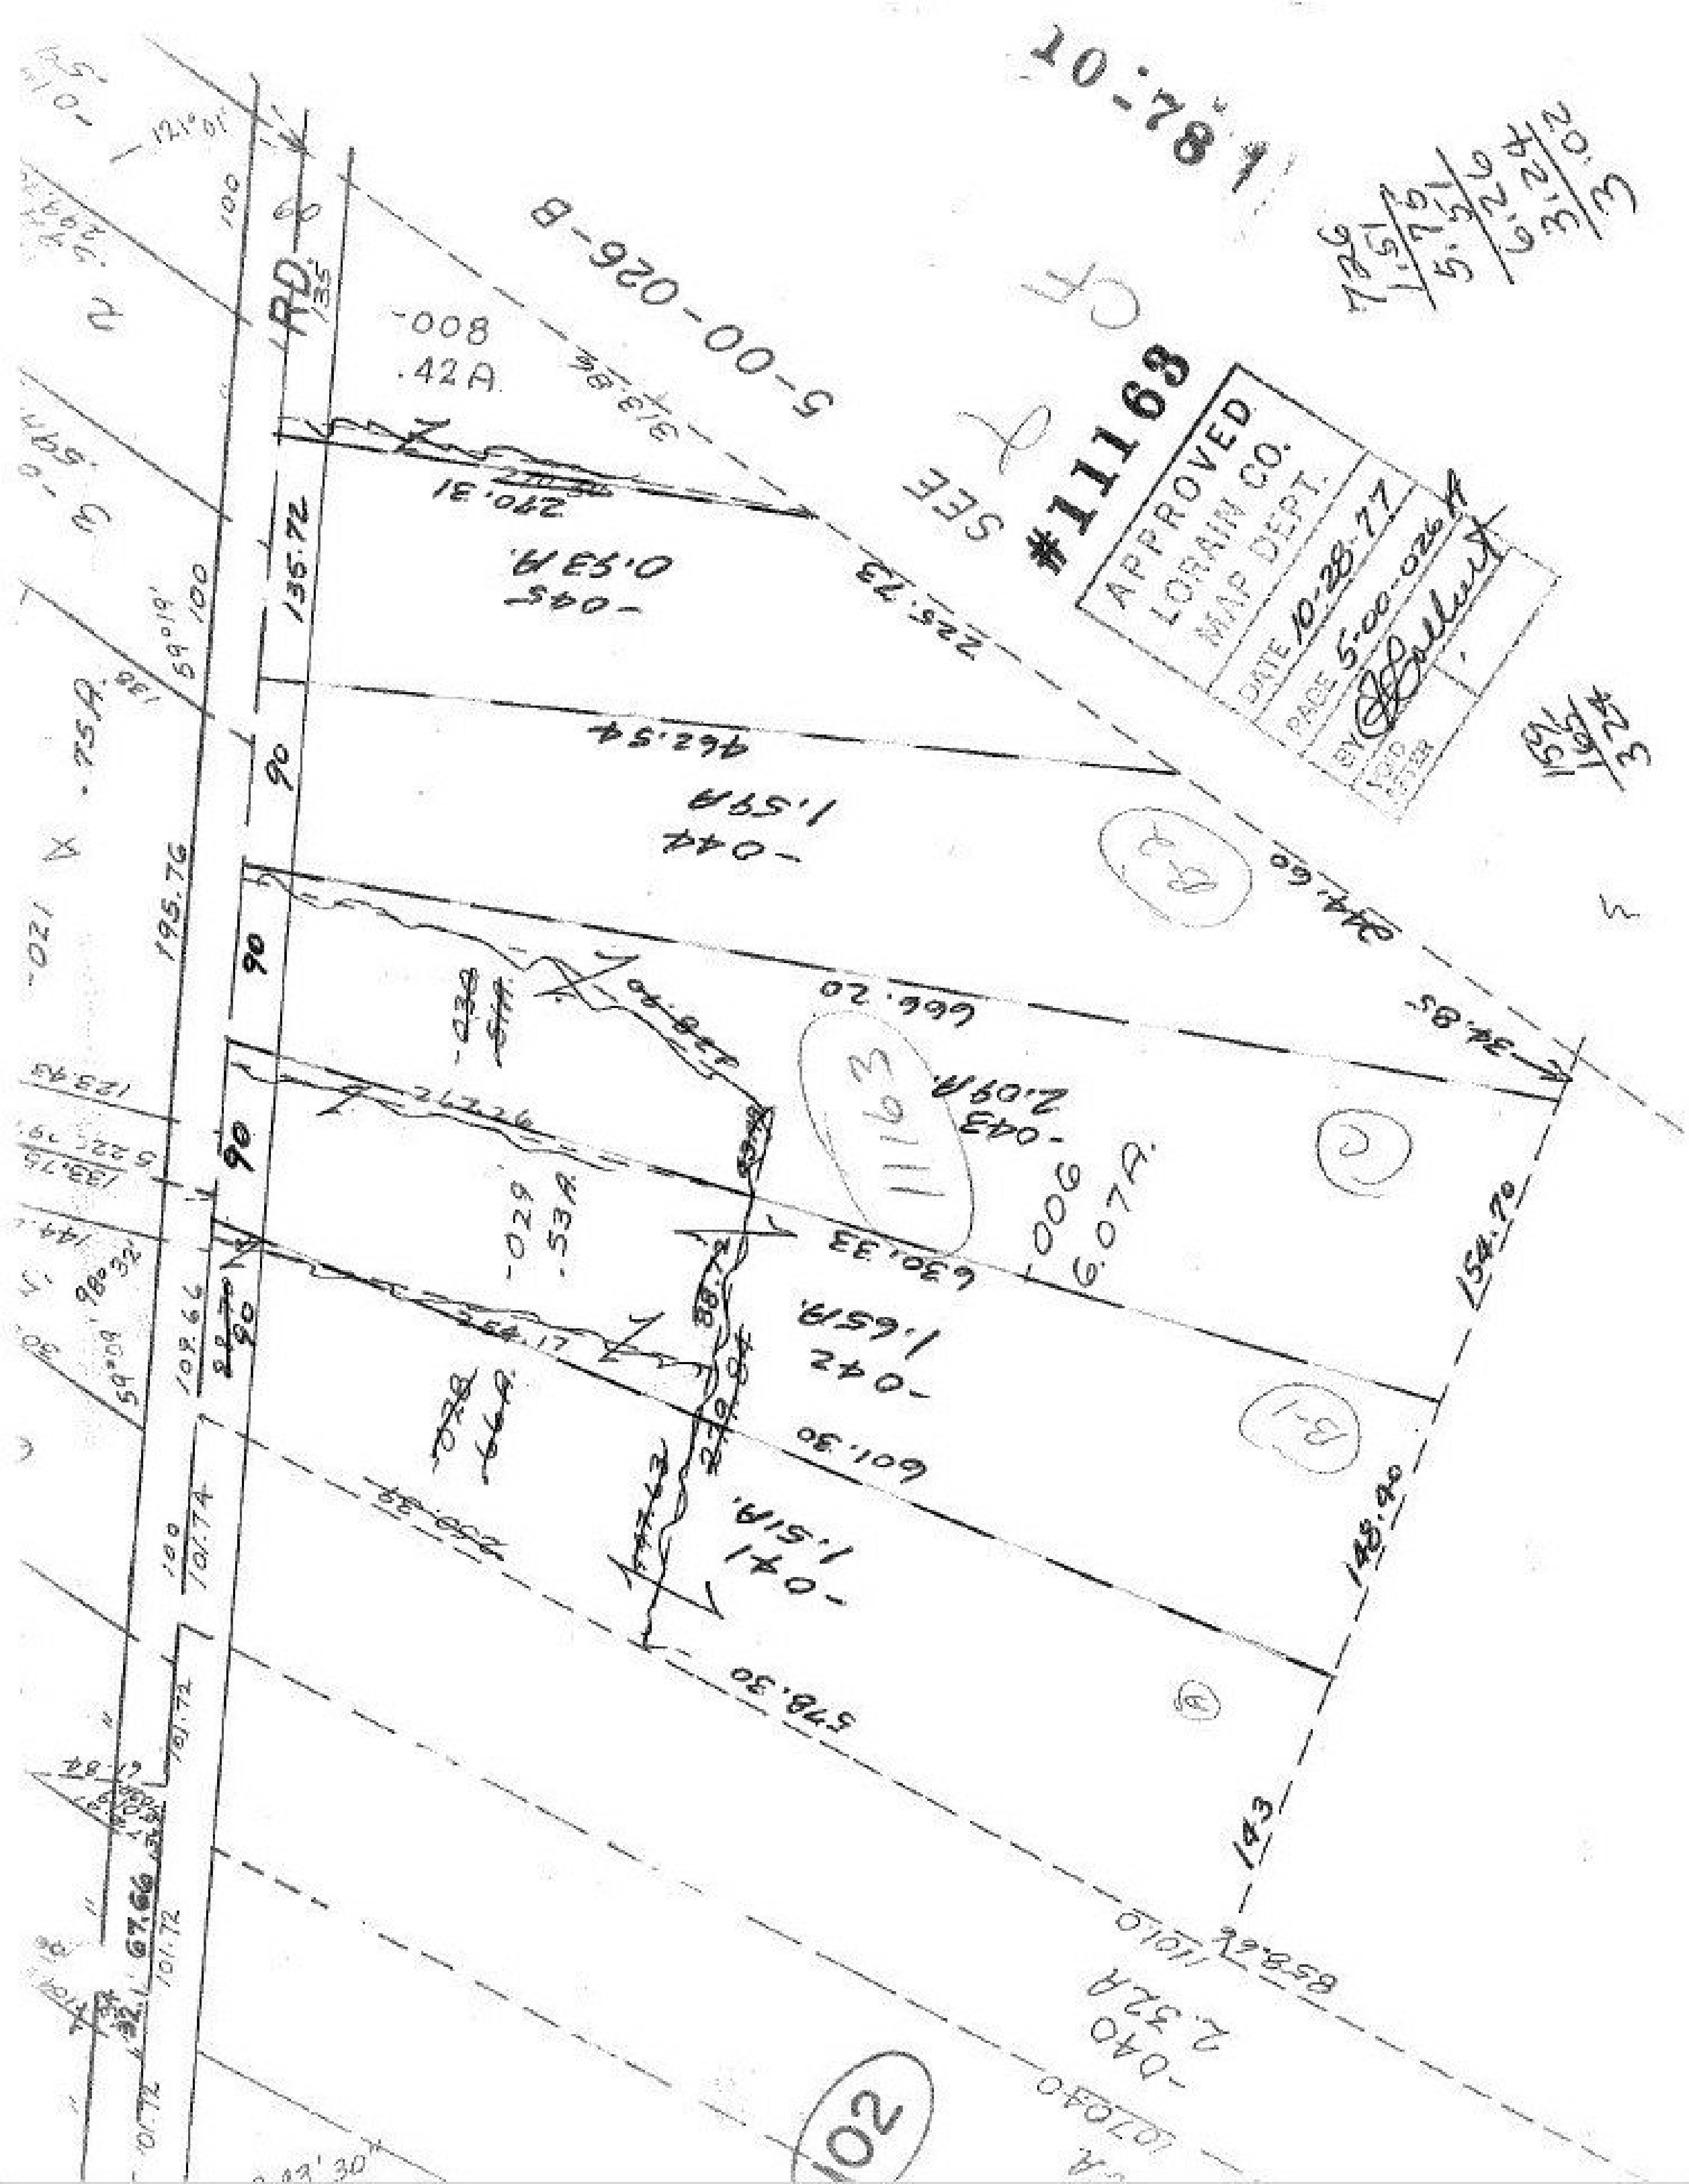

10-78
#11163
APPROVED
LORAIN CO.
MAP DEPT.
DATE 10-28-77
PAGE 5-00-026A
BY
SEE
5-00-026-B
RD.
-008
.42A
-045-
0.53A.
-044-
1.59A
-043-
2.09A
-006
6.07A.
-029
.53A
-042-
1.65A.
-041-
1.51A.
-040
2.32A
270.31
225.73
462.54
244.60
34.85
666.20
630.33
601.30
578.30
154.70
148.90
143
858.96
1010.10
135.72
195.76
109.66
101.74
101.72
67.66
90
100
59°19'
98°32'
59°09'
121°01'
B-1
B-2
102