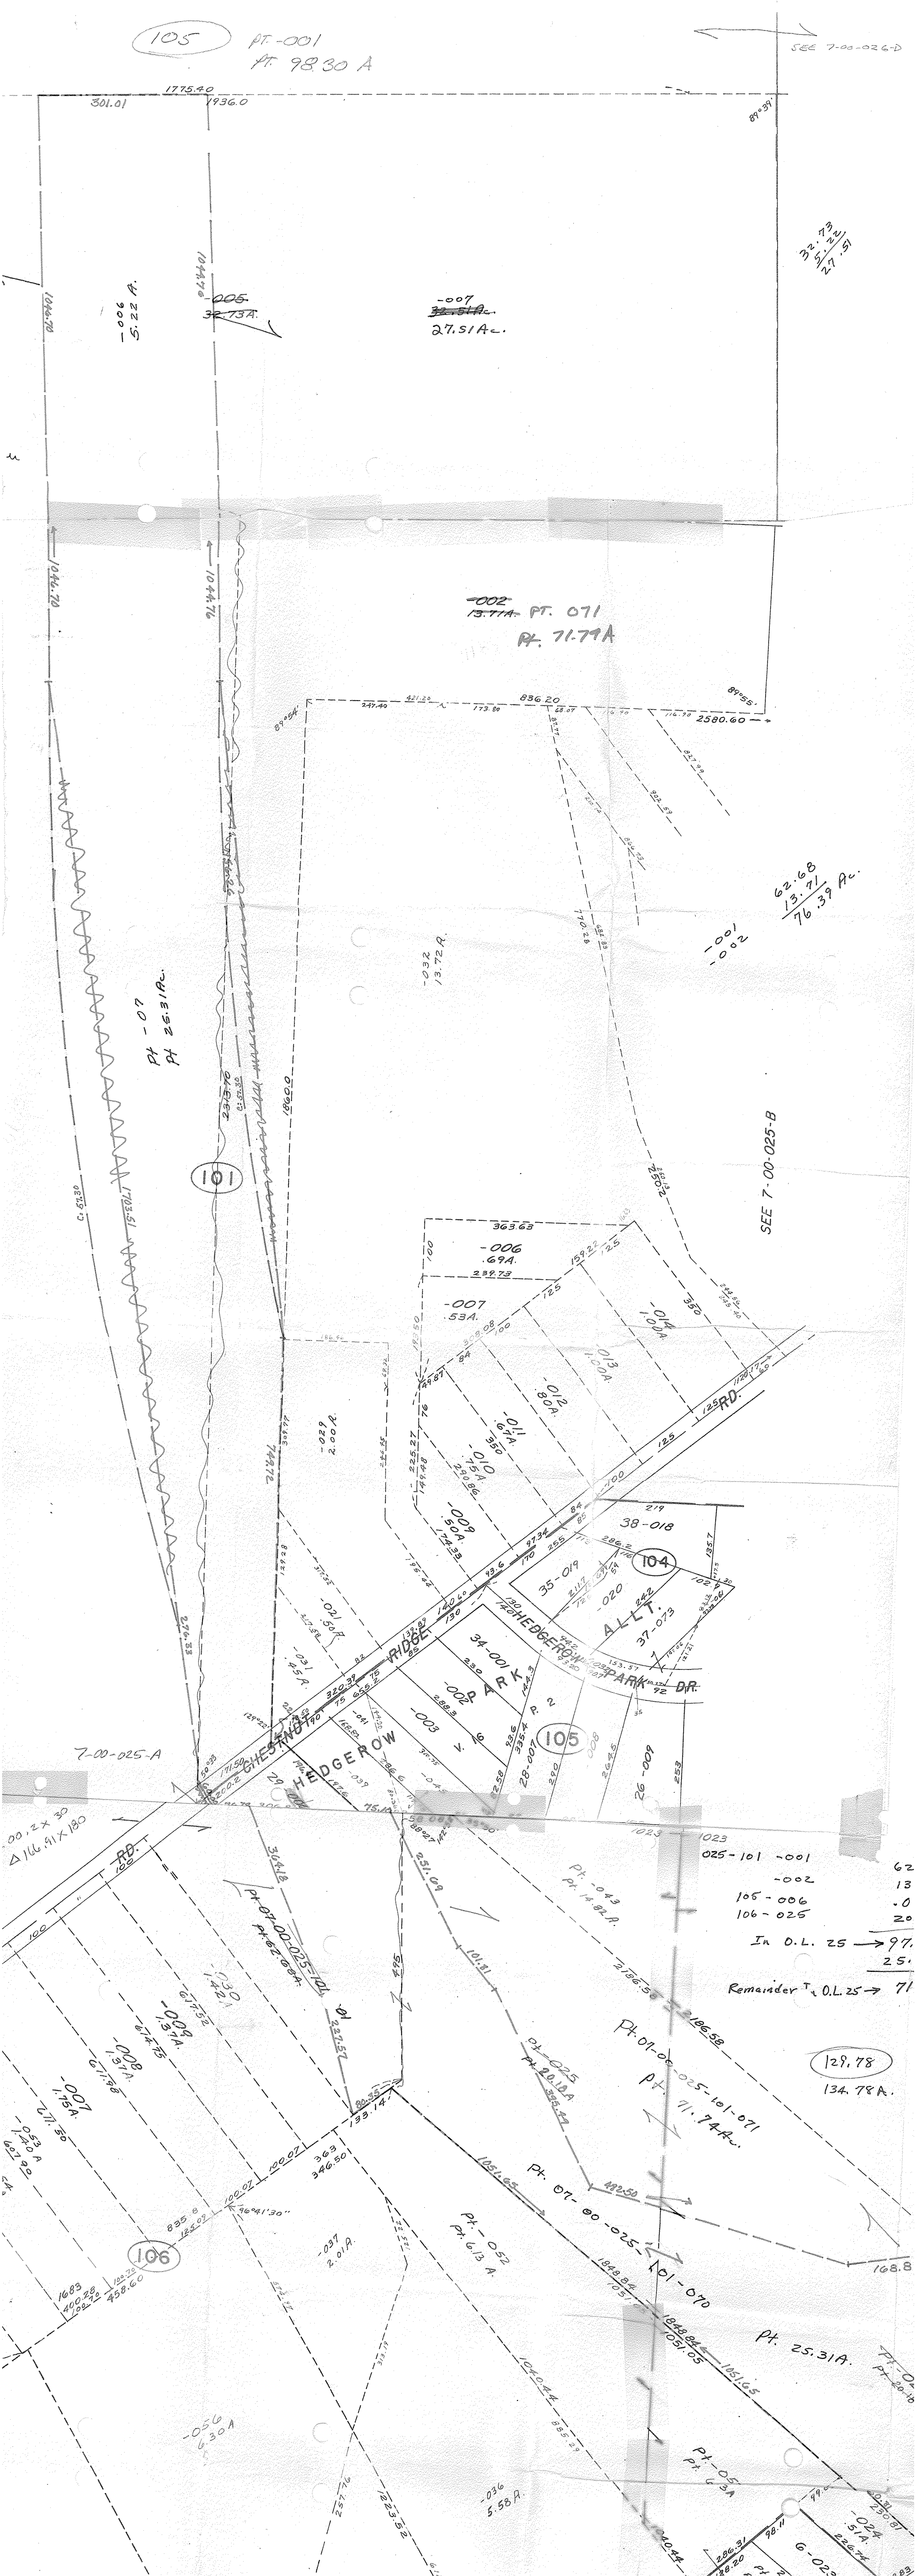
105
Pt-001
Pt. 98.30 A
SEE 7-00-026-D
-006
5.22 A.
-005
32.73A.
-007
27.51Ac.
-002
13.71A. Pt. 071
Pt. 71.79A
Pt. -07
Pt 25.31Ac.
101
-032
13.72 A.
-001
-002
62.68
13.71
76.39 Ac.
SEE 7-00-025-B
-006
.69A.
-007
.53A.
-014
1.00A
-013
1.00A
-012
.80A.
-011
.69A.
-010
.75A.
-009
.50A.
-029
2.00A.
38-018
35-019
-020
37-073
104
ALLT.
PARK DR.
HEDGEROW
RIDGE
34-001
-008
-003
PARK
105
26-009
7-00-025-A
CHESTNUT
HEDGEROW
RD.
025-101 -001
-002
105-006
106-025
In O.L. 25 → 97.
25.
Remainder T. O.L. 25 → 71
Pt. 07-00-025-101-071
Pt. 71.74Ac.
129.78
134.78A.
Pt. 07-00-025-101-070
Pt. 25.31A.
Pt. -043
Pt. 14.82 A.
Pt. -025
Pt. 20.18A
Pt. -052
Pt. 6.13 A.
-030
1.42A
-056
6.30A
106
-037
2.01A.
-024
.51A.
G-023