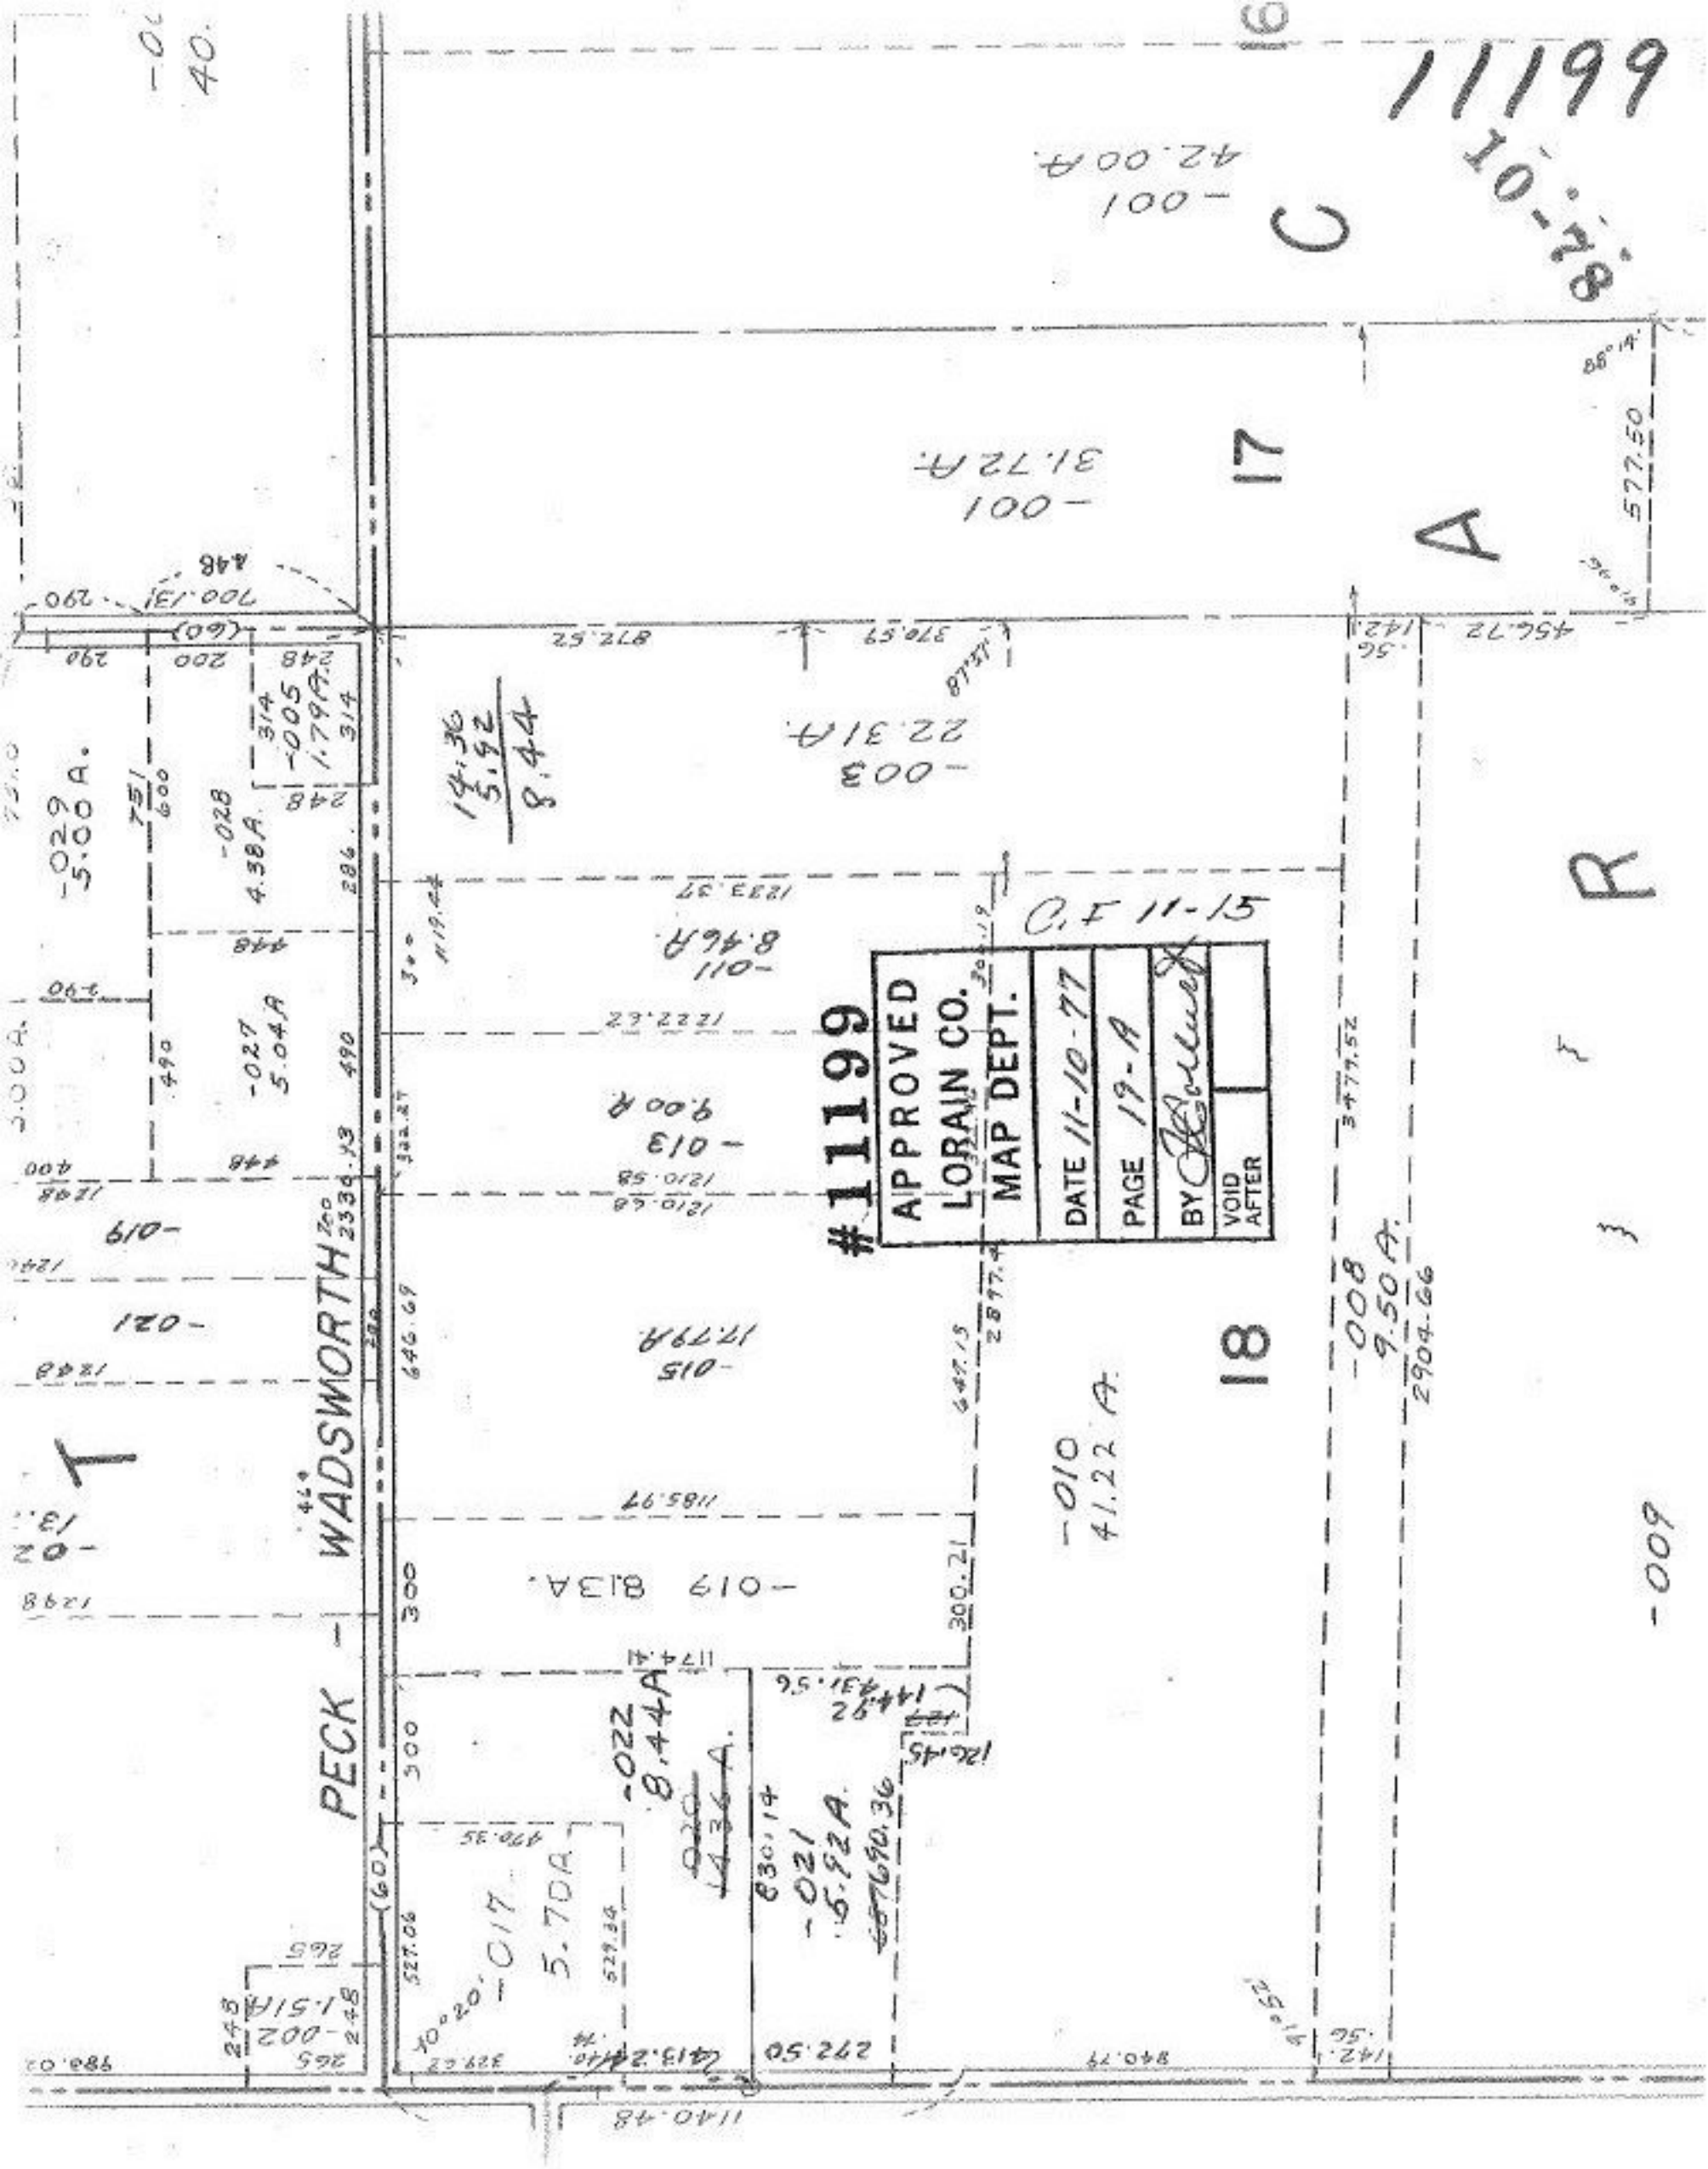

11199
#11199
APPROVED
LORAIN CO.
MAP DEPT.
DATE 11-10-77
PAGE 19-A
BY
VOID AFTER
C.F 11-15
PECK - WADSWORTH
-001 42.00 A.
-001 31.72 A.
-003 22.31 A.
-011 8.46 A.
-013 9.00 A.
-015 17.79 A.
-019 8.13 A.
-010 41.22 A.
-008 9.50 A.
-009
-022 8.44 A.
-021 5.92 A.
-017 5.70 A.
-002 1.51 A.
-029 5.00 A.
-028 4.38 A.
-027 5.04 A.
-005 1.79 A.
-019
-021
14.36
5.92
8.44