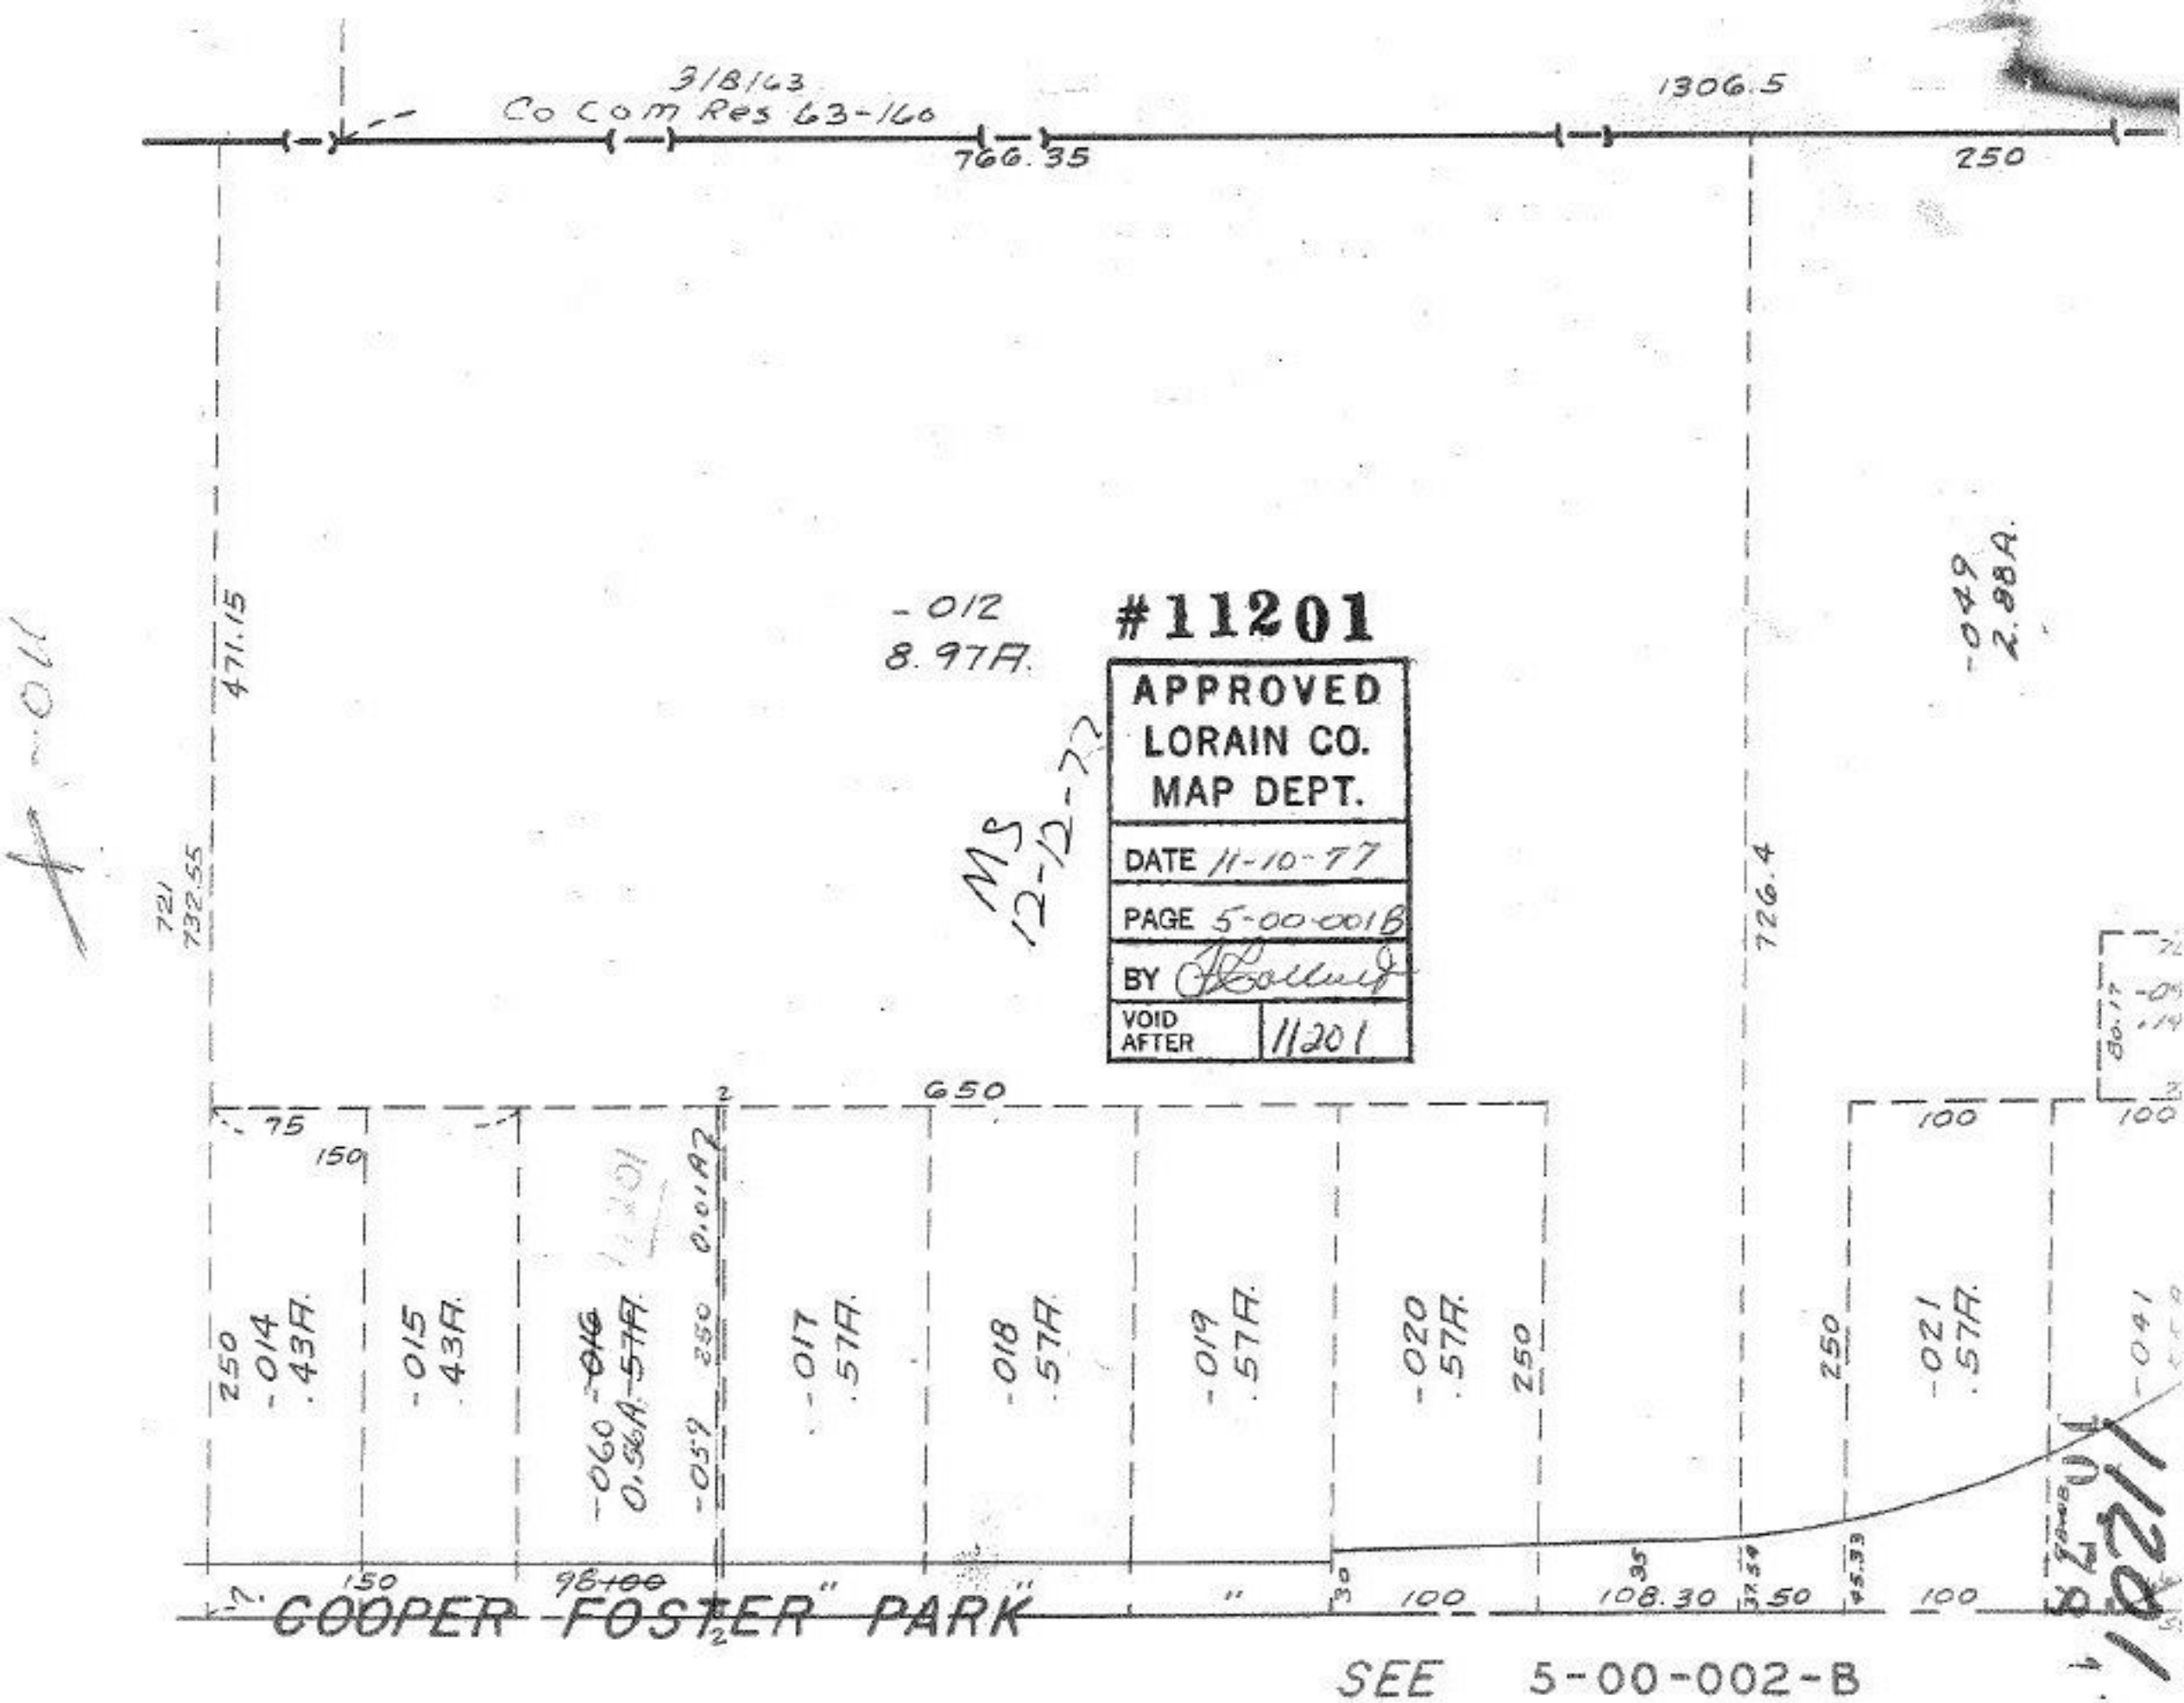

3/8/63
Co Com Res 63-160
766.35
1306.5
250
471.15
721
732.55
-012
8.97A.
#11201
APPROVED
LORAIN CO.
MAP DEPT.
DATE 11-10-77
PAGE 5-00-001B
BY
VOID AFTER 11201
MS 12-12-77
726.4
-049
2.88A.
650
75
150
250
-014
.43A.
-015
.43A.
-060
0.56A.
-059
0.01A
-017
.57A.
-018
.57A.
-019
.57A.
-020
.57A.
-021
.57A.
-041
100
108.30
50
COOPER FOSTER PARK
SEE 5-00-002-B