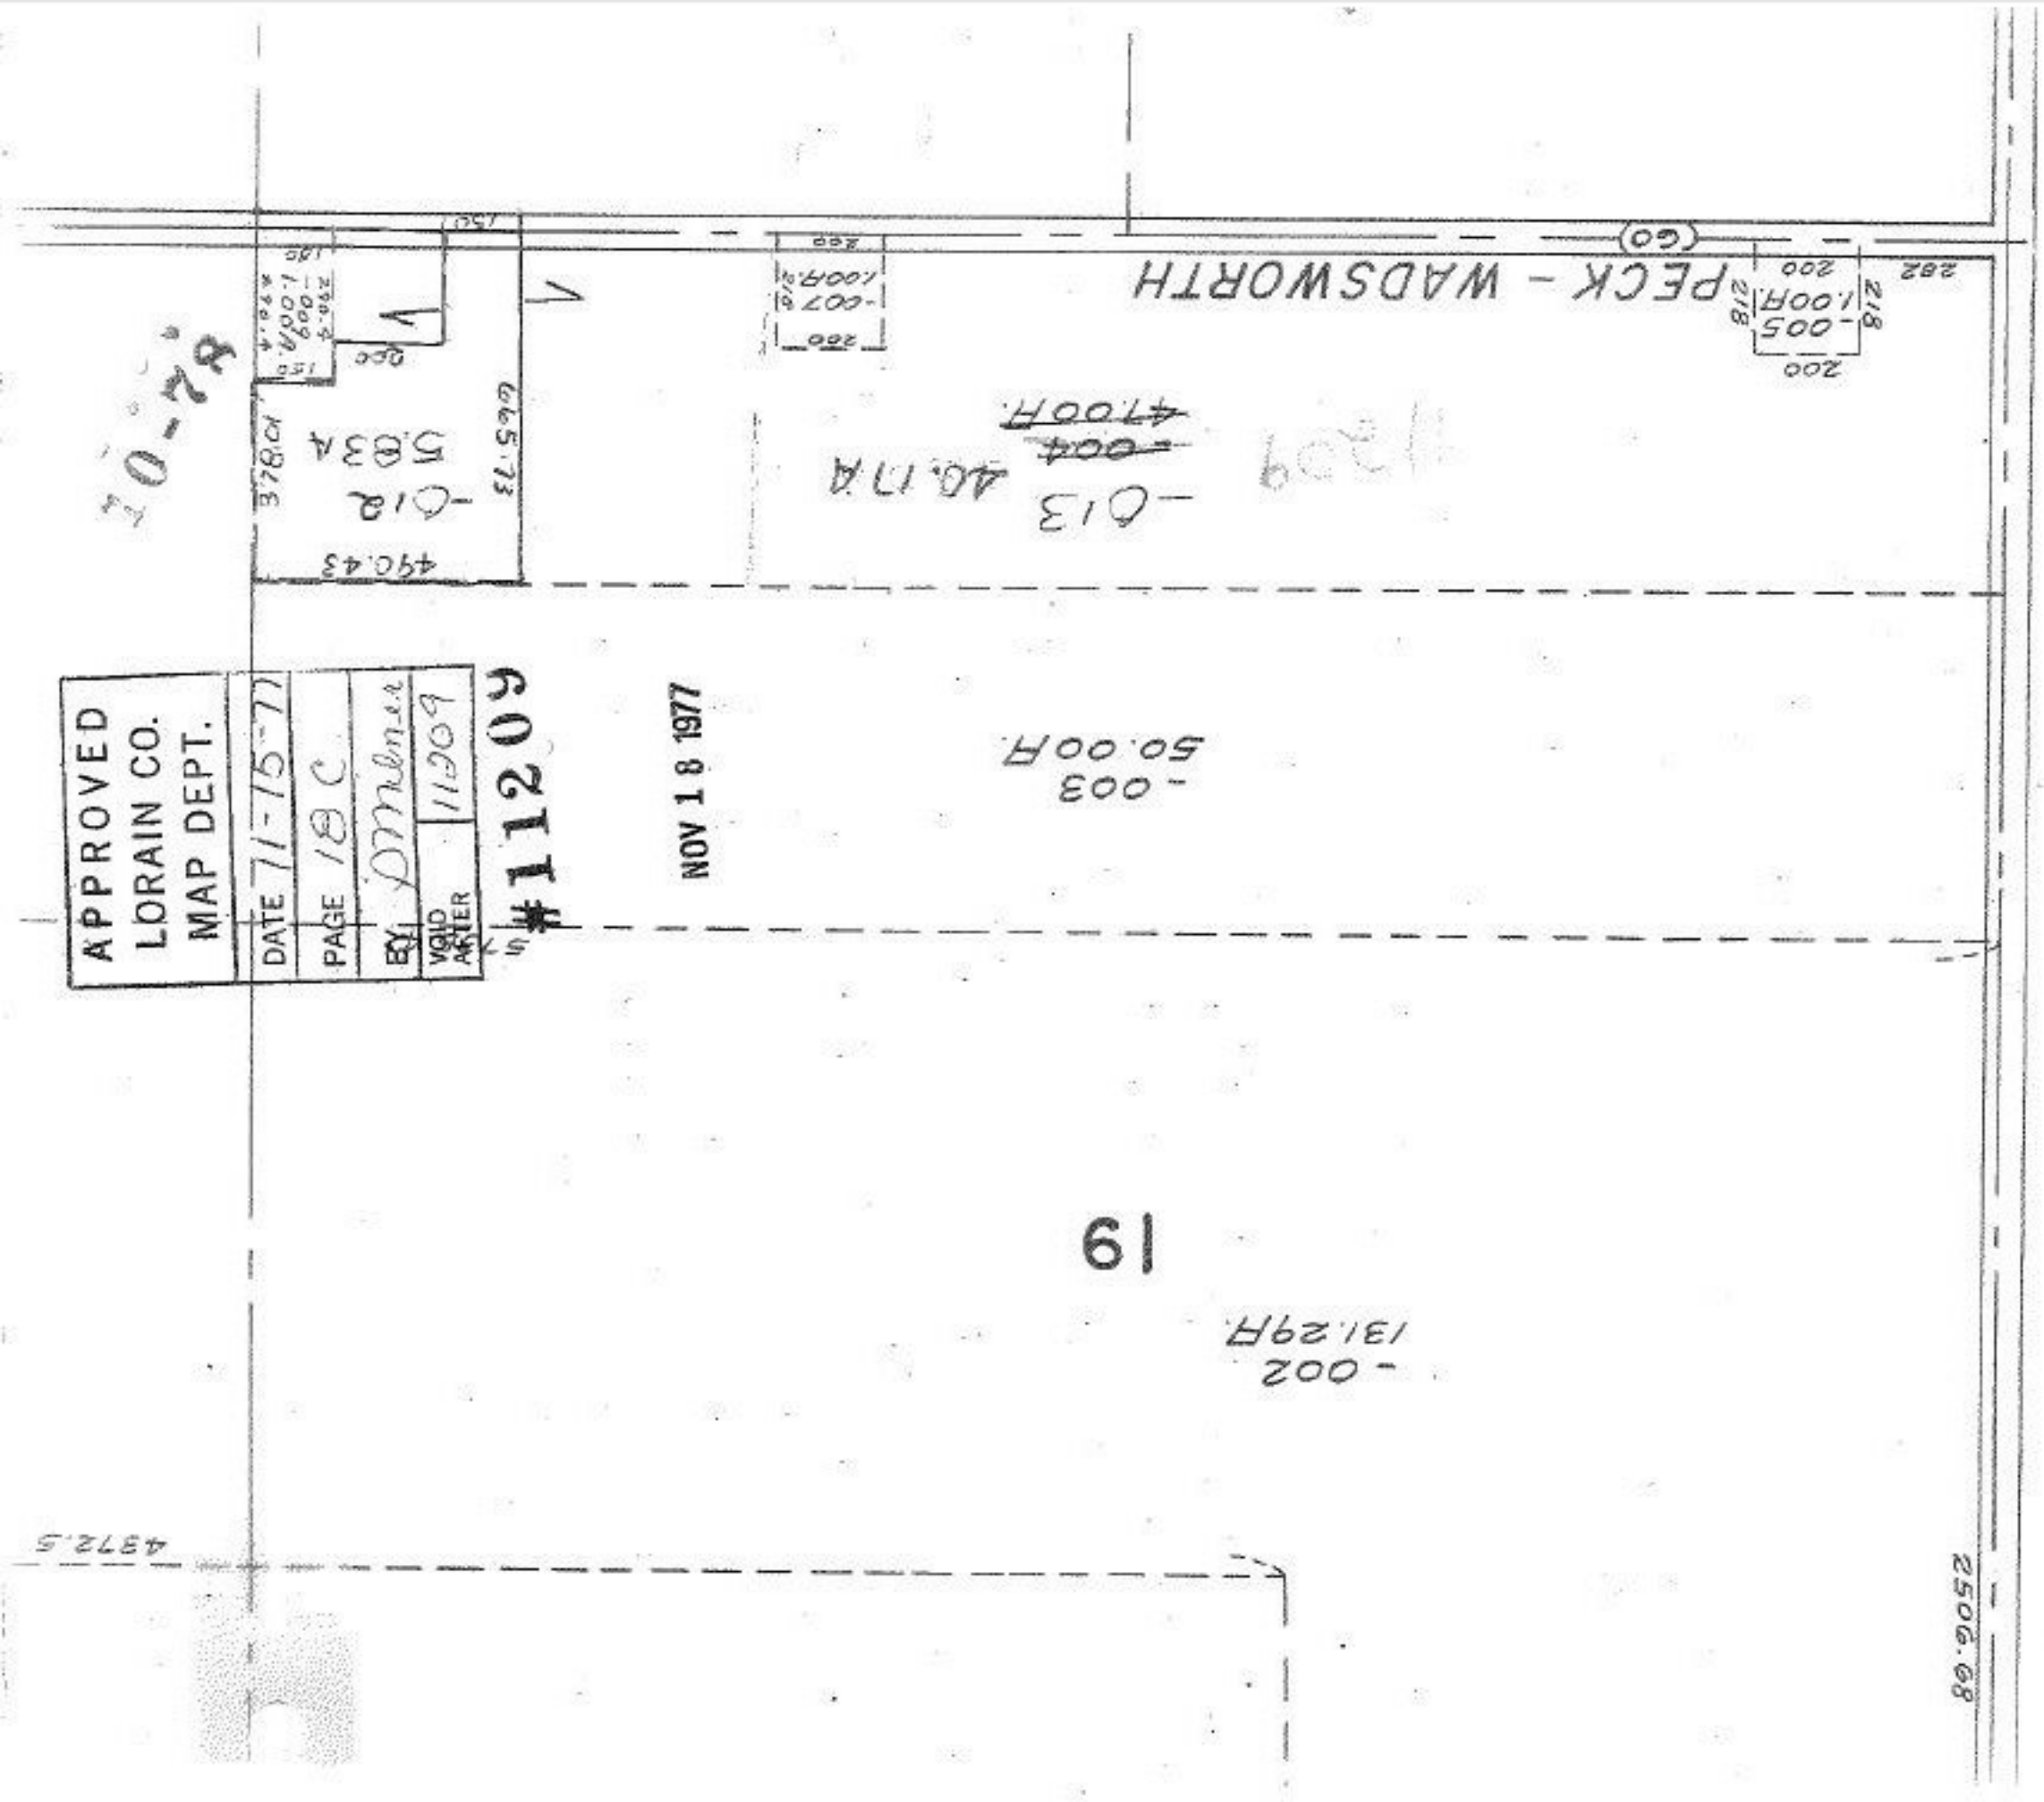

APPROVED
LORAIN CO.
MAP DEPT.
DATE 11-15-77
PAGE 18C
BY DMilner
VOID AFTER 11209

#11209

NOV 18 1977

10-78

19