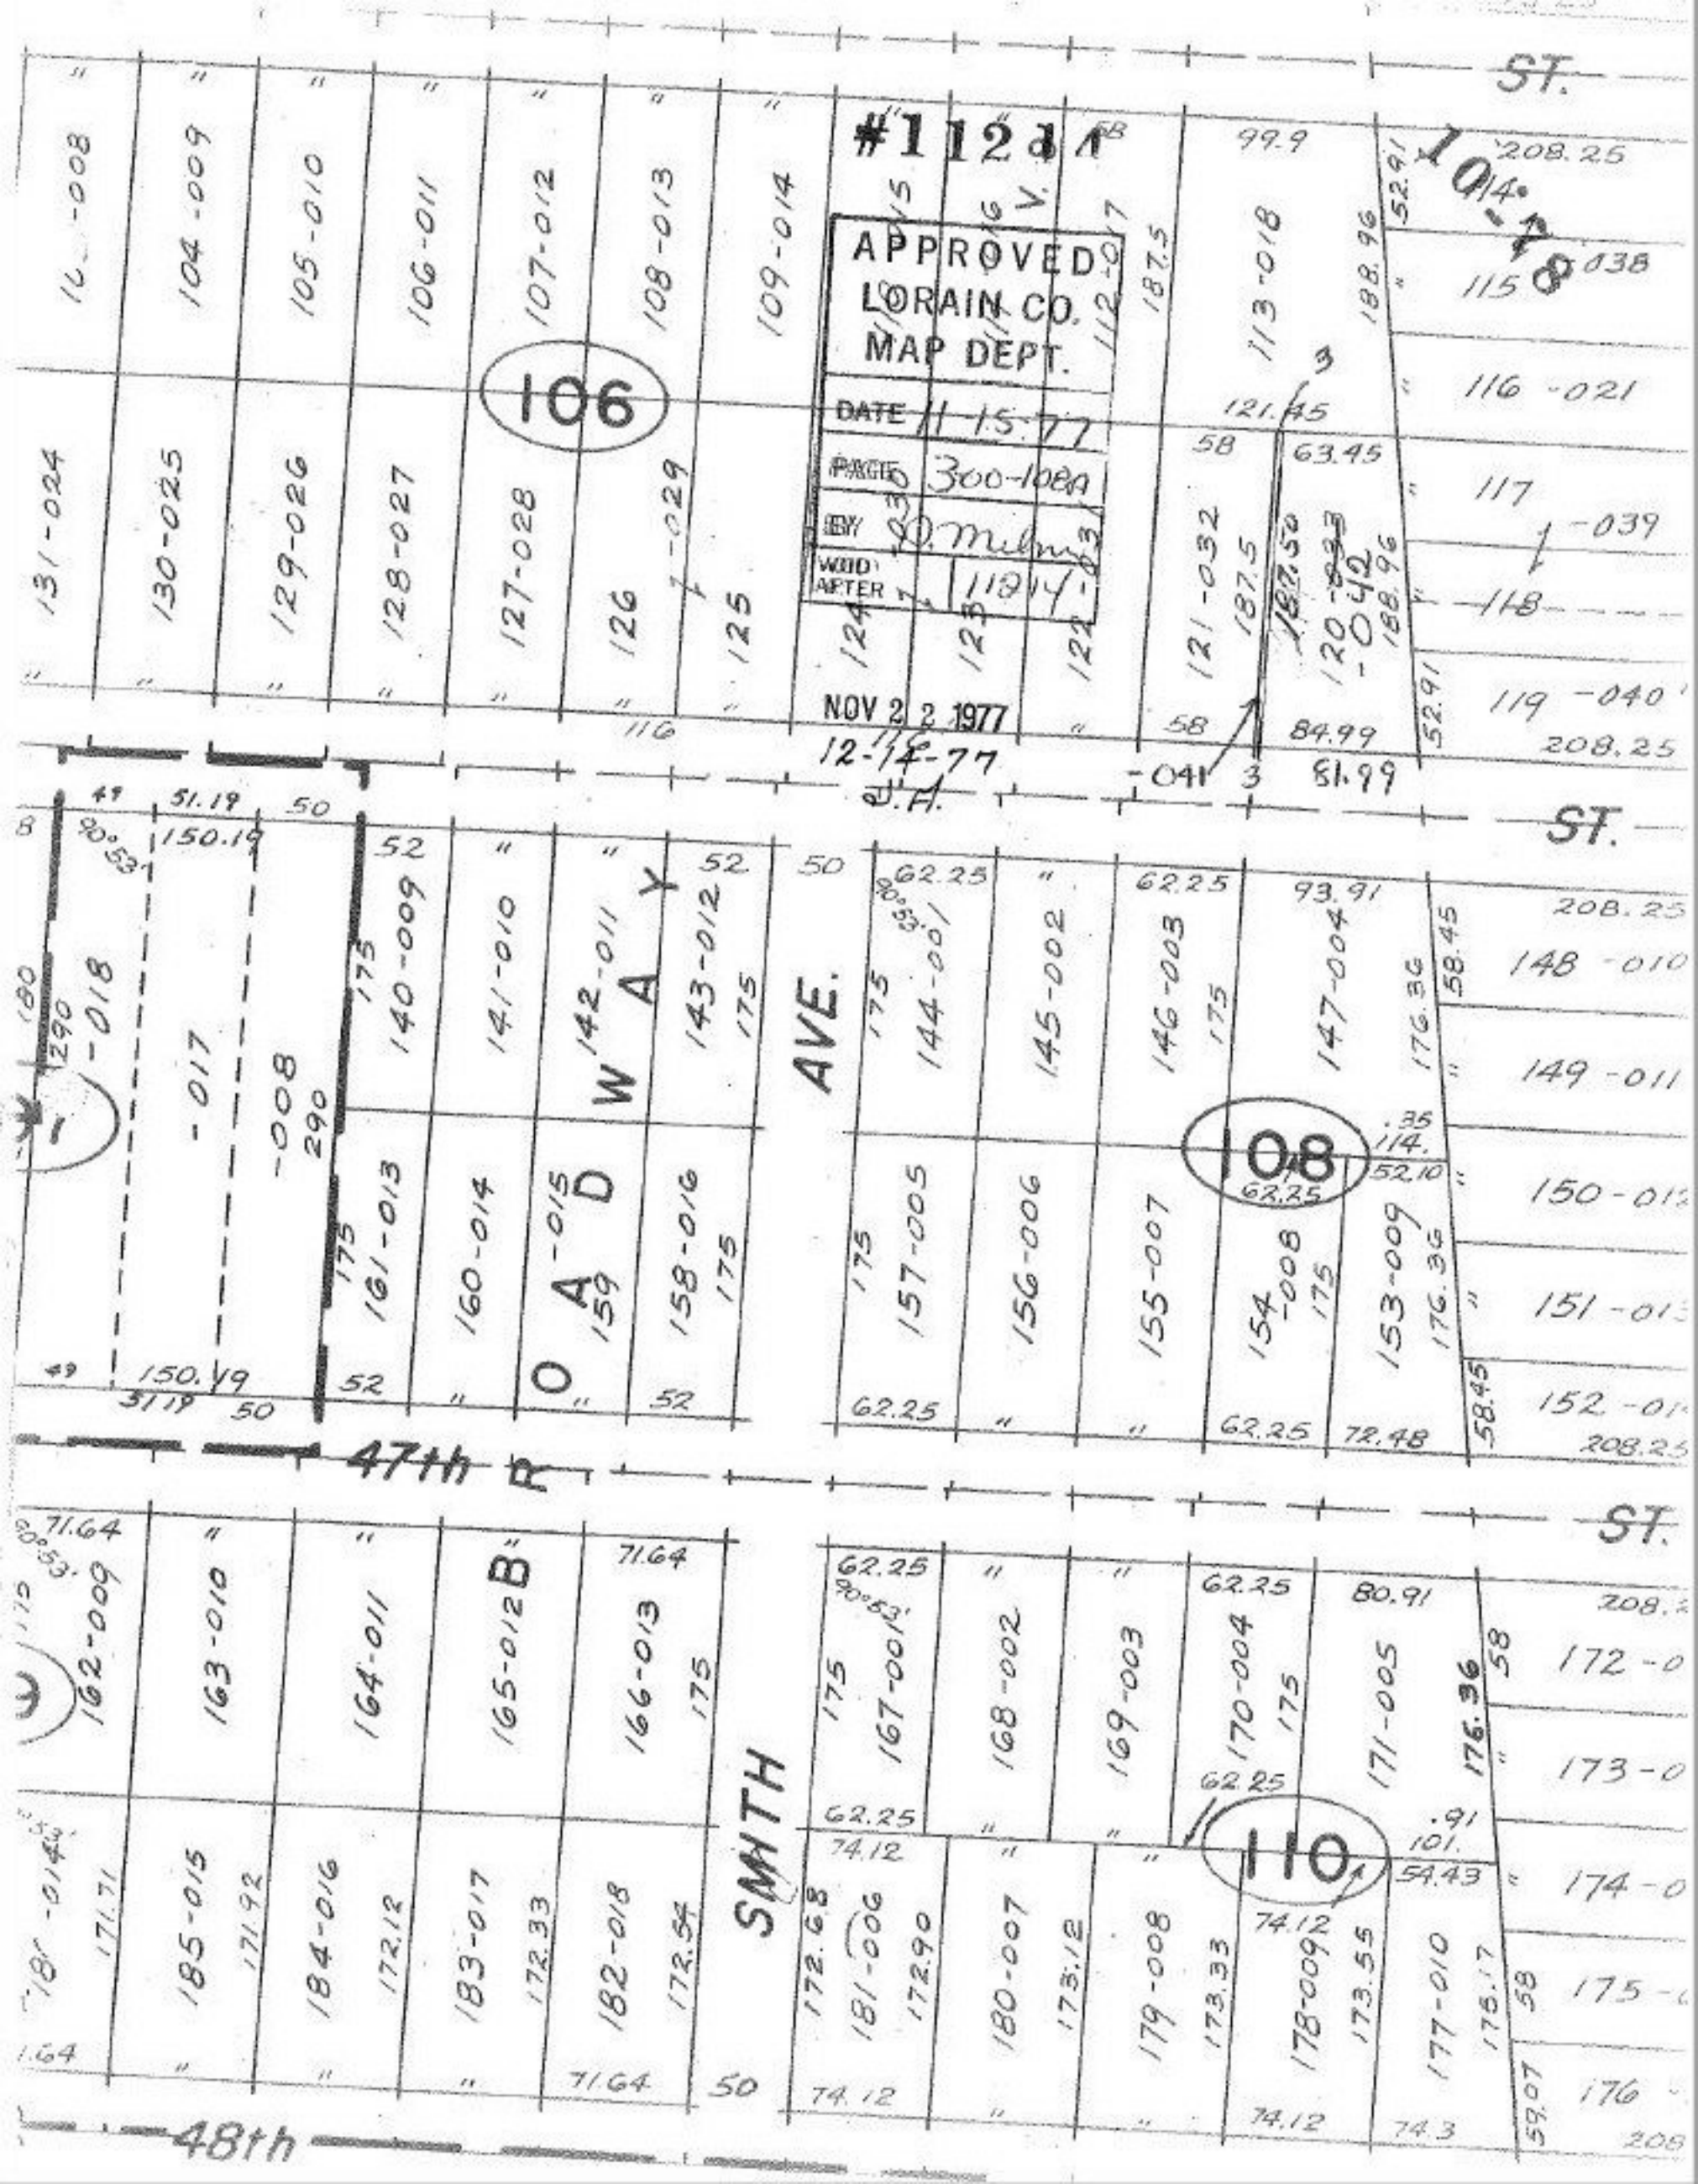

#112d
APPROVED
LORAIN CO.
MAP DEPT.
DATE 11-15-77
PAGE 300-108A
BY D. Milne
VOID AFTER 11-14
NOV 22 1977
12-14-77
J.A.
106
108
110
ST.
47th
48th
SMITH
ROADWAY
AVE.