

-051  
81 A

-073  
-070  
13.92A.  
11.13A.

#11218

844  
-072  
2.59A.


200  
#11219  
-074  
0.60A.  
200

APPROVED  
LORAIN CO.  
MAP DEPT.  
DATE 11-17-77  
PAGE 11-00-077A  
BY *[Signature]*  
VOID  
AFTER

NOV 18 1977

12/10/77  
J.A

-075  
~~069~~  
15.98A. 15.28  
15.35A.  
14.68A

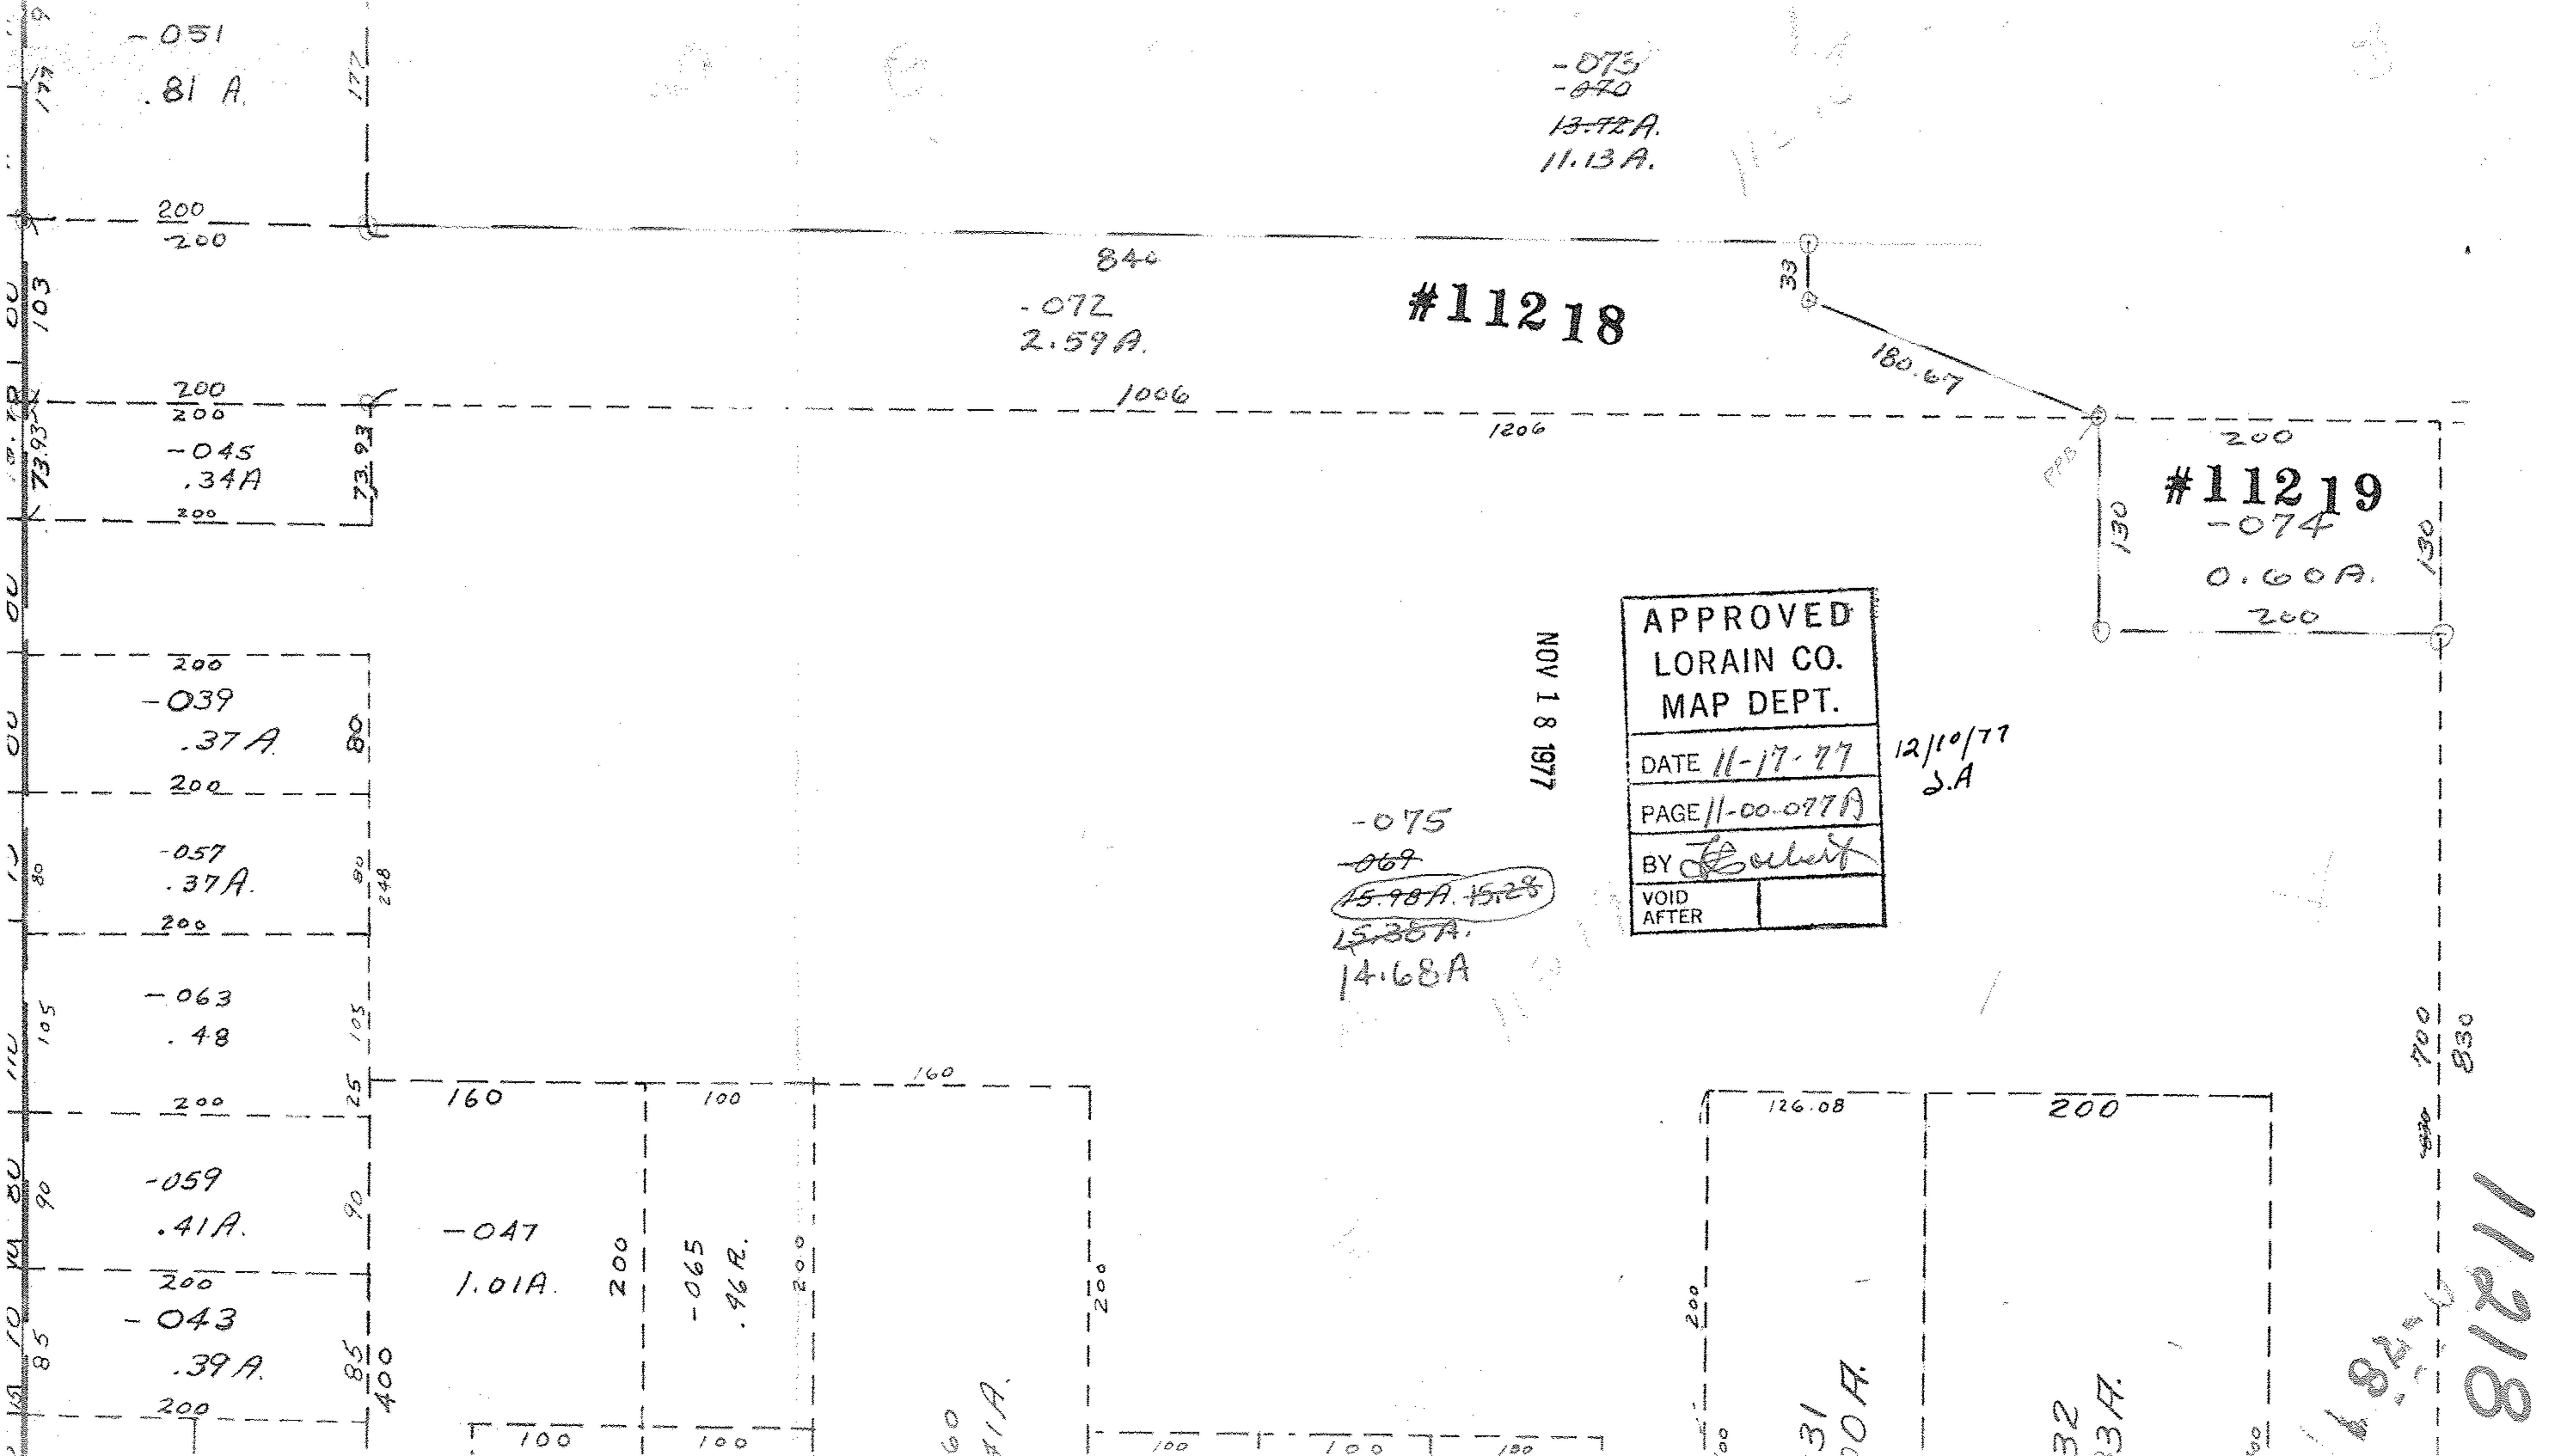

11218

1.82A  
1.48A  
700  
830

31  
20A.

32  
33A.

60  
11A.

-047  
1.01A.

-065  
.96A.

-059  
.41A.

-043  
.39A.

-063  
.48

-057  
.37A.

-039  
.37A.

-045  
.34A.

-051  
81 A