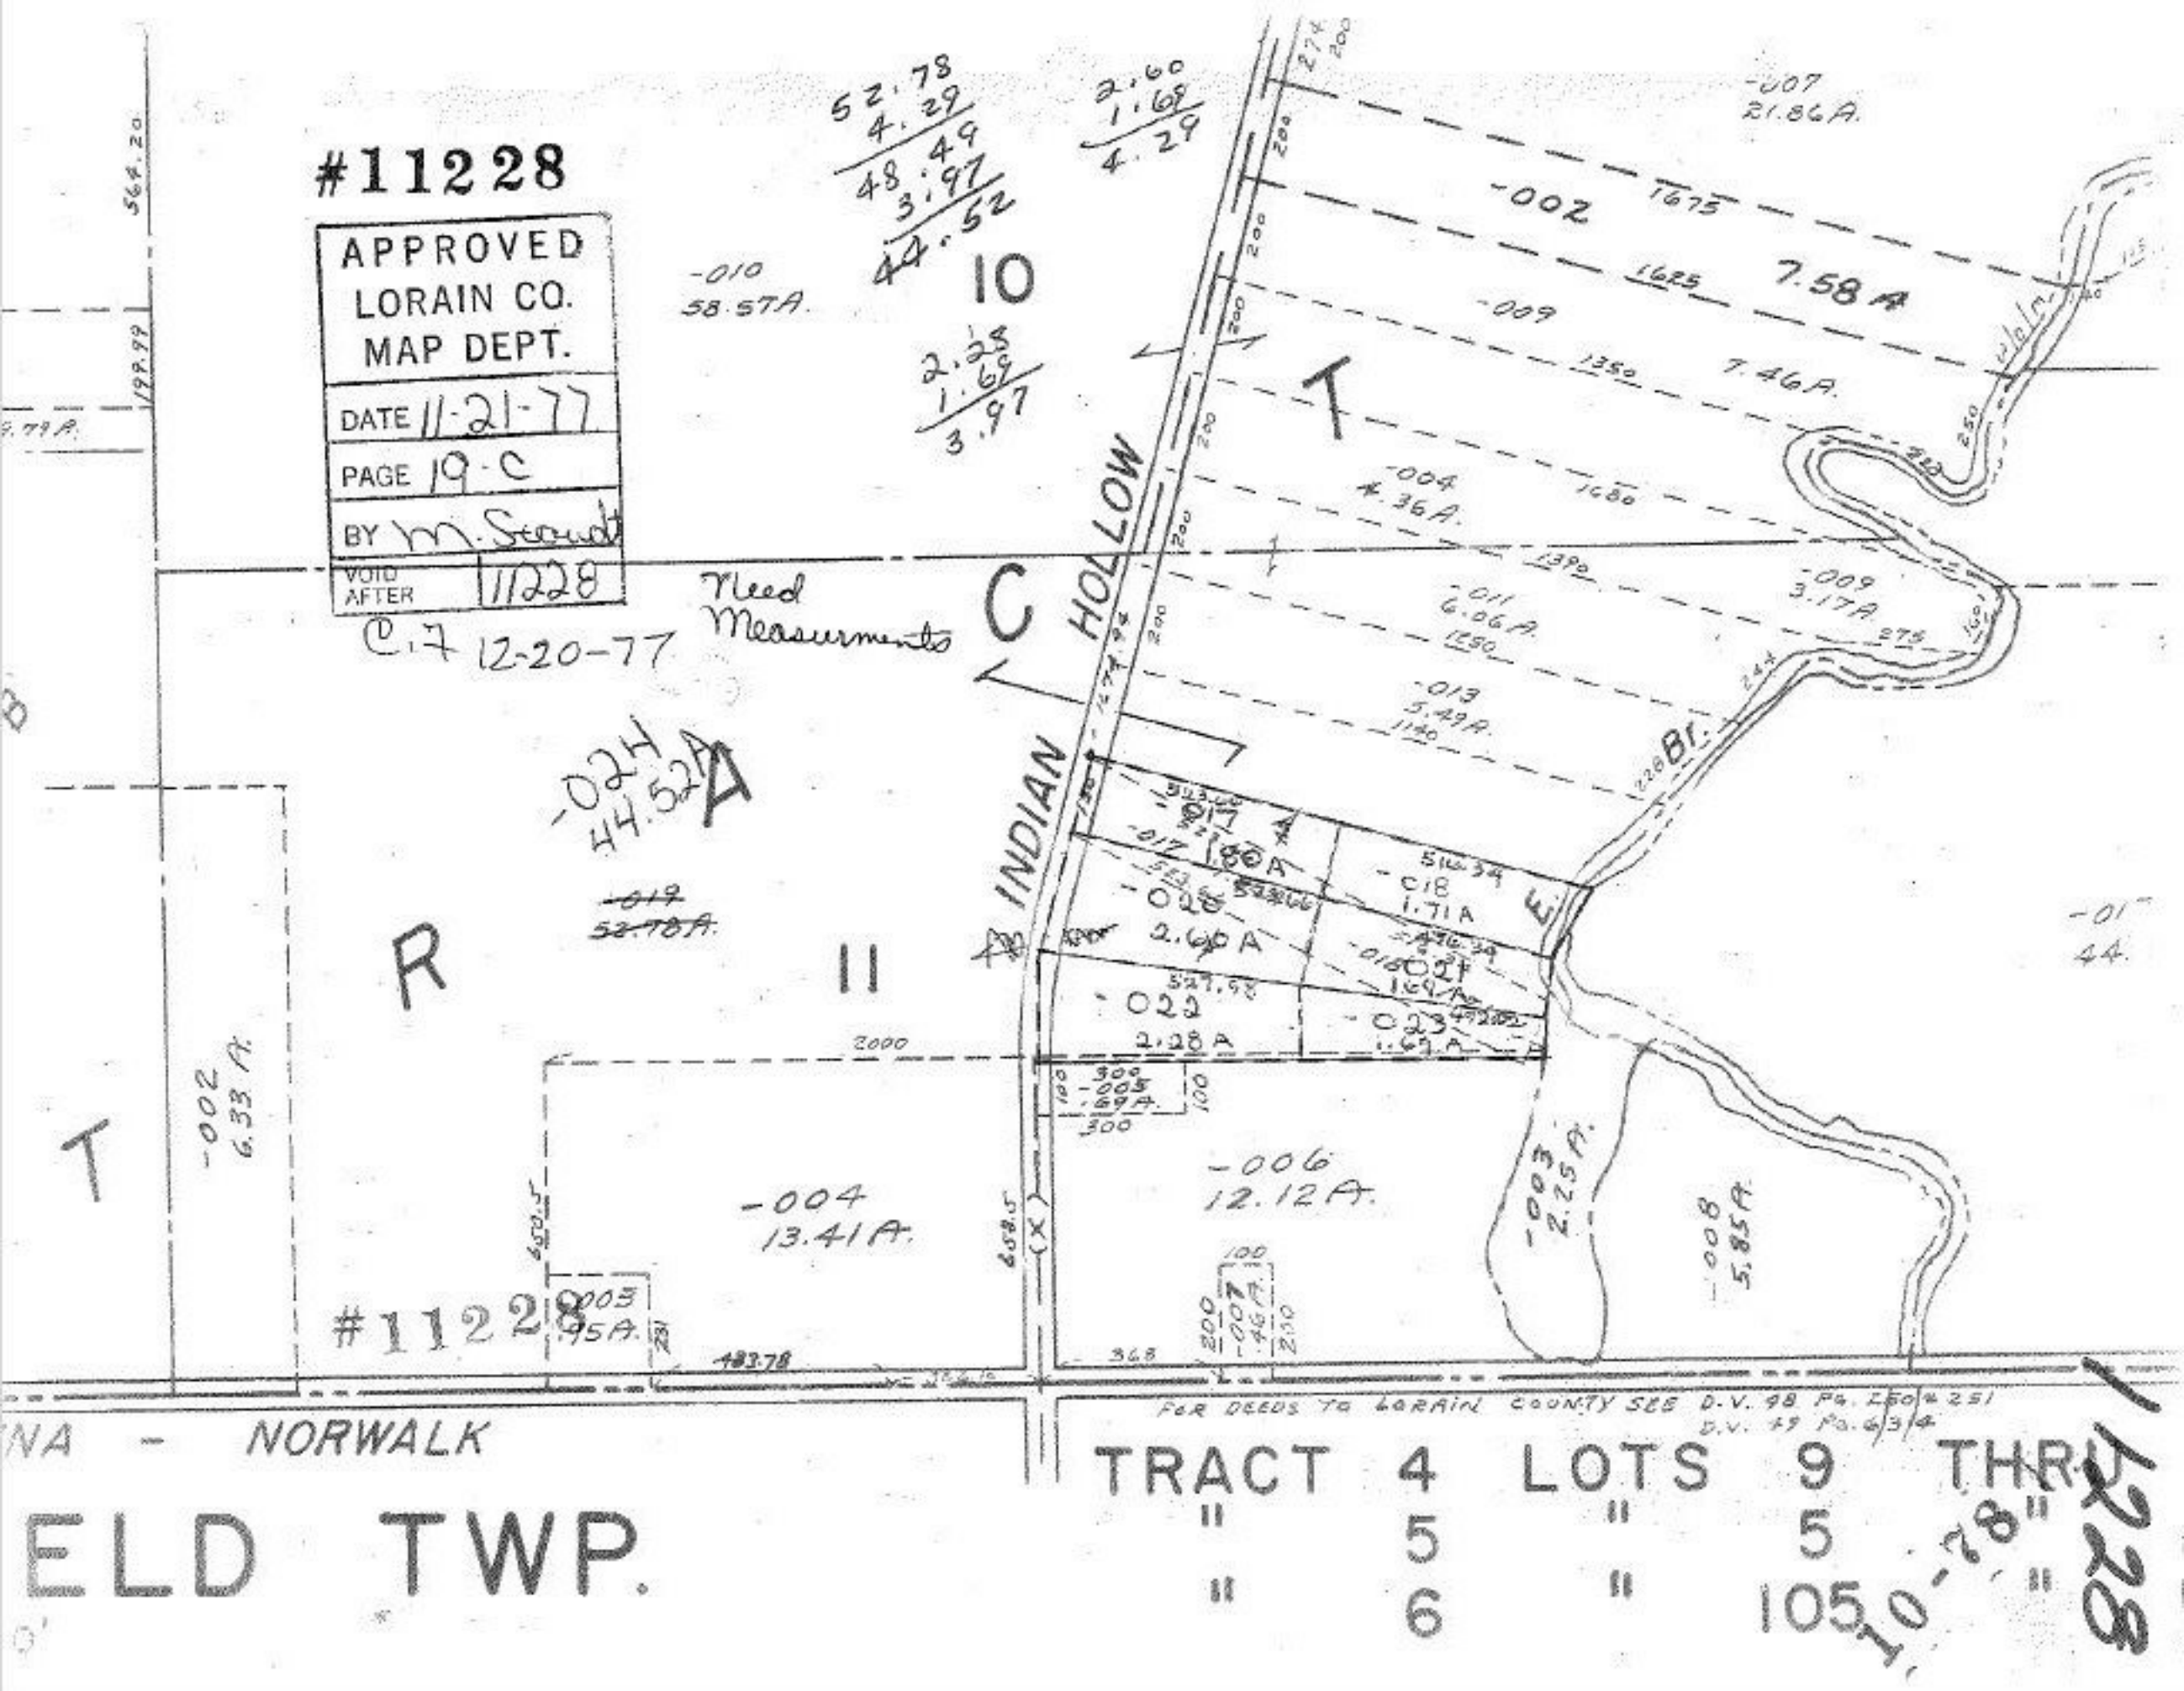
#11228
APPROVED
LORAIN CO.
MAP DEPT.
DATE 11-21-77
PAGE 19-C
BY M. Scandt
VOID AFTER 11228
C.F. 12-20-77
Need Measurments
52.78
4.29
48.49
3.97
44.52
2.60
1.69
4.29
2.28
1.69
3.97
-010
58.57A.
10
-007
21.86A.
-002
1675
1625
7.58A
-009
1350
7.46A.
-004
4.36A.
1680
1390
-011
6.06A.
1250
-009
3.17A.
-013
5.49A.
1140
INDIAN HOLLOW
T
C
A
-024
44.52A
-019
52.78A.
R
11
-002
6.33A.
-017
1.80A
-018
1.71A
-020
2.60A
-021
1.69A
-022
2.28A
-023
1.69A
-005
.69A.
-006
12.12A.
-004
13.41A.
-003
2.25A.
-008
5.85A.
-003
.95A.
-007
.46A.
#11228
2000
483.78
368
FOR DEEDS TO LORAIN COUNTY SEE D.V. 98 Pg. 250 & 251
D.V. 49 Pg. 6314
NA - NORWALK
ELD TWP.
TRACT 4 LOTS 9 THRU
" 5 " 5 "
" 6 " 105 "
10-78
11228