

DT

SEE

#11236

APPROVED
LORAIN CO.
MAP DEPT.

DATE 11-23-77

PAGE 11 B


BY *[Signature]*

VOID AFTER 11236

10-84

OBERLIN - CLEVELAND

72

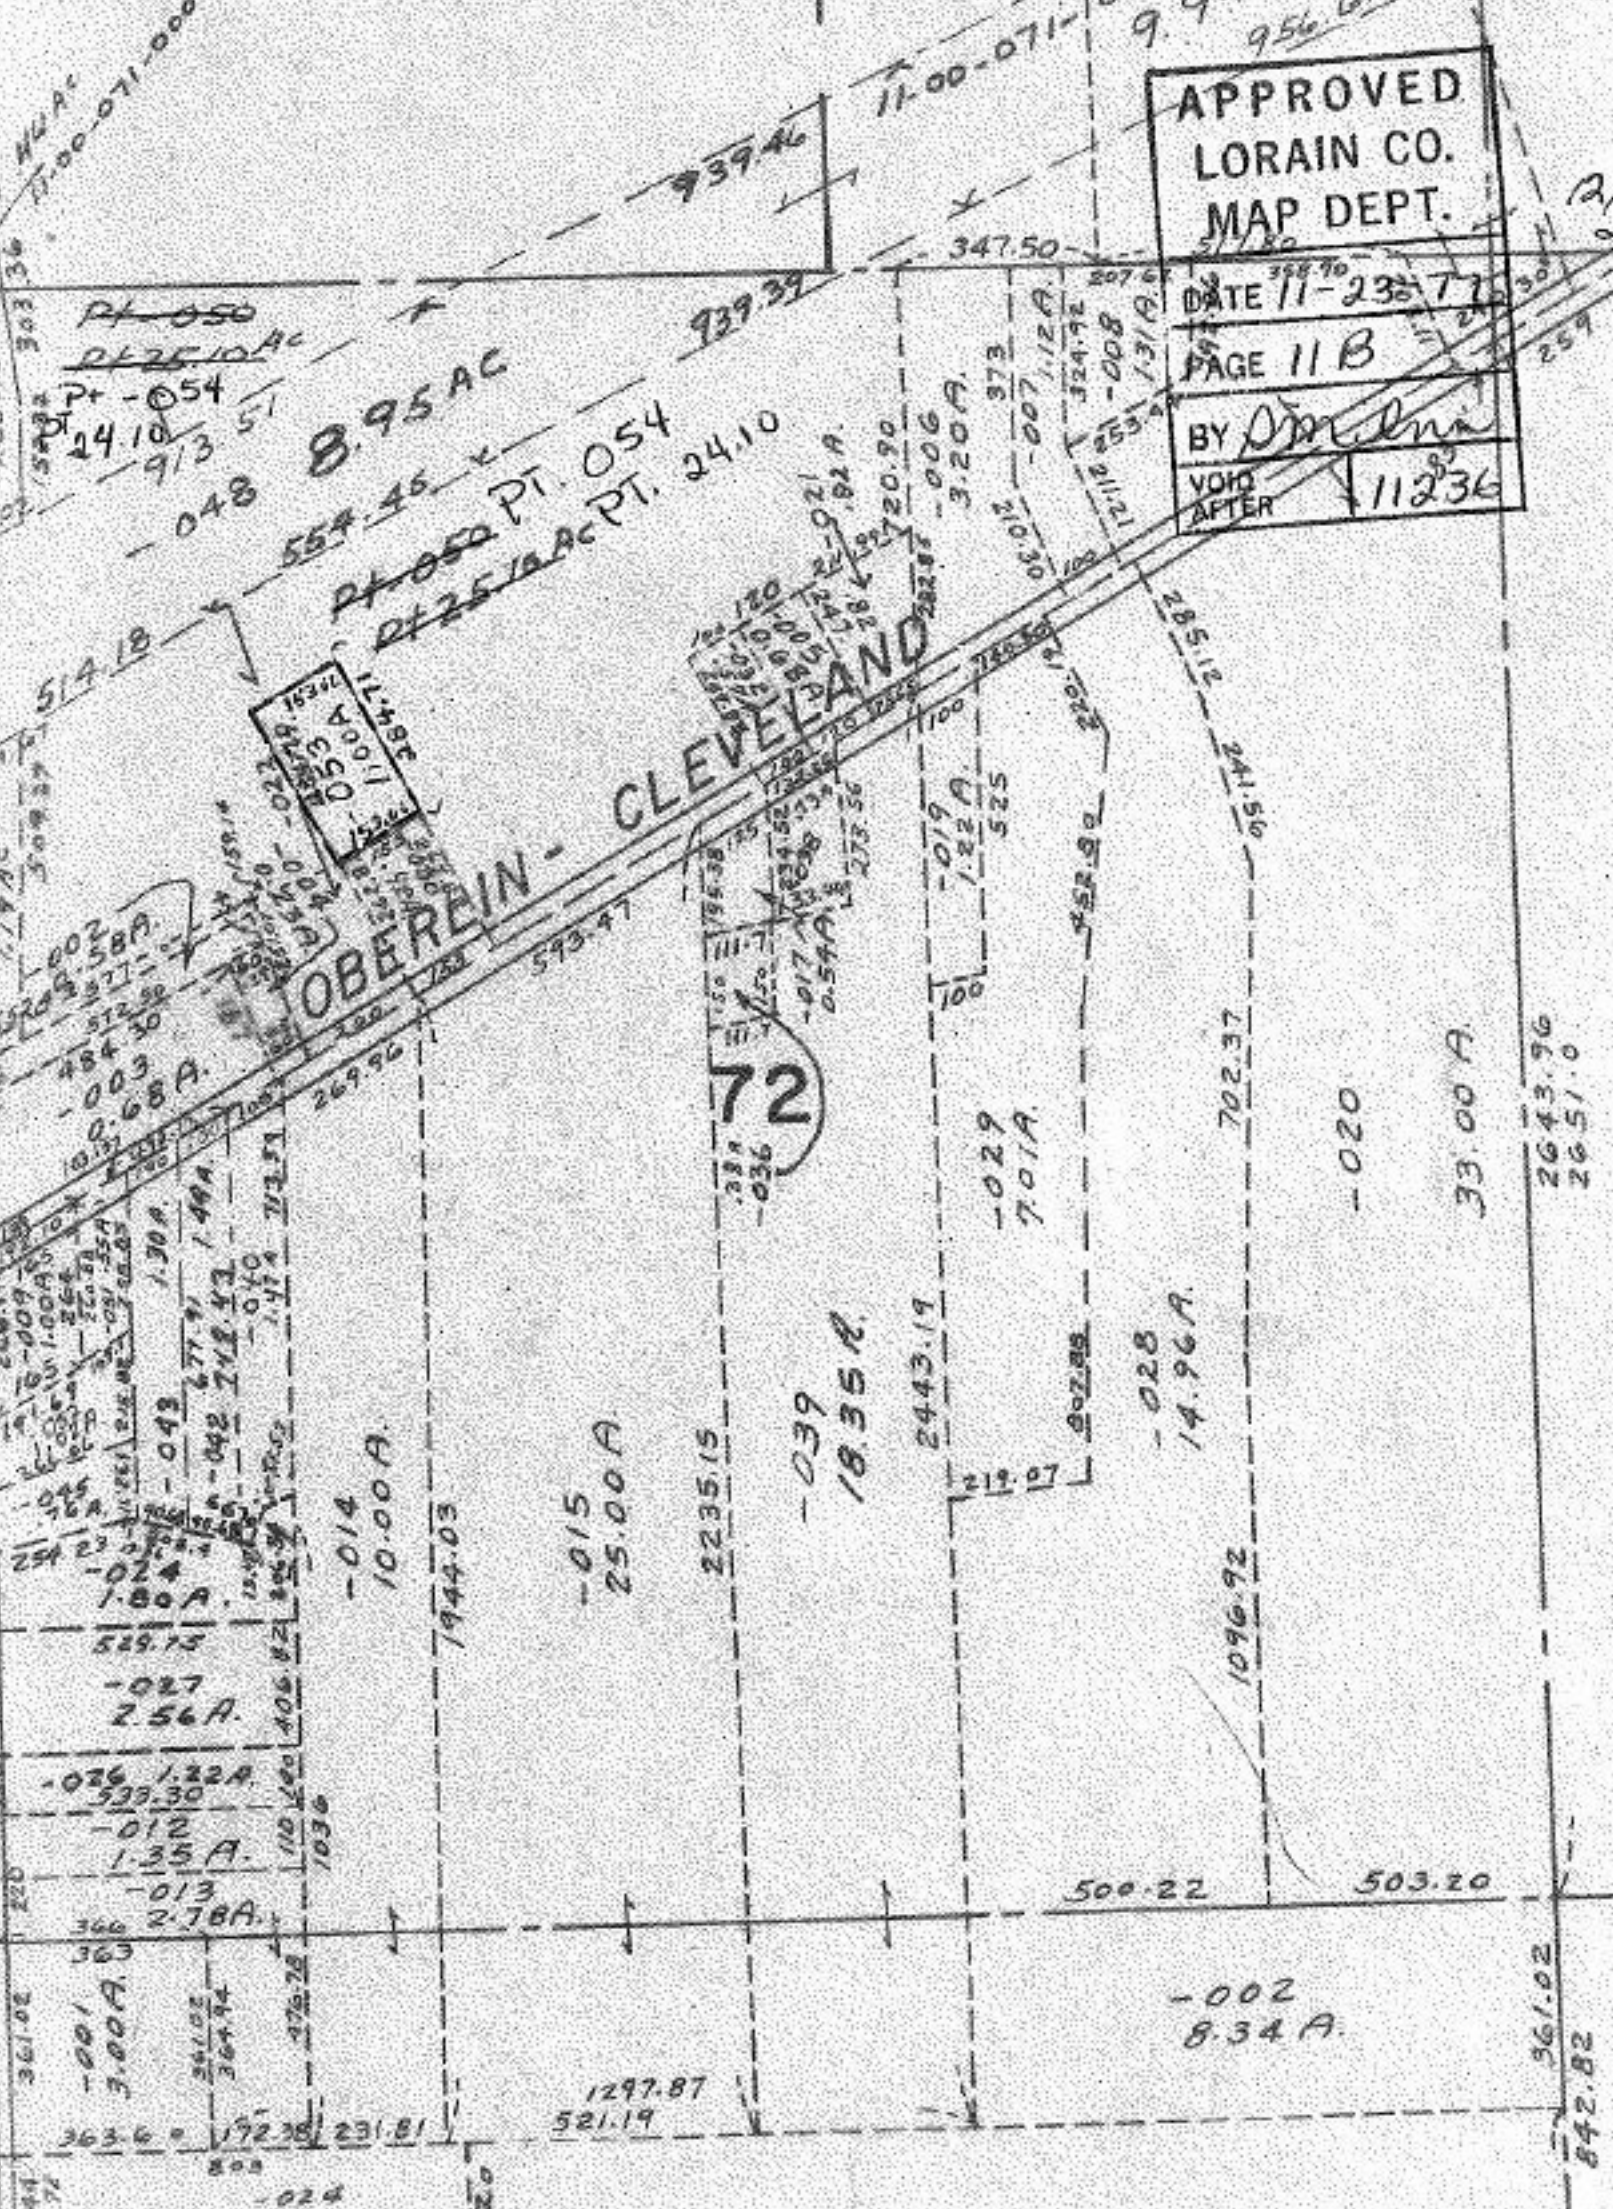

2/10/77

2643.96
2651.0

361.02
842.82

50