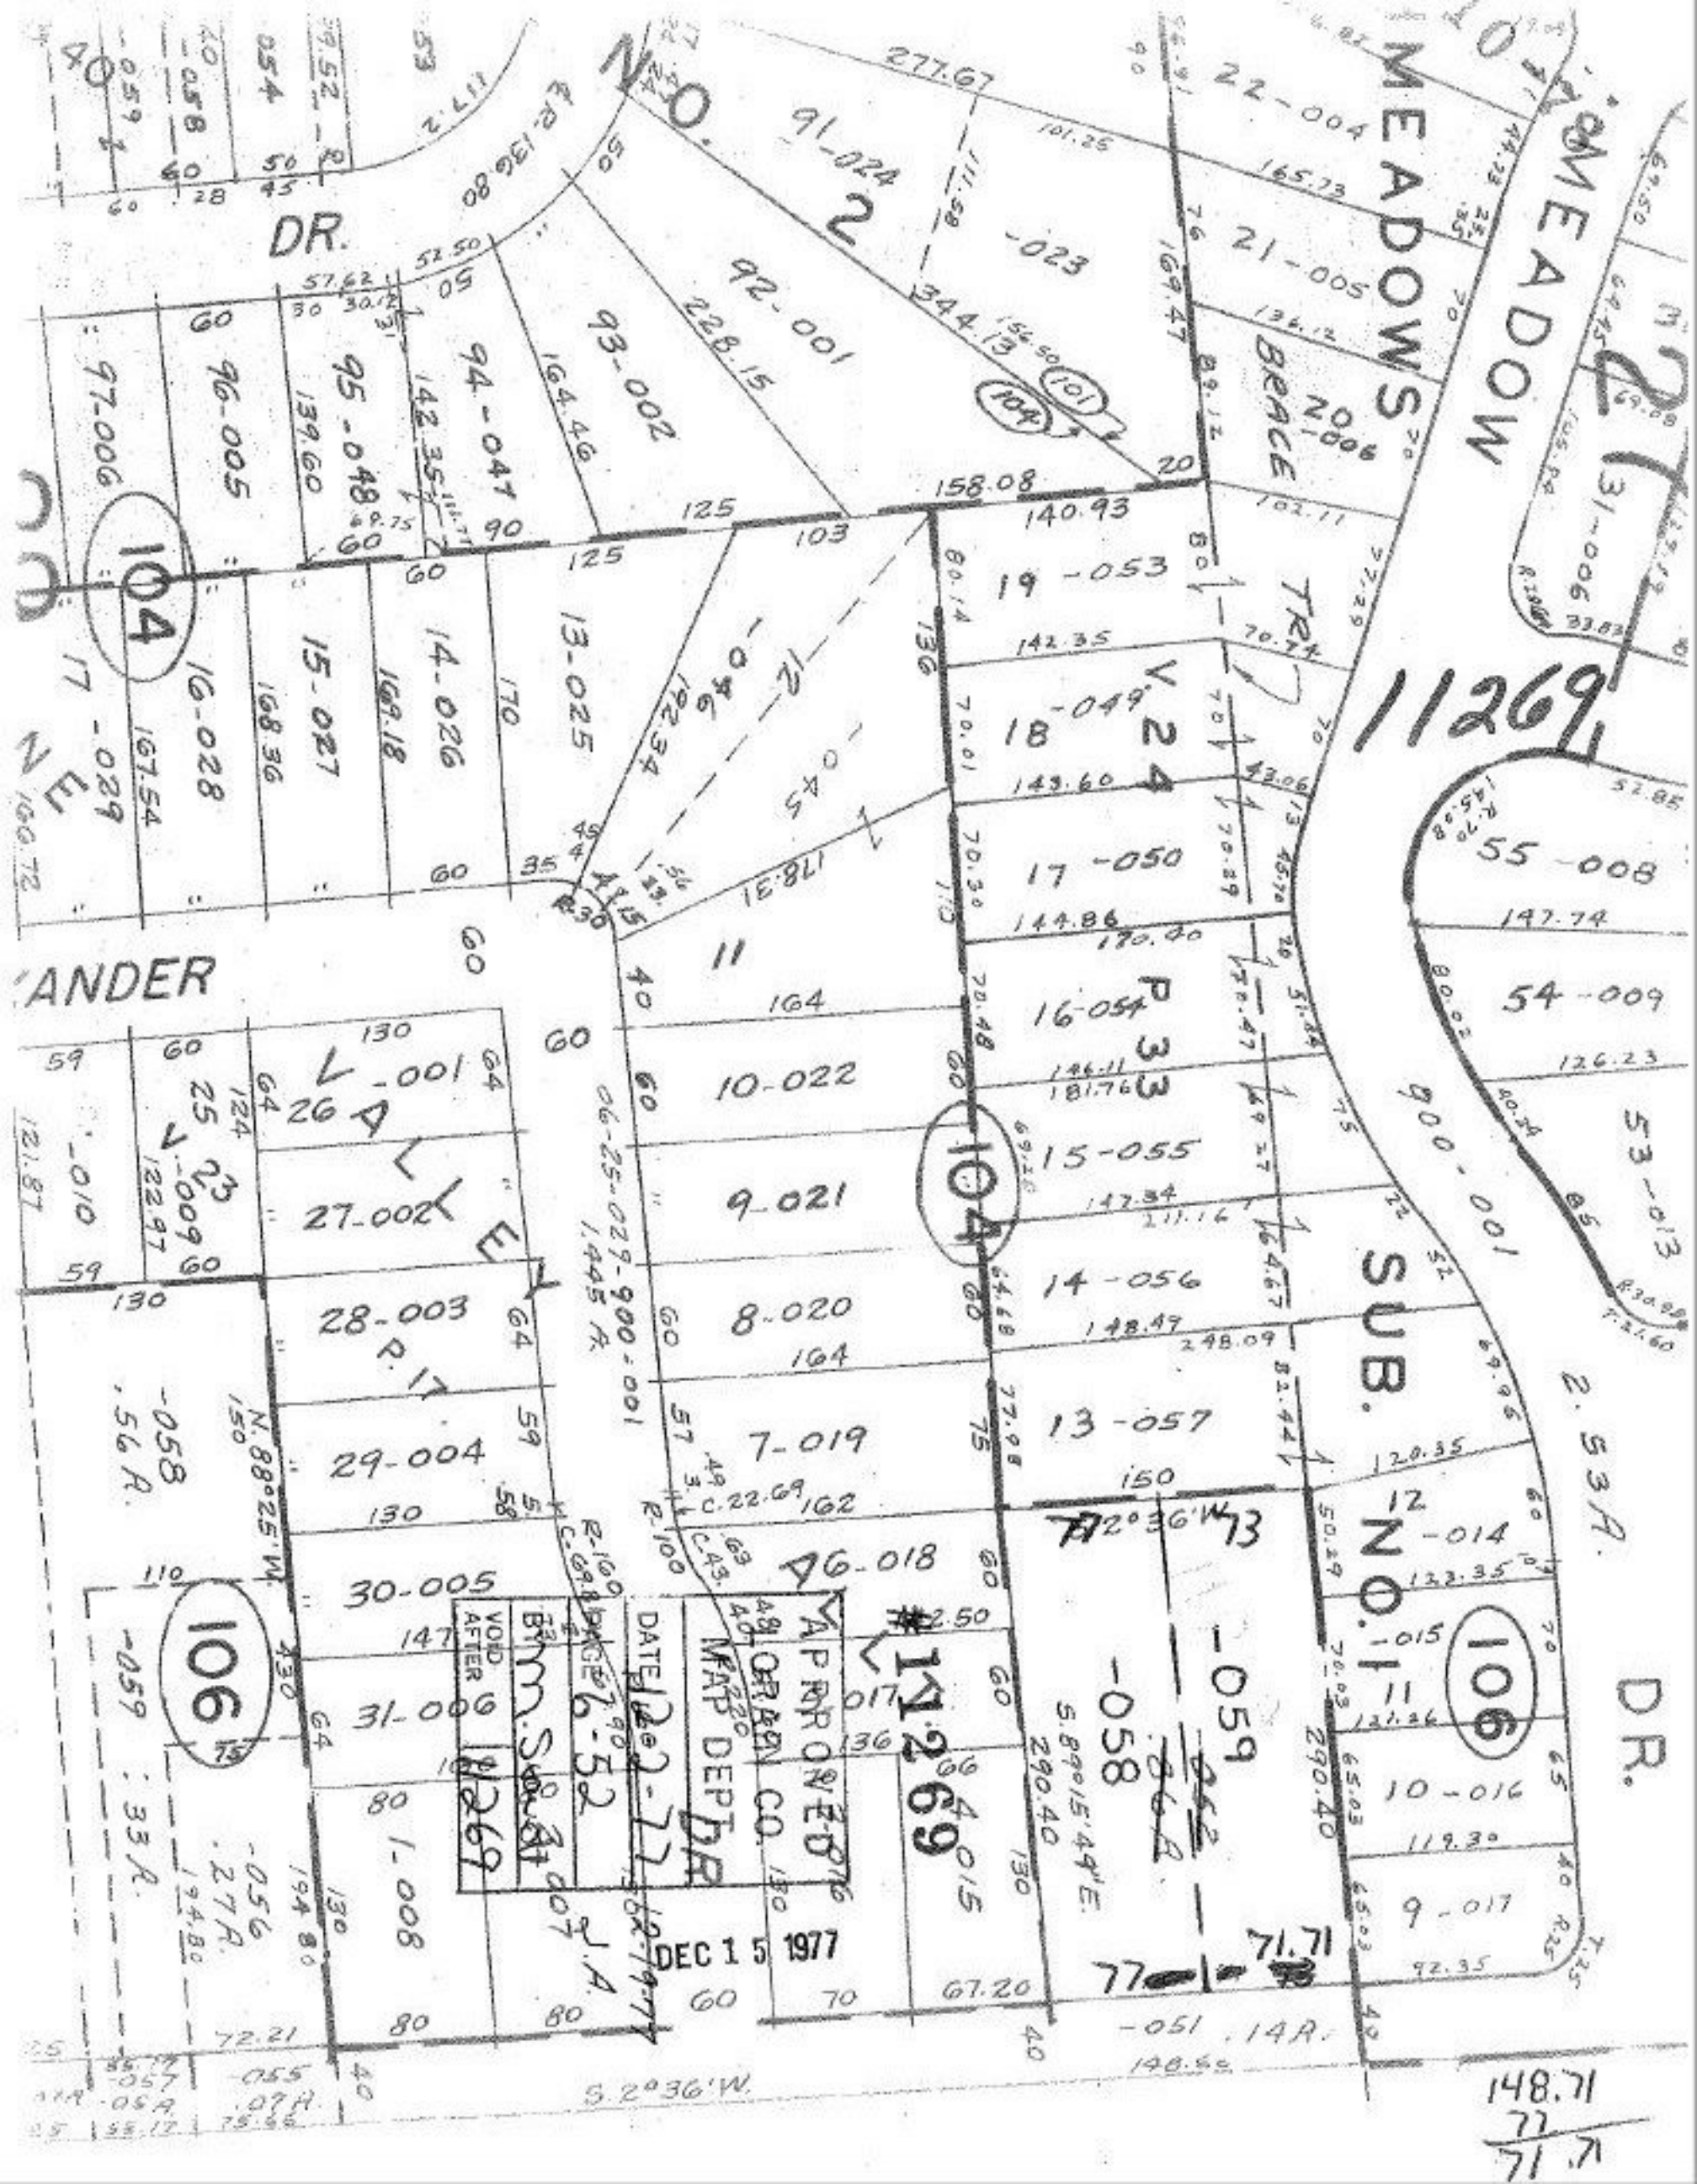

MEADOWS
MEADOW
DR.
KANDER
SUB. NO. 1
11269
APPROVED
MAP DEPT.
DATE
PAGE
BY
VOID AFTER
DEC 15 1977
S. 2°36'W.