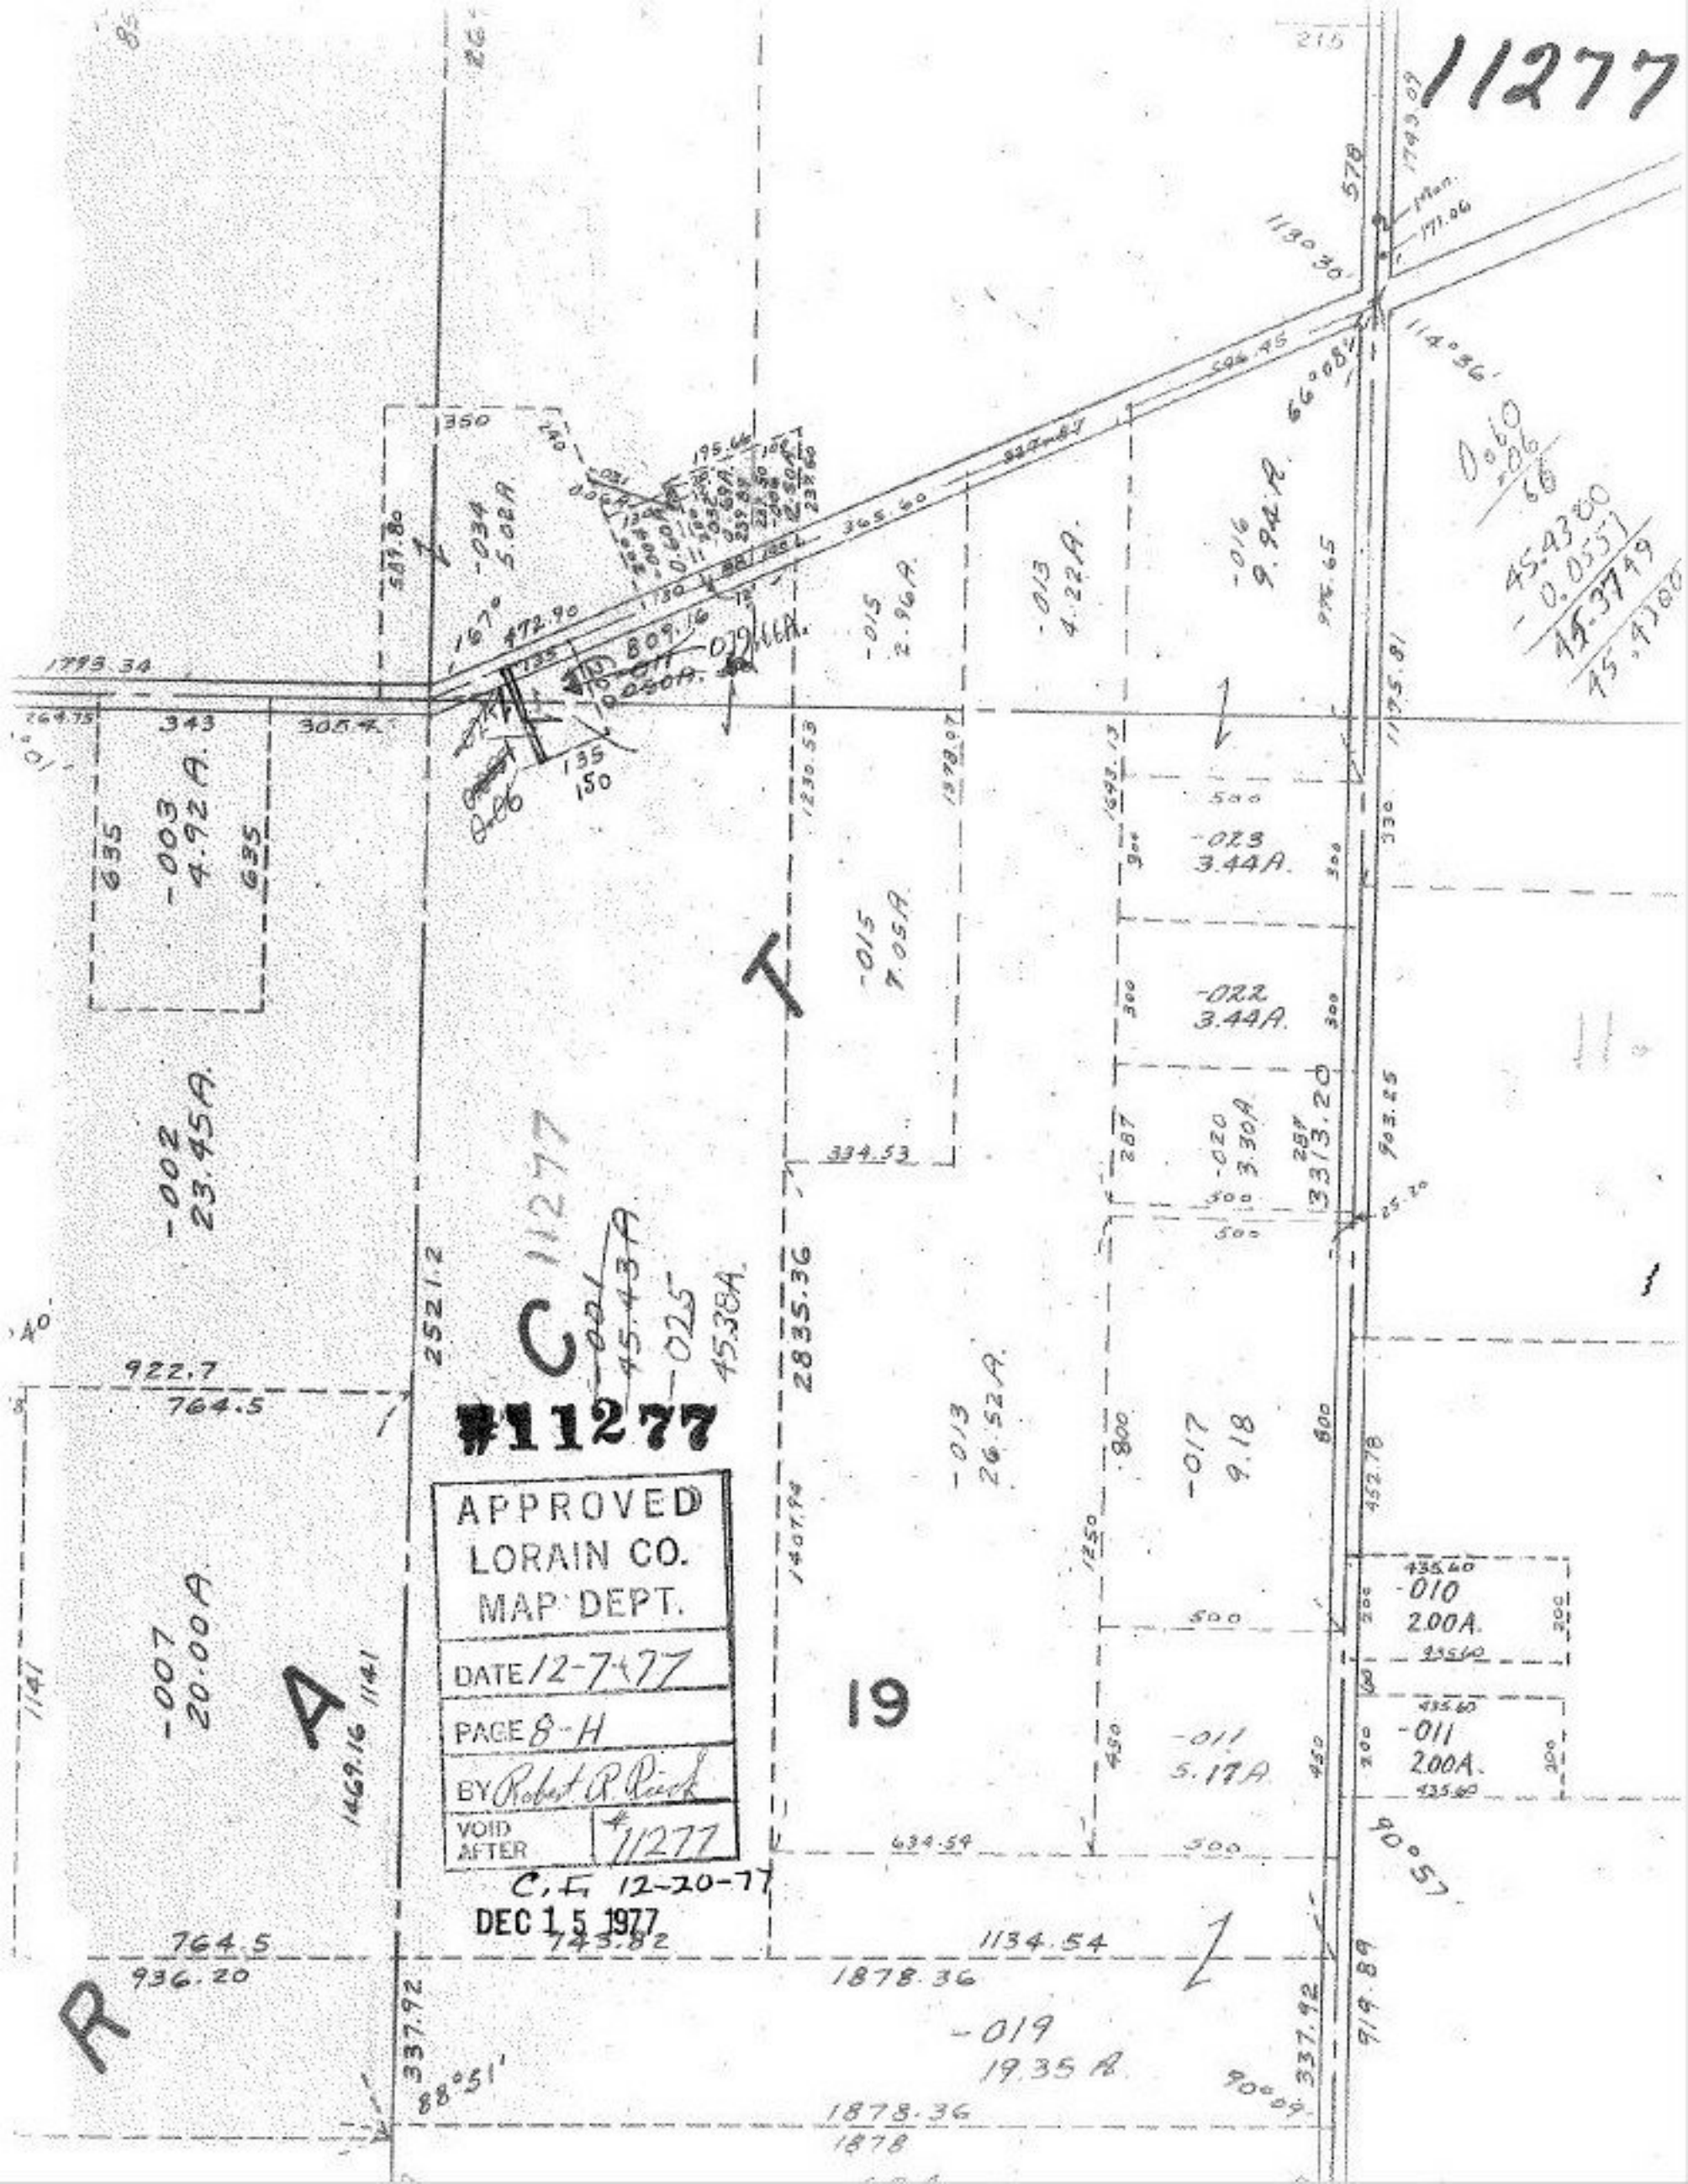
11277
#11277
APPROVED
LORAIN CO.
MAP DEPT.
DATE 12-7-77
PAGE 8-H
BY Robert R. Rick
VOID AFTER #11277
C.F. 12-20-77
DEC 15 1977
19
A
R
C
-034 5.02A
-003 4.92A
-002 23.45A
-007 20.00A
-015 2.96A
-013 4.22A
-016 9.94A
-015 7.05A
-023 3.44A
-022 3.44A
-020 3.30A
-013 26.52A
-017 9.18
-010 2.00A
-011 2.00A
-011 5.17A
-019 19.35A
-001 45.43A
-025 45.38A
1793.34
1134.54
1878.36
1878
2835.36
2521.2
3313.20
1469.16
1141
90°57'
88°51'
90°09'