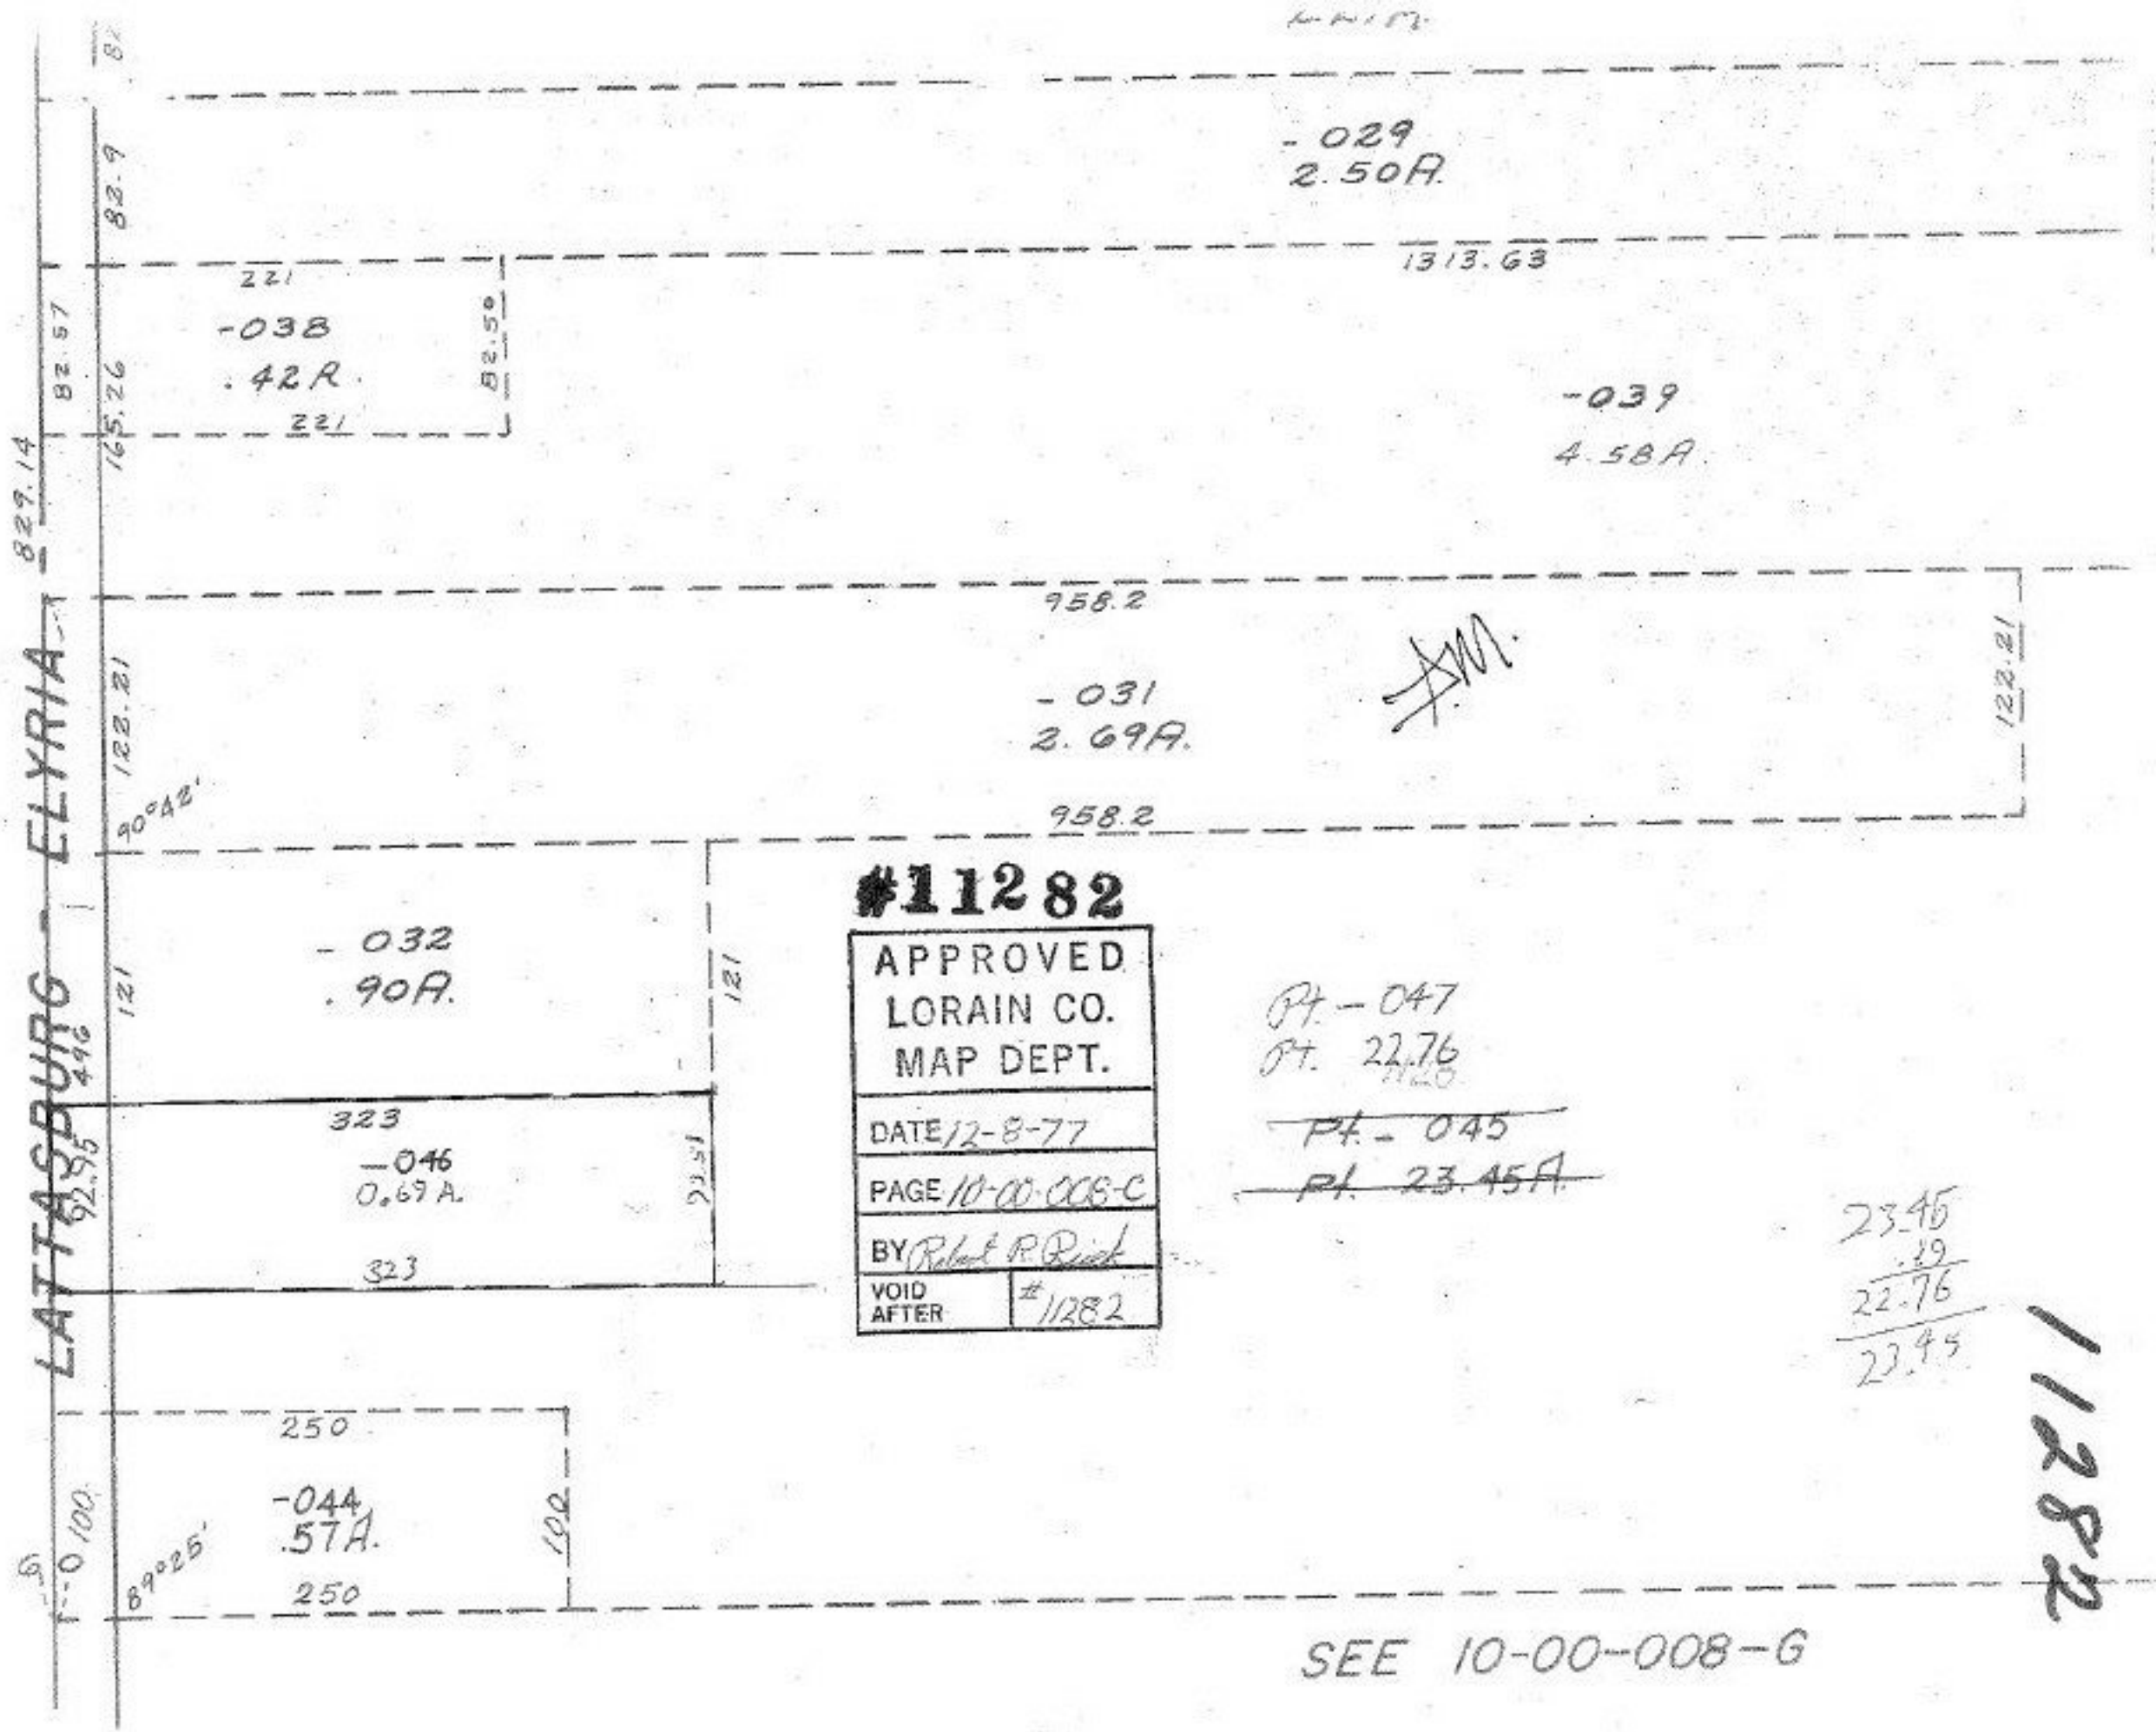

#11282

APPROVED
LORAIN CO.
MAP DEPT.

DATE 12-8-77

PAGE 10-00-008-C

BY Robert R. Rick

VOID AFTER #11282

Pt. -047
Pt. 22.76

~~Pt. -045~~
~~Pt. 23.45A.~~

23.45
.29
22.76
23.45

11282