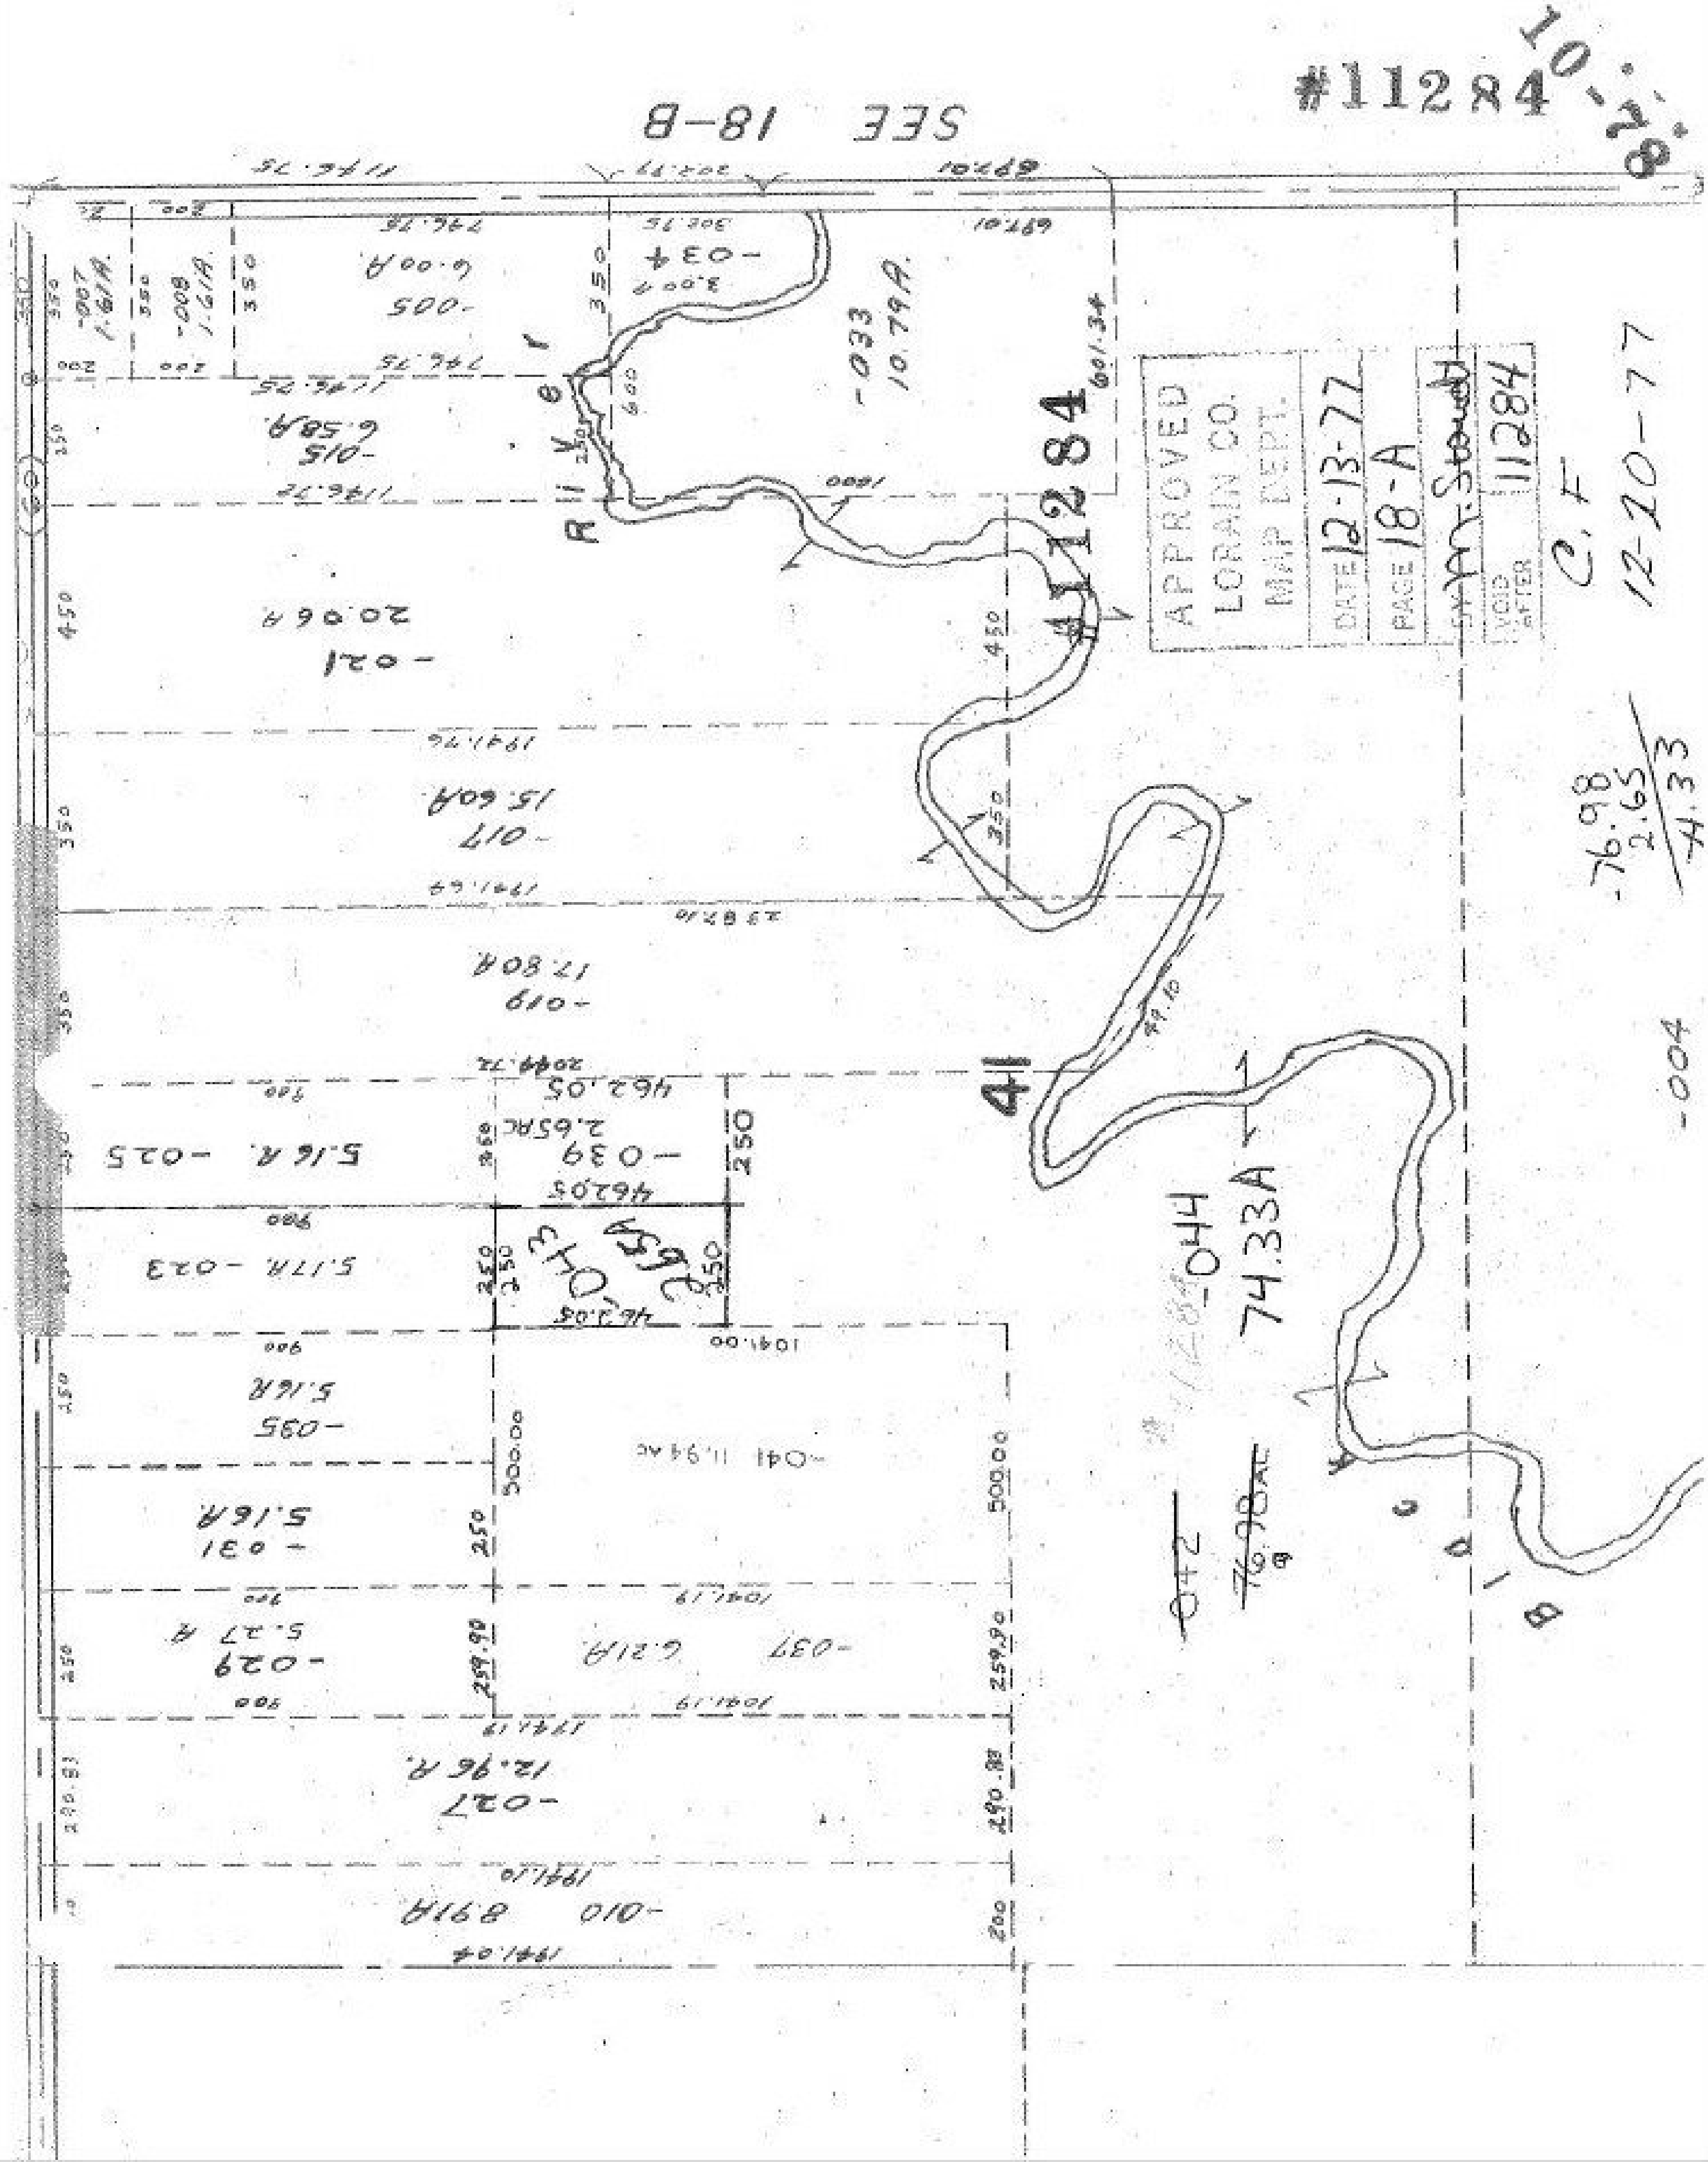
SEE 18-B
#11284
10-78
APPROVED LORAIN CO. MAP DEPT.
DATE 12-13-77
PAGE 18-A
11284
C.F.
12-20-77
41 11284
-007 1.61A.
-008 1.61A.
-005 6.00A.
-034 3.00A
-033 10.79A.
-015 6.58A.
-021 20.06A
-017 15.60A
-019 17.80A
-039 2.65AC
-025 5.16A.
-023 5.17A.
-043 2.65A
-035 5.16A
-041 11.94AC
-031 5.16A
-029 5.27A
-037 6.21A
-027 12.96A.
-010 8.91A
-044 74.33A
-042 76.98AC
-004
76.98
2.65
74.33
41
RIVER