11288
10-78

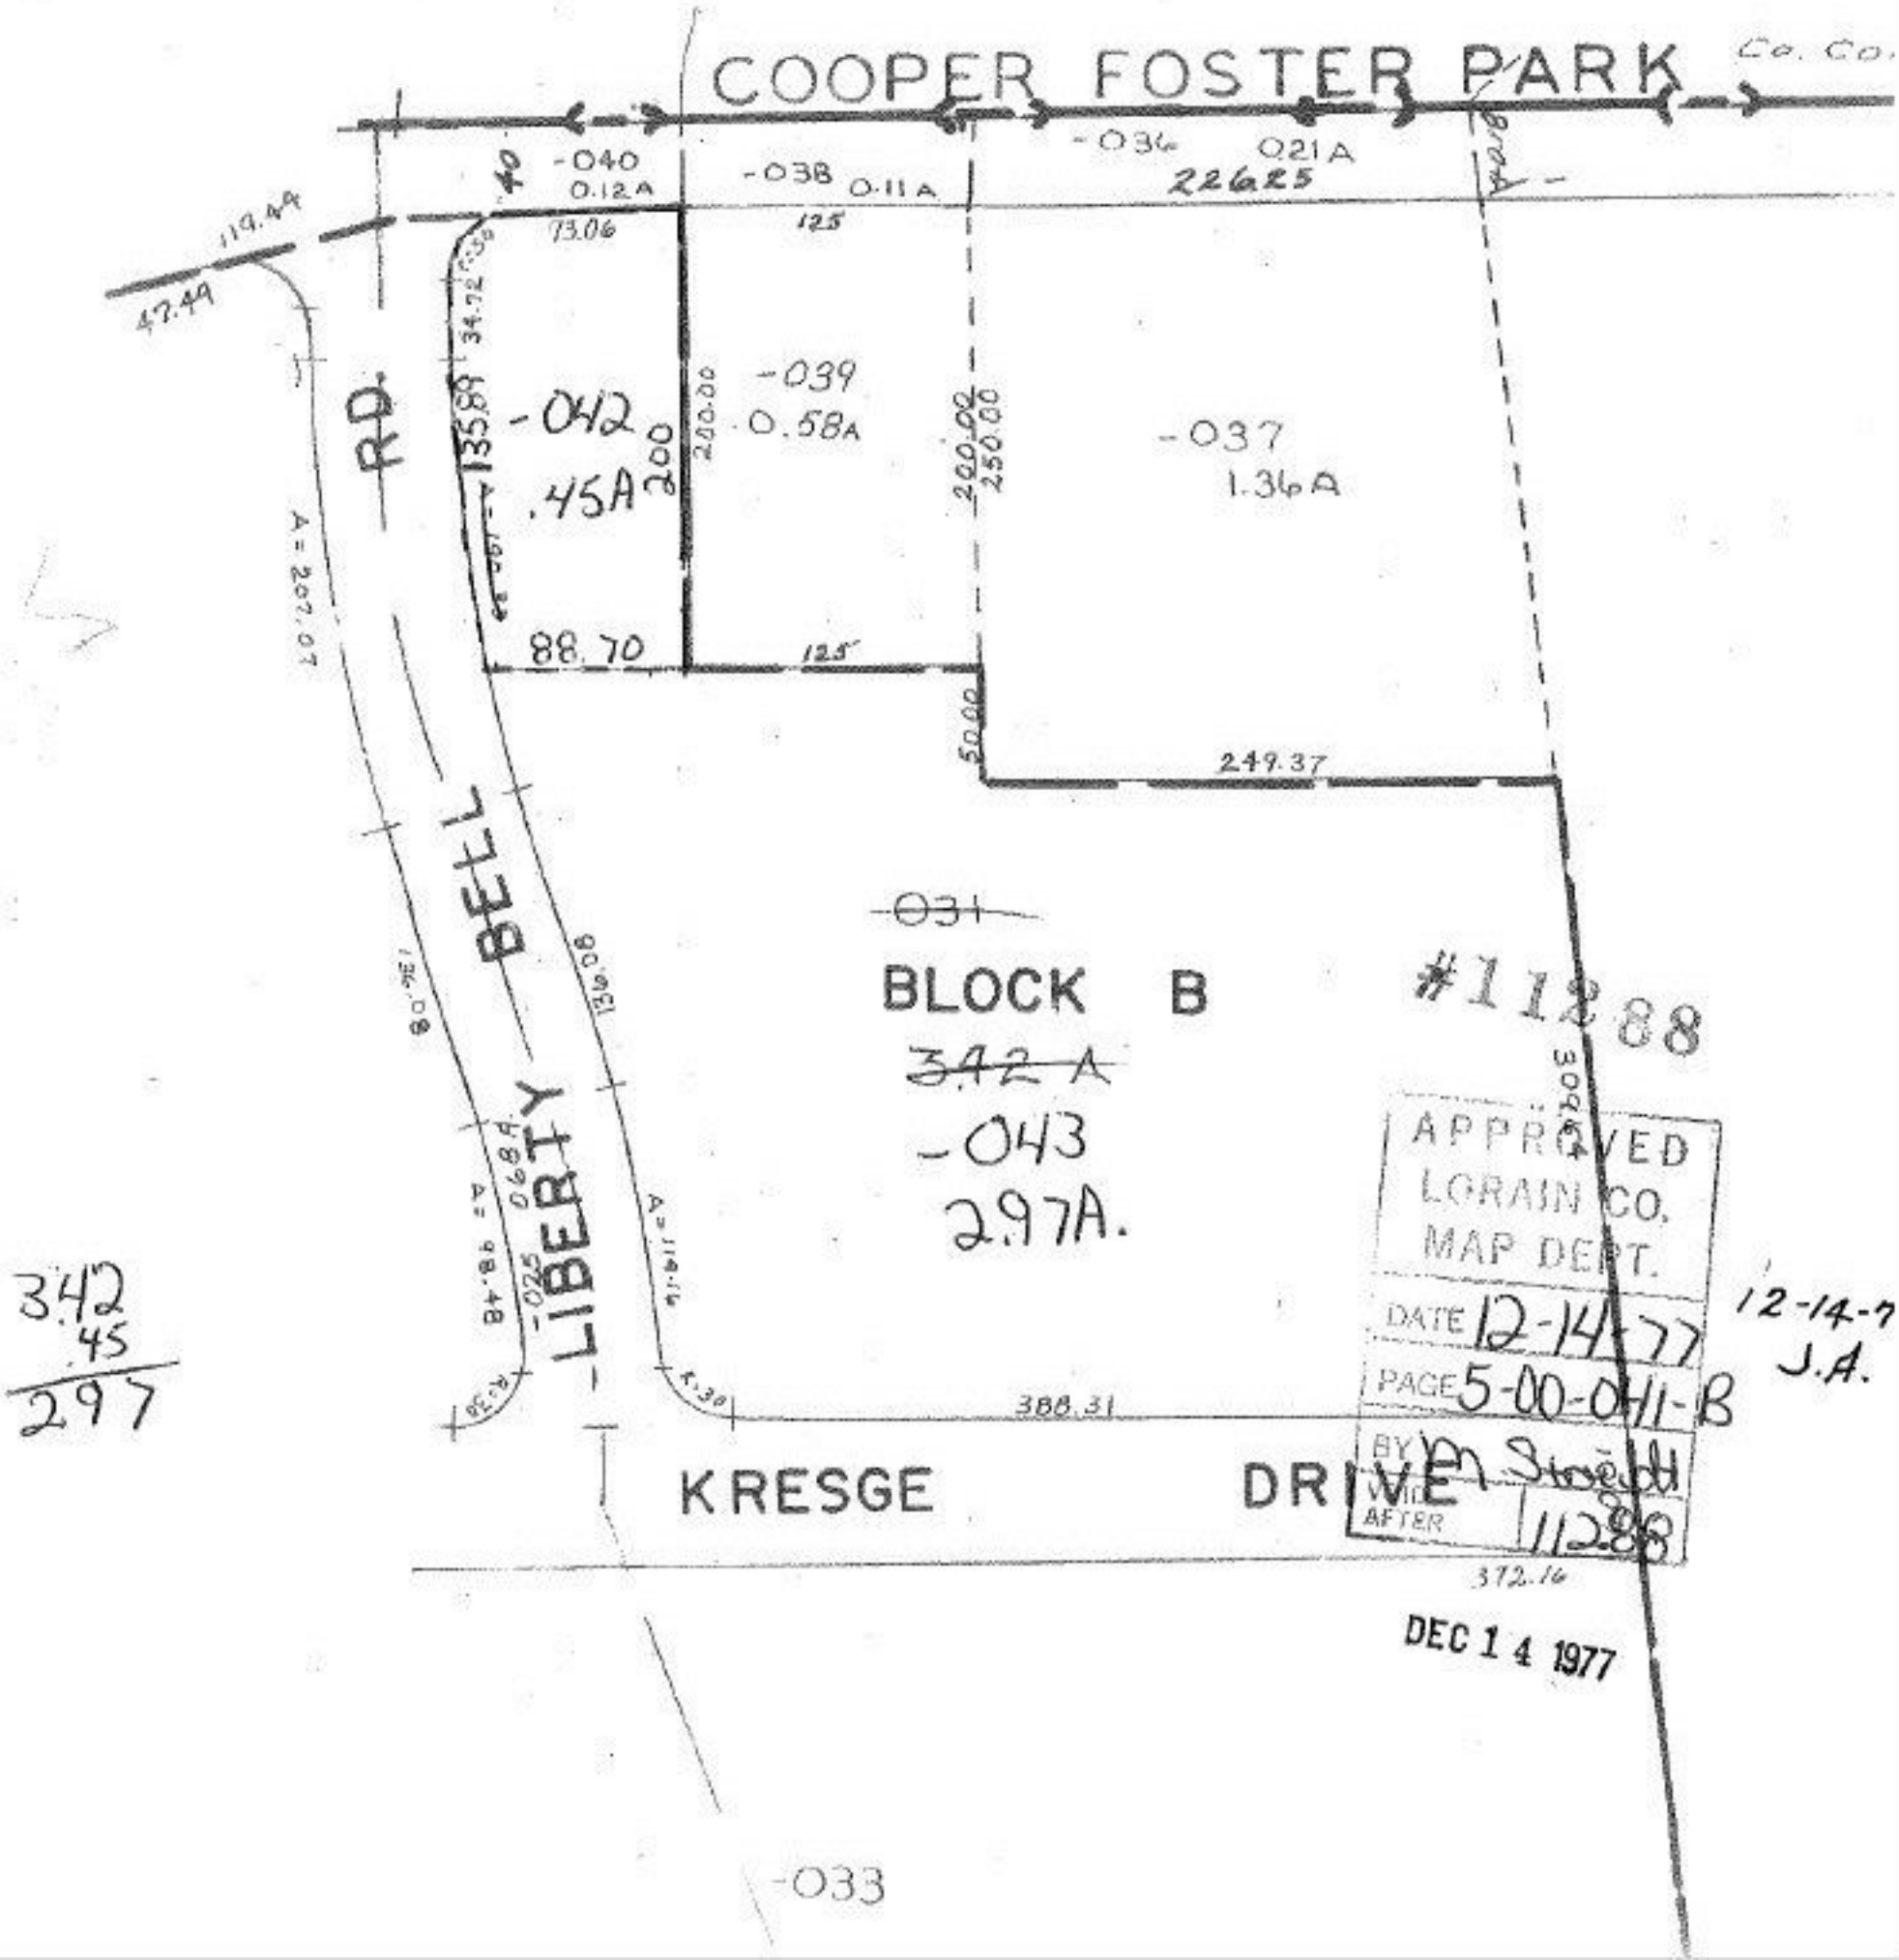

APPROVED
LORAIN CO.
MAP DEPT.
DATE 12-14-77
PAGE 5-00-041-B
BY M Stoeldt
VOID AFTER 11288

12-14-7
J.A.

DEC 14 1977

3.42
.45
2.97

-033