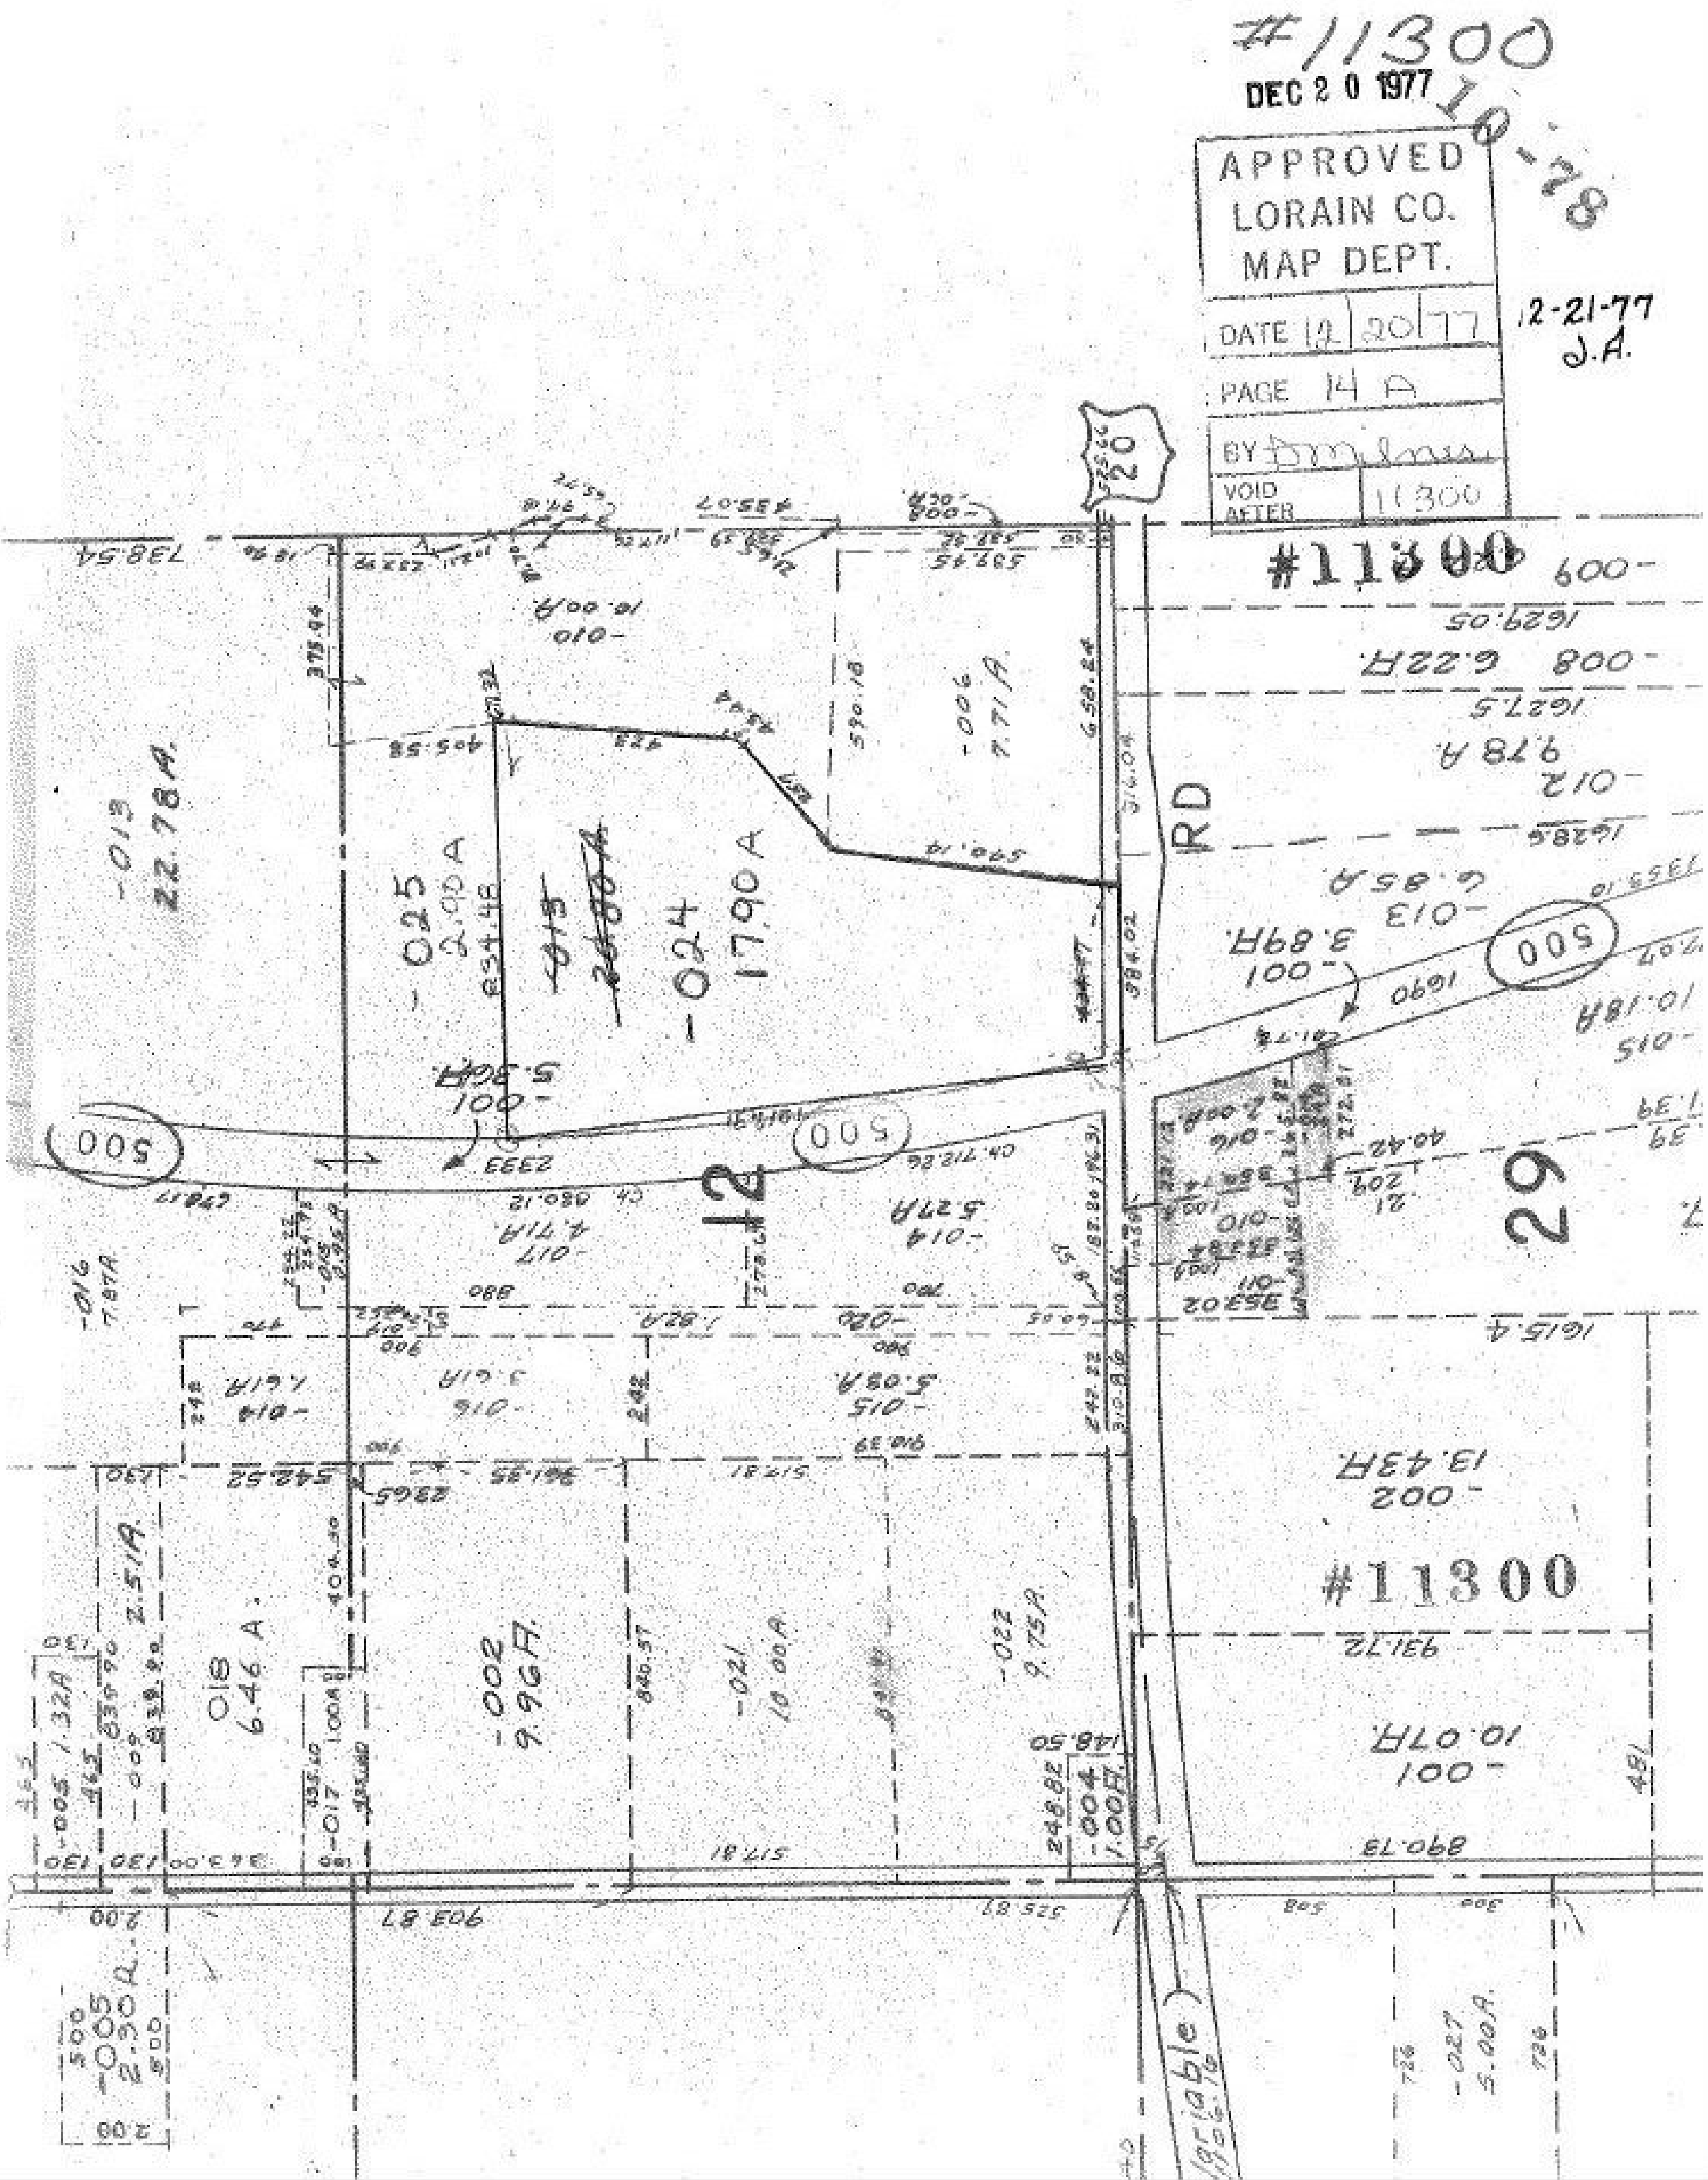
#11300
DEC 20 1977
10-78
APPROVED
LORAIN CO.
MAP DEPT.
DATE 12 20 77
PAGE 14 A
VOID AFTER
11300
12-21-77
J.A.
#11300
20
RD
500
12
29
-025 2.05 A
-024 17.90 A
-013 22.78 A
-006 7.71 A
-010 10.00 A
600-
-008 6.22 A
-012 9.78 A
-013 6.85 A
100- 3.89 A
-015 10.18 A
100- 5.36 A
-017 4.71 A
-014 5.27 A
-018 6.46 A
-002 9.96 A
-021 10.00 A
-022 9.75 A
-004 1.00 A
-017 1.00 A
-005 1.32 A
-009 2.51 A
-005 2.30 A
-016 7.87 A
200- 13.43 A
#11300
100- 10.07 A
-027 5.00 A