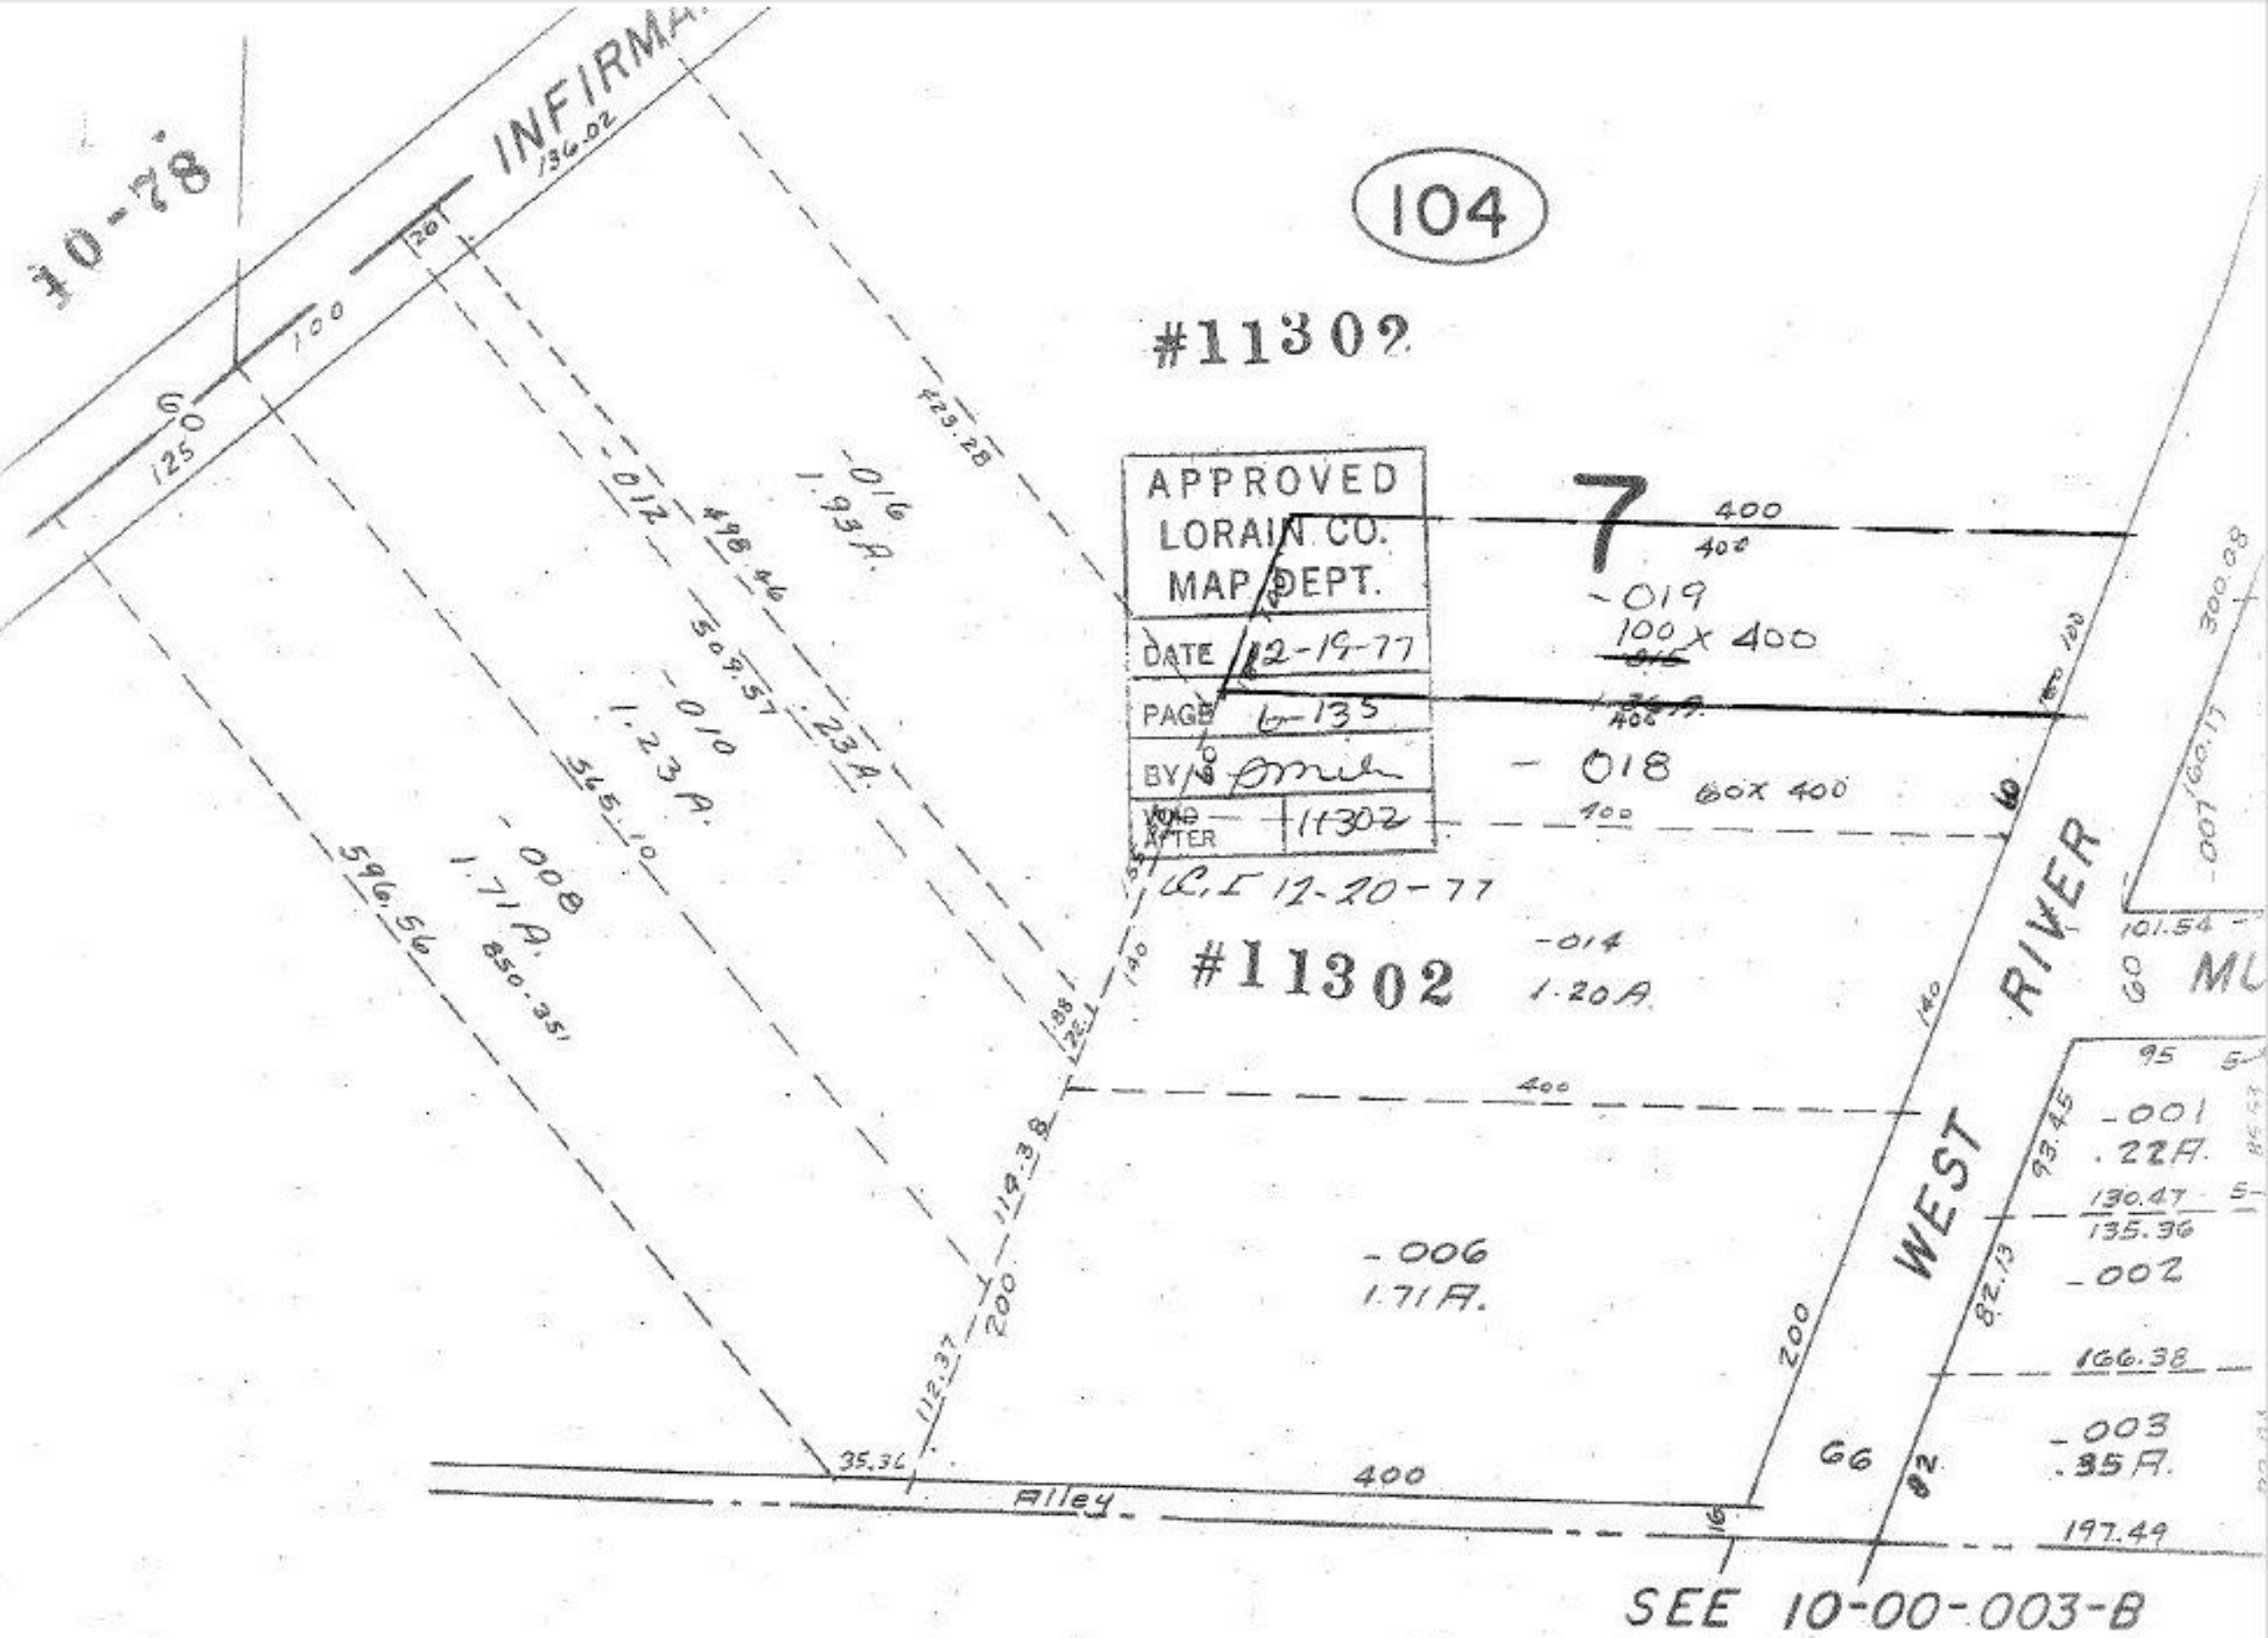

104
#11302
APPROVED
LORAIN CO.
MAP DEPT.
DATE 12-19-77
PAGE 6-135
BY
VOID AFTER 11302
C.I 12-20-77
#11302
INFIRMA
10-78
7
-019
100 x 400
-018
60 x 400
-014
1.20A.
-016
1.93A.
-012
-010
1.23A.
-008
1.71A.
-006
1.71A.
-001
.22A.
-002
-003
.35A.
WEST RIVER
Alley
SEE 10-00-003-B